

WW-7
8-30-06



West Virginia Department of Environmental Protection
Office of Oil and Gas

WELL LOCATION FORM: GPS

API: 47-033-00478 WELL NO.: 3493
FARM NAME: A.T Cropp
RESPONSIBLE PARTY NAME: Dominion Energy Transmission, Inc.
COUNTY: Harrison DISTRICT: Simpson
QUADRANGLE: Rosemont
SURFACE OWNER: Charles Pointe Crossing LLC
ROYALTY OWNER: Ronald L. Cropp, et. al.
UTM GPS NORTHING: 4352619
UTM GPS EASTING: 565982 GPS ELEVATION: 395 ^(1296')

The Responsible Party named above has chosen to submit GPS coordinates in lieu of preparing a new well location plat for a plugging permit or assigned API number on the above well. The Office of Oil and Gas will not accept GPS coordinates that do not meet the following requirements:

- 1. Datum: NAD 1983, Zone: 17 North, Coordinate Units: meters, Altitude: height above mean sea level (MSL) – meters.
- 2. Accuracy to Datum – 3.05 meters
- 3. Data Collection Method:

Survey grade GPS : Post Processed Differential _____
Real-Time Differential

Mapping Grade GPS _____ : Post Processed Differential _____
Real-Time Differential _____

- 4. Letter size copy of the topography map showing the well location.

I the undersigned, hereby certify this data is correct to the best of my knowledge and belief and shows all the information required by law and the regulations issued and prescribed by the Office of Oil and Gas.

[Signature]
Signature

Project Manager
Title


09/17/20
Date

RECEIVED
Office of Oil and Gas
SEP 01 2020
WV Department of
Environmental Protection




CIVIL & ENVIRONMENTAL CONSULTANTS, INC.
 600 MARKETPLACE AVENUE, SUITE 200
 BRIDGEPORT, WV 26330
 304-933-3119

GRID NORTH
 UTM, NAD83 DATUM, ZONE 17, US FT

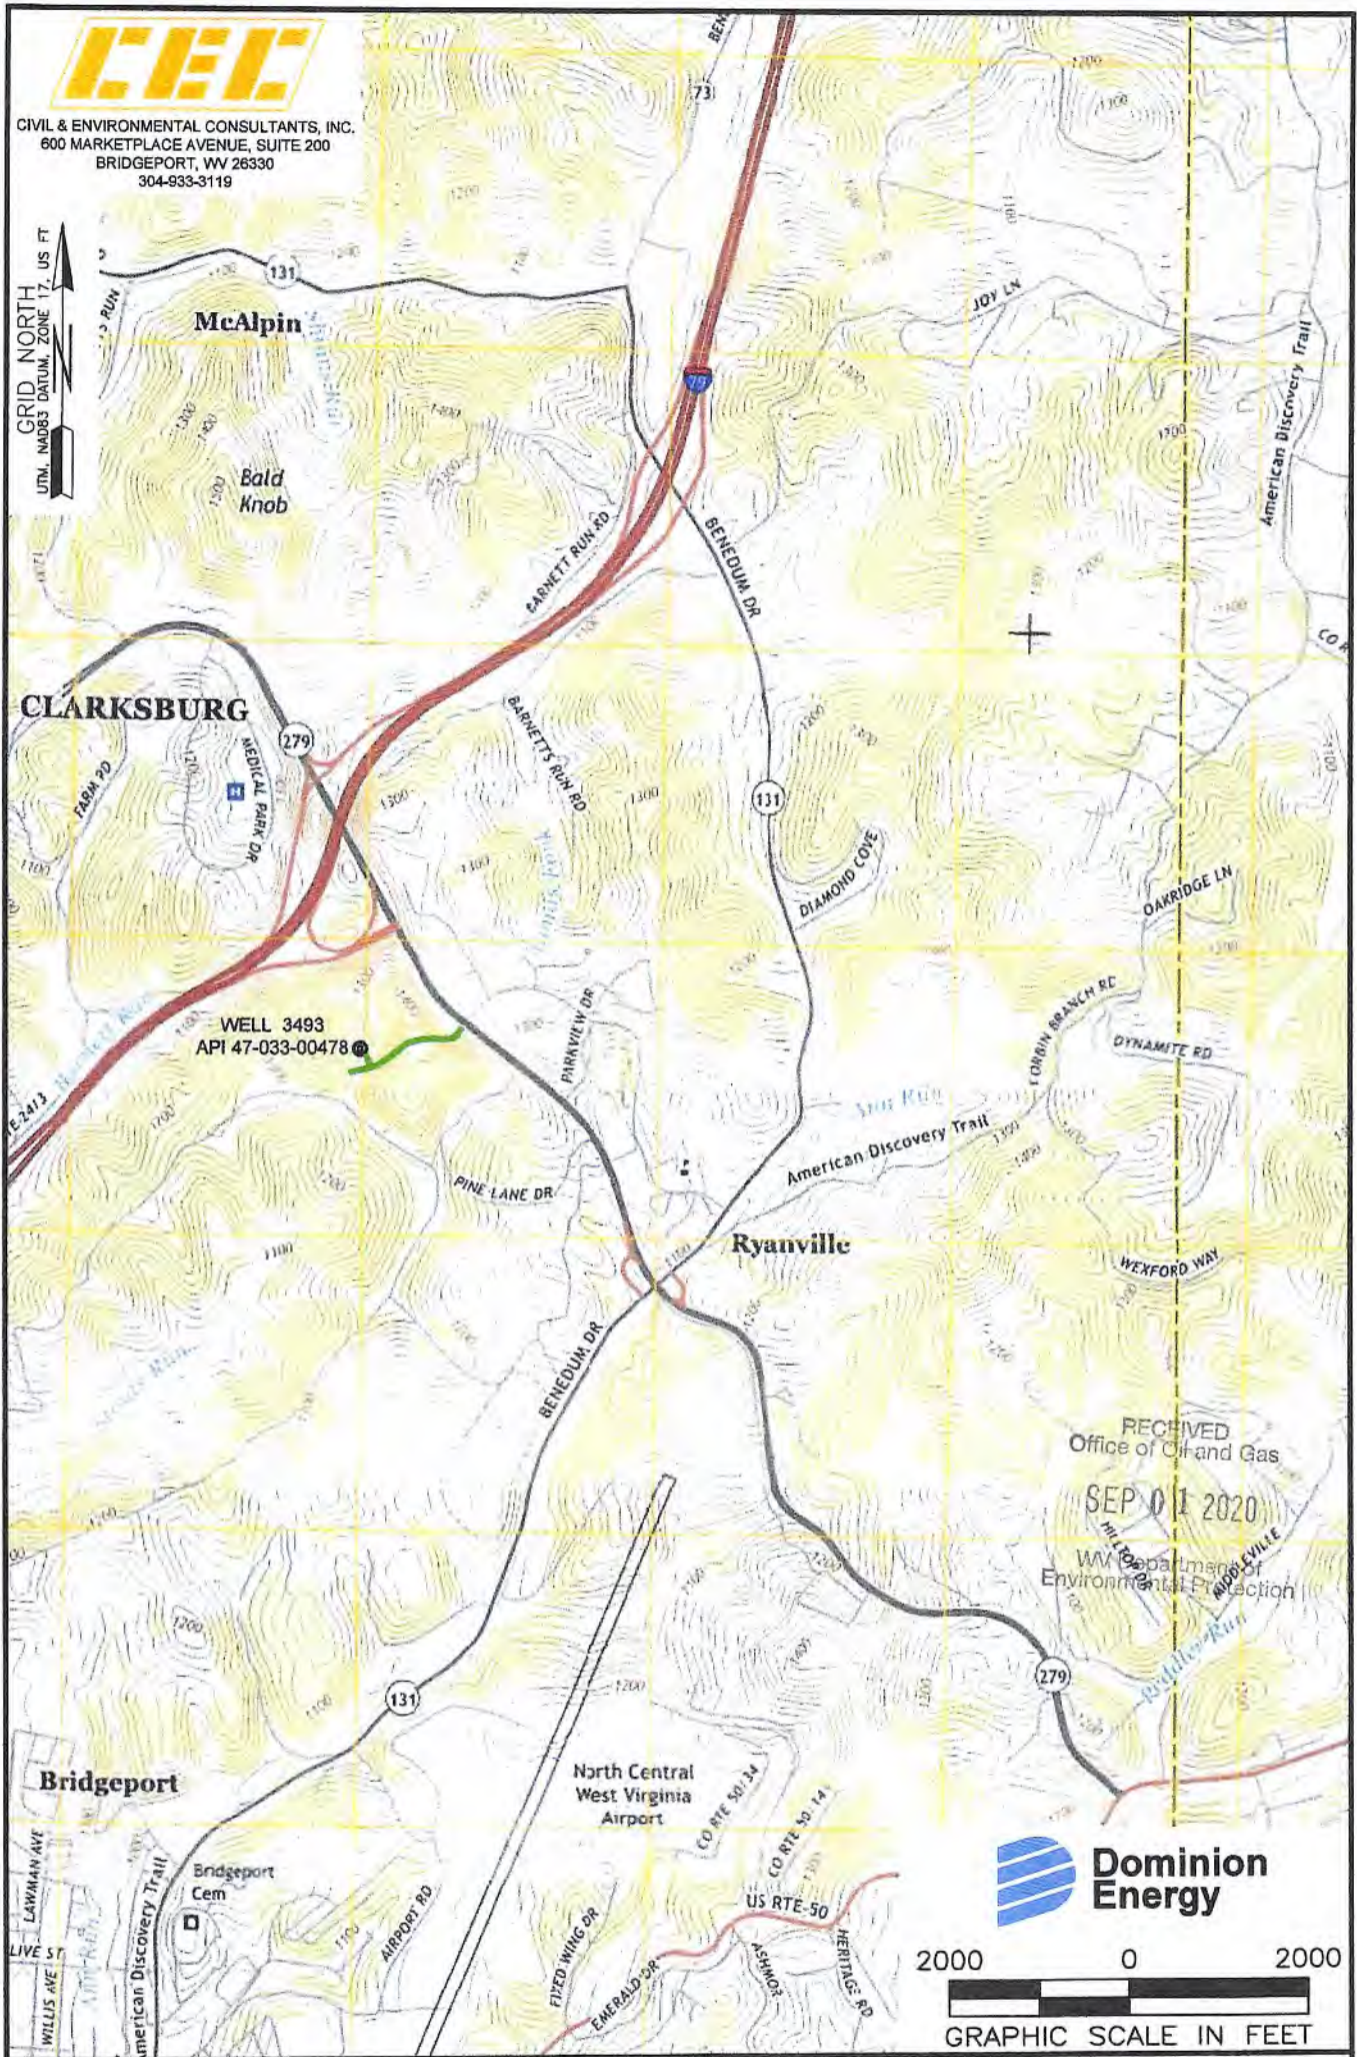

RECEIVED
 Office of Oil and Gas
 SEP 01 2020
 WV Department of Environmental Protection

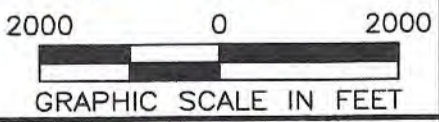

NOTES ON SURVEY
 1. SURFACE AND ROYALTY OWNER INFORMATION AND THEIR BOUNDARIES SHOWN HEREON WERE PLOTTED FROM DEEDS AND/OR TAX PARCEL MAPS PROVIDED BY CLIENT AND/OR FIELD LOCATIONS.
 2. THIS PLAT DOES NOT REPRESENT A BOUNDARY SURVEY OF THE PARCELS SHOWN HEREON.
 4. ALL INSETS ARE GRID NORTH UNLESS OTHERWISE DEPICTED.

LEGEND:

	PROPOSED SURFACE HOLE / BOTTOM HOLE		ACCESS ROAD
	EXISTING / PRODUCING WELLHEAD		PUBLIC ROAD
	LANDING POINT LOCATION		ACCESS ROAD TO PREV. SITE
	FLOOD PLAN		LEASE BOUNDARY
			PROPOSED PATH

WELL OPERATOR: DOMINION ENERGY	WELL (FARM) NAME: A. T. CROPP	WELL # 3493	SERIAL #
ADDRESS: 925 WHITE OAKS BLVD, BRIDGEPORT, WV 26330	COUNTY - CODE HARRISON - 033	DISTRICT; SIMPSON DISTRICT	
SURFACE OWNER: CHARLES POINTE CROSSING LLC	USGS 7 1/2 QUADRANGLE MAP NAME ROSEMONT, WV		