



GRID NORTH  
W.V. NORTH, NAD83 DATUM, US FT

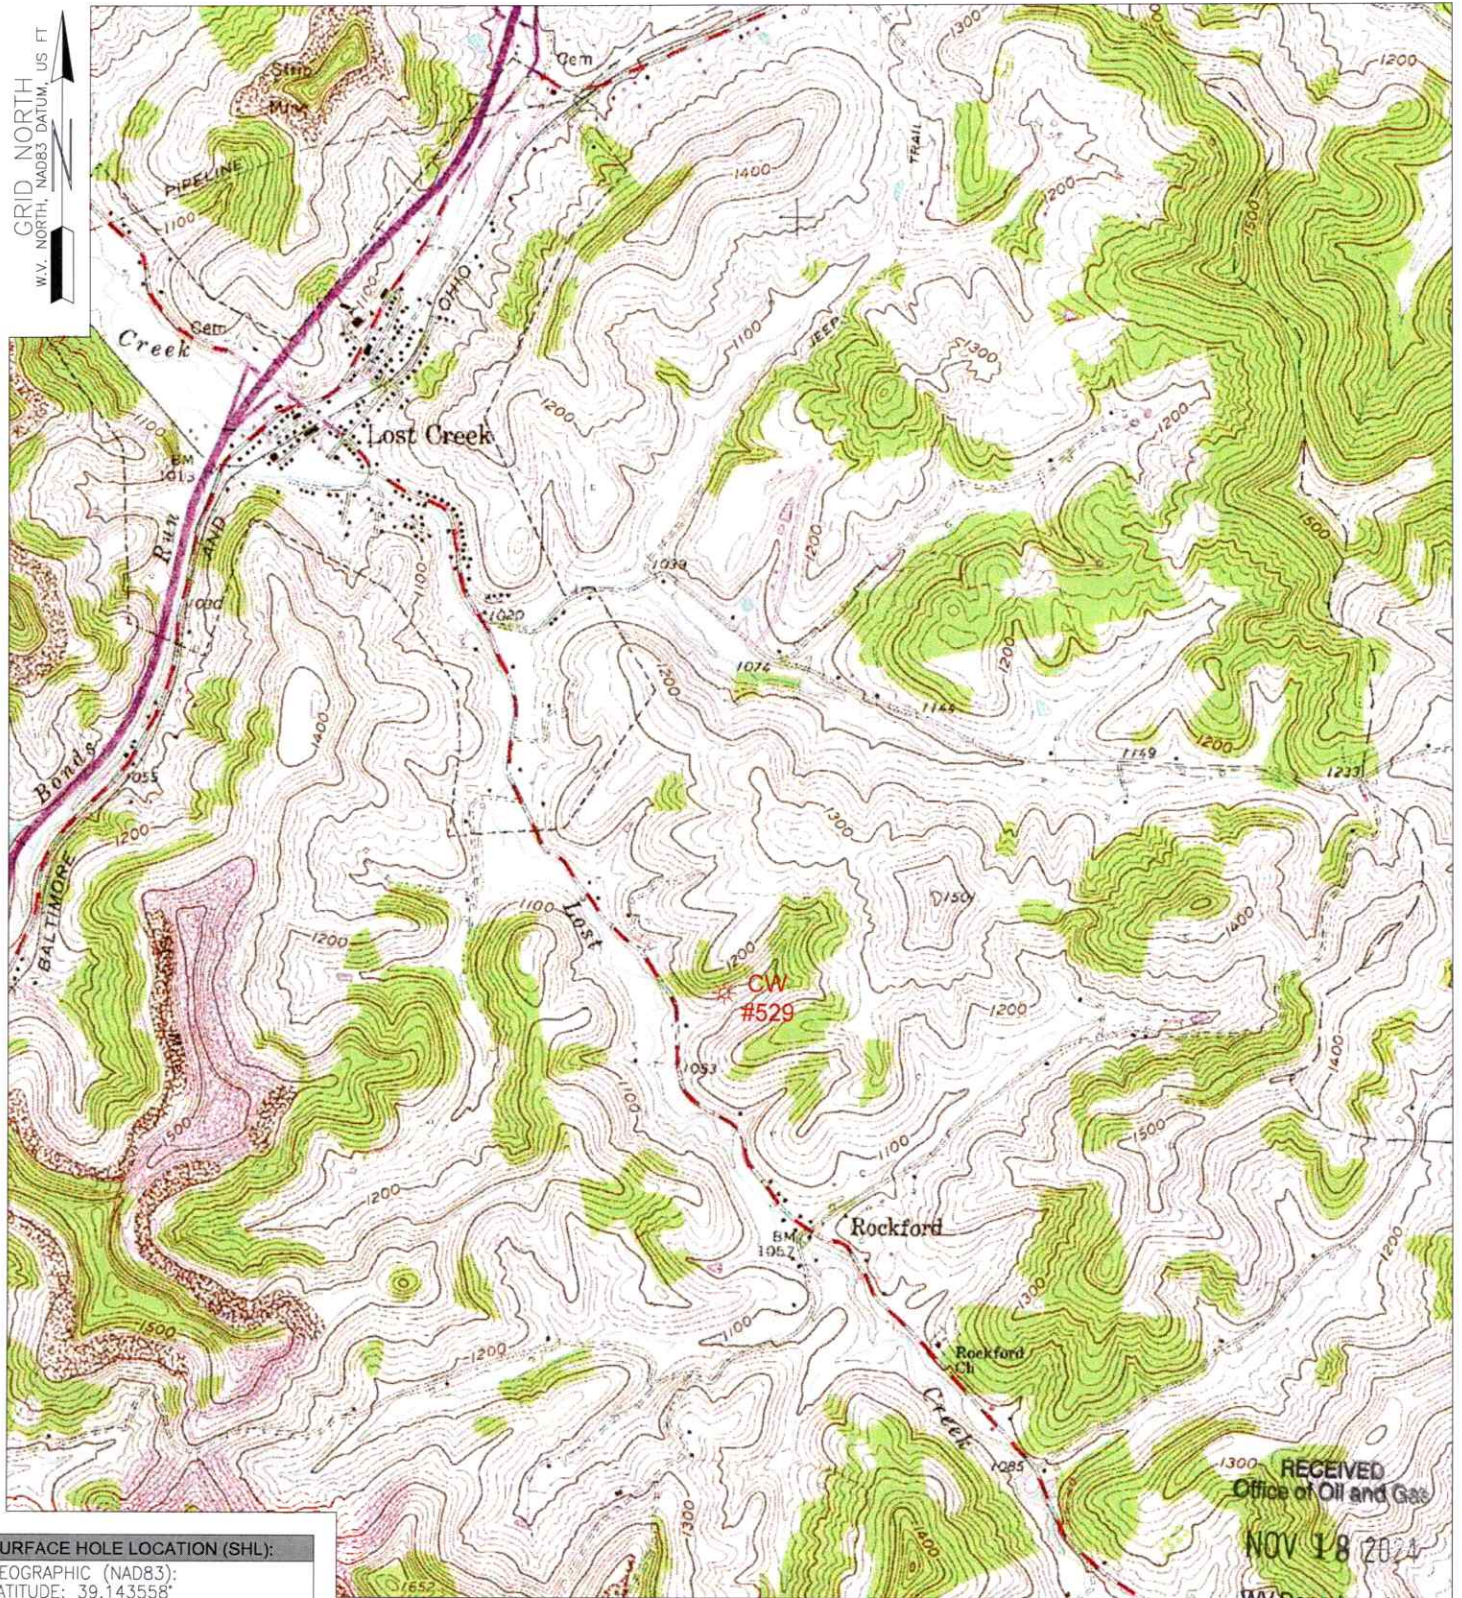

**SURFACE HOLE LOCATION (SHL):**  
 GEOGRAPHIC (NAD83):  
 LATITUDE: 39.143558°  
 LONGITUDE: -80.335825°  
 UTM (NAD83, ZONE 17, FEET):  
 NORTHING: 14,215,580.545  
 EASTING: 1,828,723.324  
 UTM (NAD83, ZONE 17, METERS):  
 NORTHING: 4,332,917.616  
 EASTING: 557,395.984

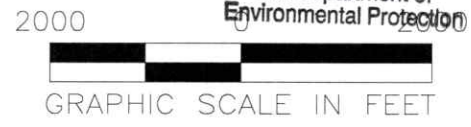

WELL OPERATOR: Eastern Gas Transmission and Storage, Inc.	WELL (FARM) NAME: Lewis C. Swisher	WELL # 4022	SERIAL #
ADDRESS: 925 White Oaks Blvd., Bridgeport, WV 26330	COUNTY - CODE HARRISON - 33	DISTRICT; GRANT	
SURFACE OWNER: DEBRA J. & THOMAS A. BEDELL	USGS 7 1/2 QUADRANGLE MAP NAME Mount Clare, W. VA.	API: 47-033-00523	

S:\PROJECT 3647 BHE-PLUG CW-529\SURVEY\DWGS\3647 BHE-PLUG CW-529.DWG  
 MONDAY MARCH 11 2024 06:15PM

02/28/2025



West Virginia Department of Environmental Protection  
Office of Oil and Gas  
**WELL LOCATION FORM: GPS**

API: 47-033-00523 WELL NO.: 4022

FARM NAME: Lewis C. Swisher

RESPONSIBLE PARTY NAME: Ascent Consulting & Engineering

COUNTY: Harrison DISTRICT: Grant

QUADRANGLE: Mount Clare, W. VA.

SURFACE OWNER: Debra J. & Thomas A. Bedell

ROYALTY OWNER: Debra J. & Thomas A. Bedell

UTM GPS NORTHING: 4,332,917.616

UTM GPS EASTING: 557,395.984 GPS ELEVATION: 1,106.47

The Responsible Party named above has chosen to submit GPS coordinates in lieu of preparing a new well location plat for a plugging permit or assigned API number on the above well. The Office of Oil and Gas will not accept GPS coordinates that do not meet the following requirements:

1. Datum: NAD 1983, Zone: 17 North, Coordinate Units: meters, Altitude: height above mean sea level (MSL) – meters.
2. Accuracy to Datum – 3.05 meters
3. Data Collection Method:

Survey grade GPS  : Post Processed Differential \_\_\_\_\_  
Real-Time Differential

Mapping Grade GPS \_\_\_\_\_ : Post Processed Differential \_\_\_\_\_  
Real-Time Differential \_\_\_\_\_

4. **Letter size copy of the topography map showing the well location.**

I the undersigned, hereby certify this data is correct to the best of my knowledge and belief and shows all the information required by law and the regulations issued and prescribed by the Office of Oil and Gas.

*Mark Ogden*  
Signature

Professional Surveyor  
Title

3-11-2024  
Date

RECEIVED  
Office of Oil and Gas  
NOV 18 2024  
WV Department of  
Environmental Protection