


8,000'
 1.12 S
 1.56 W

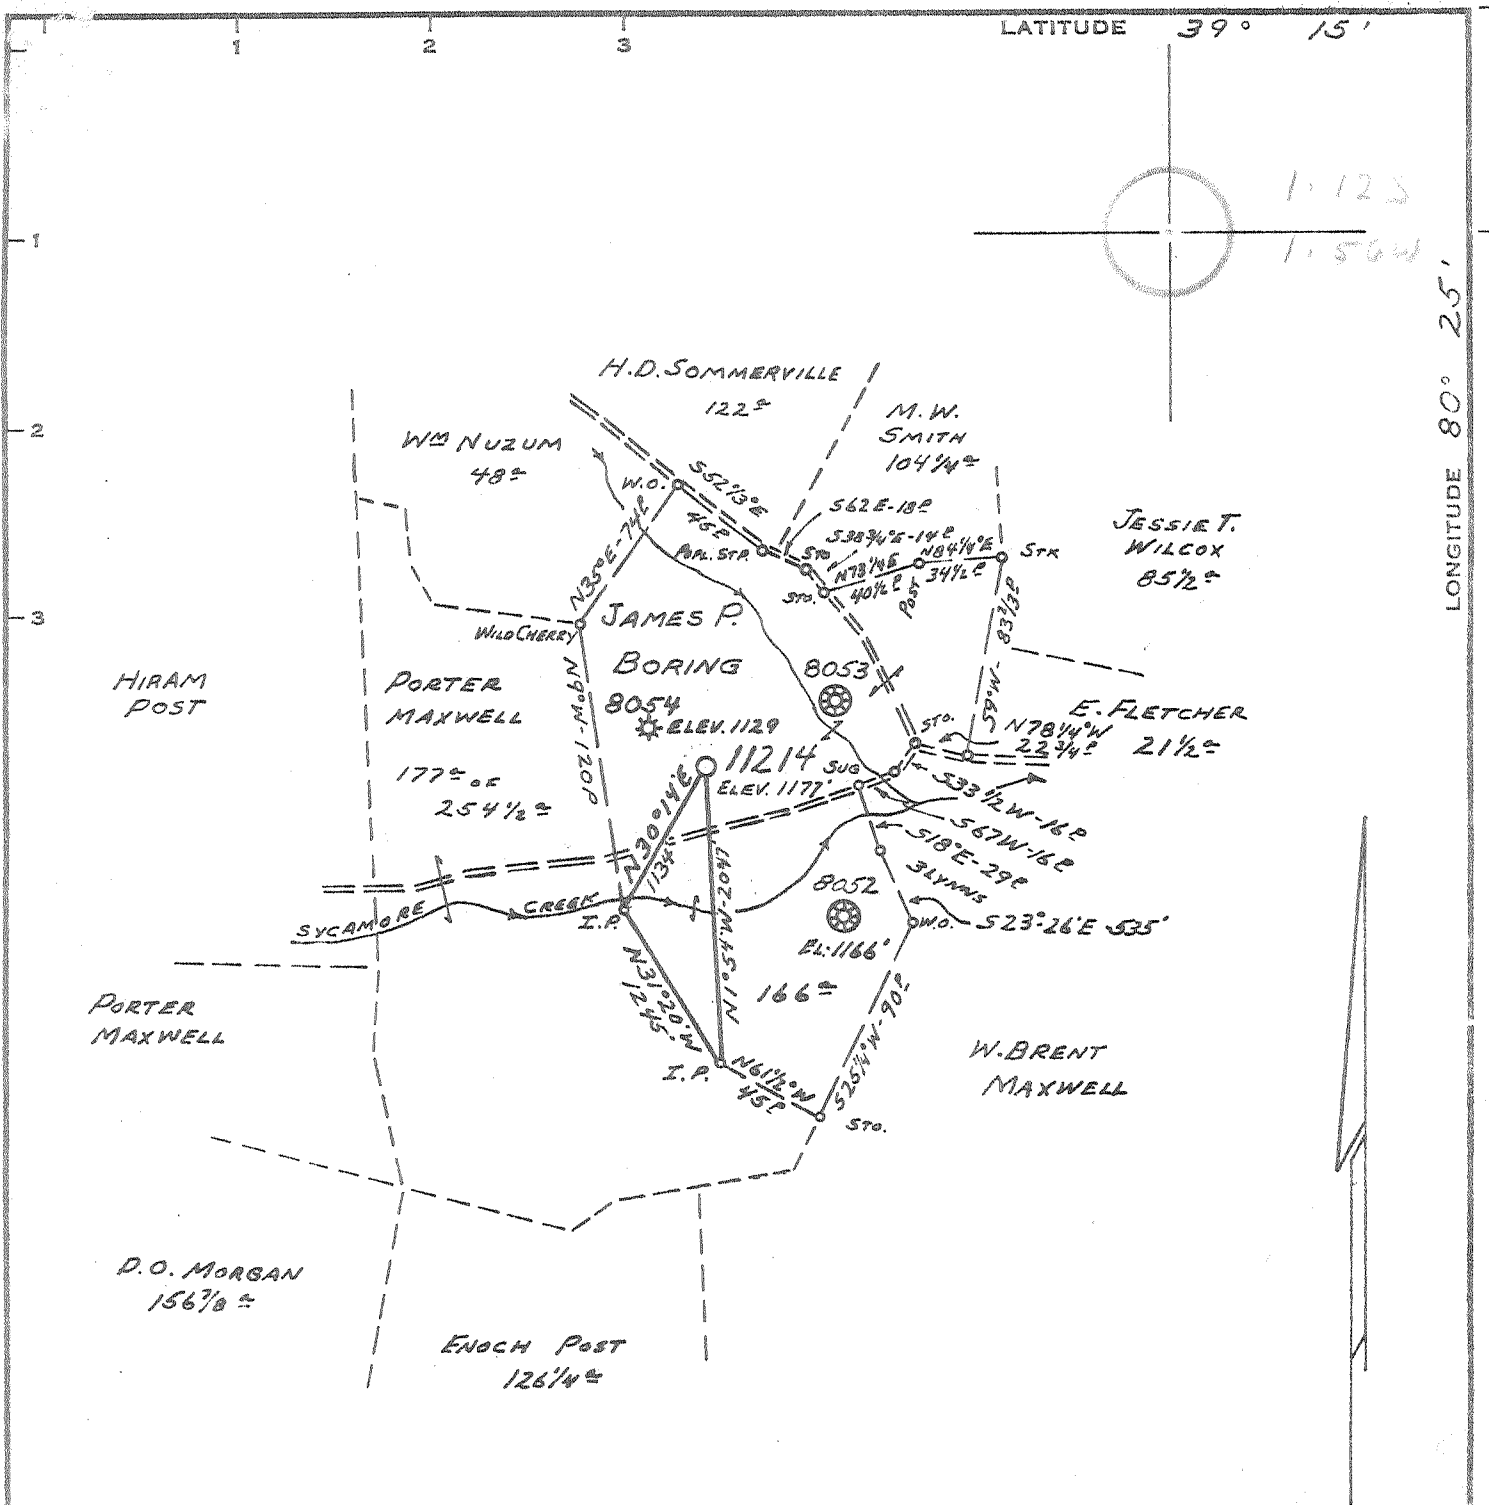

Minimum Error of Closure 1' IN 200'
 Source of Elevation ROAD FORKS - JCT. W. VA. SLS-31/3 & COAL STRIPPERS
ROAD - WEST MILFORD 7 1/2 TOPO MAP - ELEV. 1022'
 "I, the undersigned, hereby certify that this map is correct to the best of my knowledge and belief and shows all the information required by paragraph 6 of the rules and regulations of the oil and gas section of the mining laws of West Virginia."

~~New Location~~
 Drill Deeper
 Abandonment

-UNIT-343-

MAP SHEET 55 S-16, E-9 F.B. 1527 PG. 30-31

Company CONSOLIDATED GAS SUPPLY CORP.
 Address CLARKSBURG, W. VA.
 Farm JAMES P. BORING
 Tract _____ Acres 166 Lease No. 52847
 Well (Farm) No. _____ Serial No. 11214
 Elevation (Spirit Level) 1177'
 Quadrangle WESTON NW
 County HARRISON District UNION
 Engineer Jackson M. Jarvis
 Engineer's Registration No. 2397
 File No. _____ Drawing No. _____
 Date 12-12-69 Scale 1" = 1320'

STATE OF WEST VIRGINIA
 DEPARTMENT OF MINES
 OIL AND GAS DIVISION
 CHARLESTON

WELL LOCATION MAP
 FILE NO. HAR-527-P

+ Denotes location of well on United States Topographic Maps, scale 1 to 62,500, latitude and longitude lines being represented by border lines as shown.
 — Denotes one inch spaces on border line of original tracing.

3-0 Jarvisville 151 Deep Well (Oriskany) AUG 24 1970 5546

RECEIVED

AUG 13 1970

OIL & GAS DIVISION
DEPT. OF MINES



STATE OF WEST VIRGINIA
DEPARTMENT OF MINES
OIL AND GAS WELLS DIVISION

Rotary XXXX
Spudder
Cable Tools
Storage

Form OG-10

Quadrangle WESTON
Permit No. HAR-527

WELL RECORD

Oil or Gas Well Dry

Company Consolidated Gas Supply Corporation
Address Clarksburg, W. Va.
Farm James P. Boring Acres 166
Location (waters) _____
Well No. 1121h Elev. 1177'
District Union County Harrison
The surface of tract is owned in fee by _____
Address _____
Mineral rights are owned by _____
Address _____
Drilling commenced 12-19-69
Drilling completed 1-19-70
Date Shot Not shot From _____ To _____
With _____
Open Flow /10ths Water in _____ Inch
/10ths Merc. in _____ Inch
Volume Show _____ Cu. Ft.
Rock Pressure Not taken lbs _____ hrs.
Oil _____ bbls., 1st 24 hrs.
WELL ACIDIZED (DETAILS) No
WELL FRACTURED (DETAILS) 2-26-70 15,000# Sand, 1000 gal water and 1000 gal acid

Casing and Tubing	Used in Drilling	Left in Well	Packers
Size			Kind of Packer
16			
13	2 1/2	2 1/2	
XXIX 9"	1132	1132	Size of
8 1/4			Depth set
6 3/4			
5 3/16	713 1/2	713 1/2	
4 1/2			Perf. top
3			Perf. bottom
2			Perf. top
Liners Used			Perf. bottom

Attach copy of cementing record. 13" to surface
8" to surface
CASING CEMENTED _____ SIZE _____ No. Ft. _____ Date _____
Amount of cement used (bags) 1 1/2" with 150 bags
Name of Service Co. Halliburton
COAL WAS ENCOUNTERED AT None FEET _____ INCHES
FEET _____ INCHES FEET _____ INCHES
FEET _____ INCHES FEET _____ INCHES

RESULT AFTER TREATMENT (Initial open Flow or bbls.) Not enough gas to warrant keeping well
ROCK PRESSURE AFTER TREATMENT 2195 XHOURS 1 1/2 days
Fresh Water 50' Feet _____ Salt Water None Feet _____
Producing Sand Oriskany Test Dry Hole _____ Depth See log

Formation	Color	Hard or Soft	Top	Bottom	Oil, Gas or Water	Depth	Remarks
Sand & Shale			0	795	Water	50'	
1st Salt			795	830			
Sand & Shale			830	1120			
Big Lime			1120	1155			
Big Injun			1155	1580			
Sand & Shale			1580	2150			
Gordon			2150	2185			
Sand & Shale			2185	3020			
Speechley			3020	3055			
Sand & Slate			3055	3250			
BALLTOWN			3250	3290			
Sand & Shale			3290	6875			
Onondaga			6875	6905			
Chert - <u>Hantersville</u>			6905	7118			
ORISKANY			7118	7220	Gas	Show	
Sand & Shale			7220	7300			
Total Depth				7300'			

All measurements taken from K.B. 10' above G.L.
Will abandon

Consolidated Gas Supply Corporation
1145 West Main Street
Clarksburg, W. Va.

AUG 24 1970

** W VA HARRISON 6150 S 8000 W 39.15 80.25 WD
 CONSOL GAS SUPPLY JAMES P BORING 527 UNION
 1187 KB 1177 GR JARVISVILLE D&A
 SPUD 12/19/69 COMP 08/04/70
 CSG 13 3/8 AT 30 9 5/8 AT 1150
 5 AT 7151W/ CMT
 DTD 7300 LTD 7299 BTM HELDERSBERG

LOG--	TOP			LOG--	TOP		
B LM	1416	1481	229-	SPEECHLY	3024	3045	1837-
B INJUN	1481	1571	294-	BALTWN	3252	3311	2065-
50 FT	1915	1975	728-	BENSON	4371	4389	3184-
GORDON-				TULLY	6612	6672	5425-
STRAY	2160		973-	ONONDAGA	6874	6904	5687-
GORDN BA	2225		1038-	CHERT	6907	7144	5720-
4TH SD	2267	2273	1080-	ORISKANY	7144		5957-
5TH SD	2331	2350	1144-				

MAP QUAD WESTON PROJ DEPTH ORISKANY AC 166 ??
 CONTR S W JACK TOOLS RT

CARTER COORD 9-GG-109
 OPR WELL #11214
 LEASE #52847
 ON WOLF SUMMIT ANTICLINE

(see other side)

HAR-
527

Consol. Gas Well #
 11214