



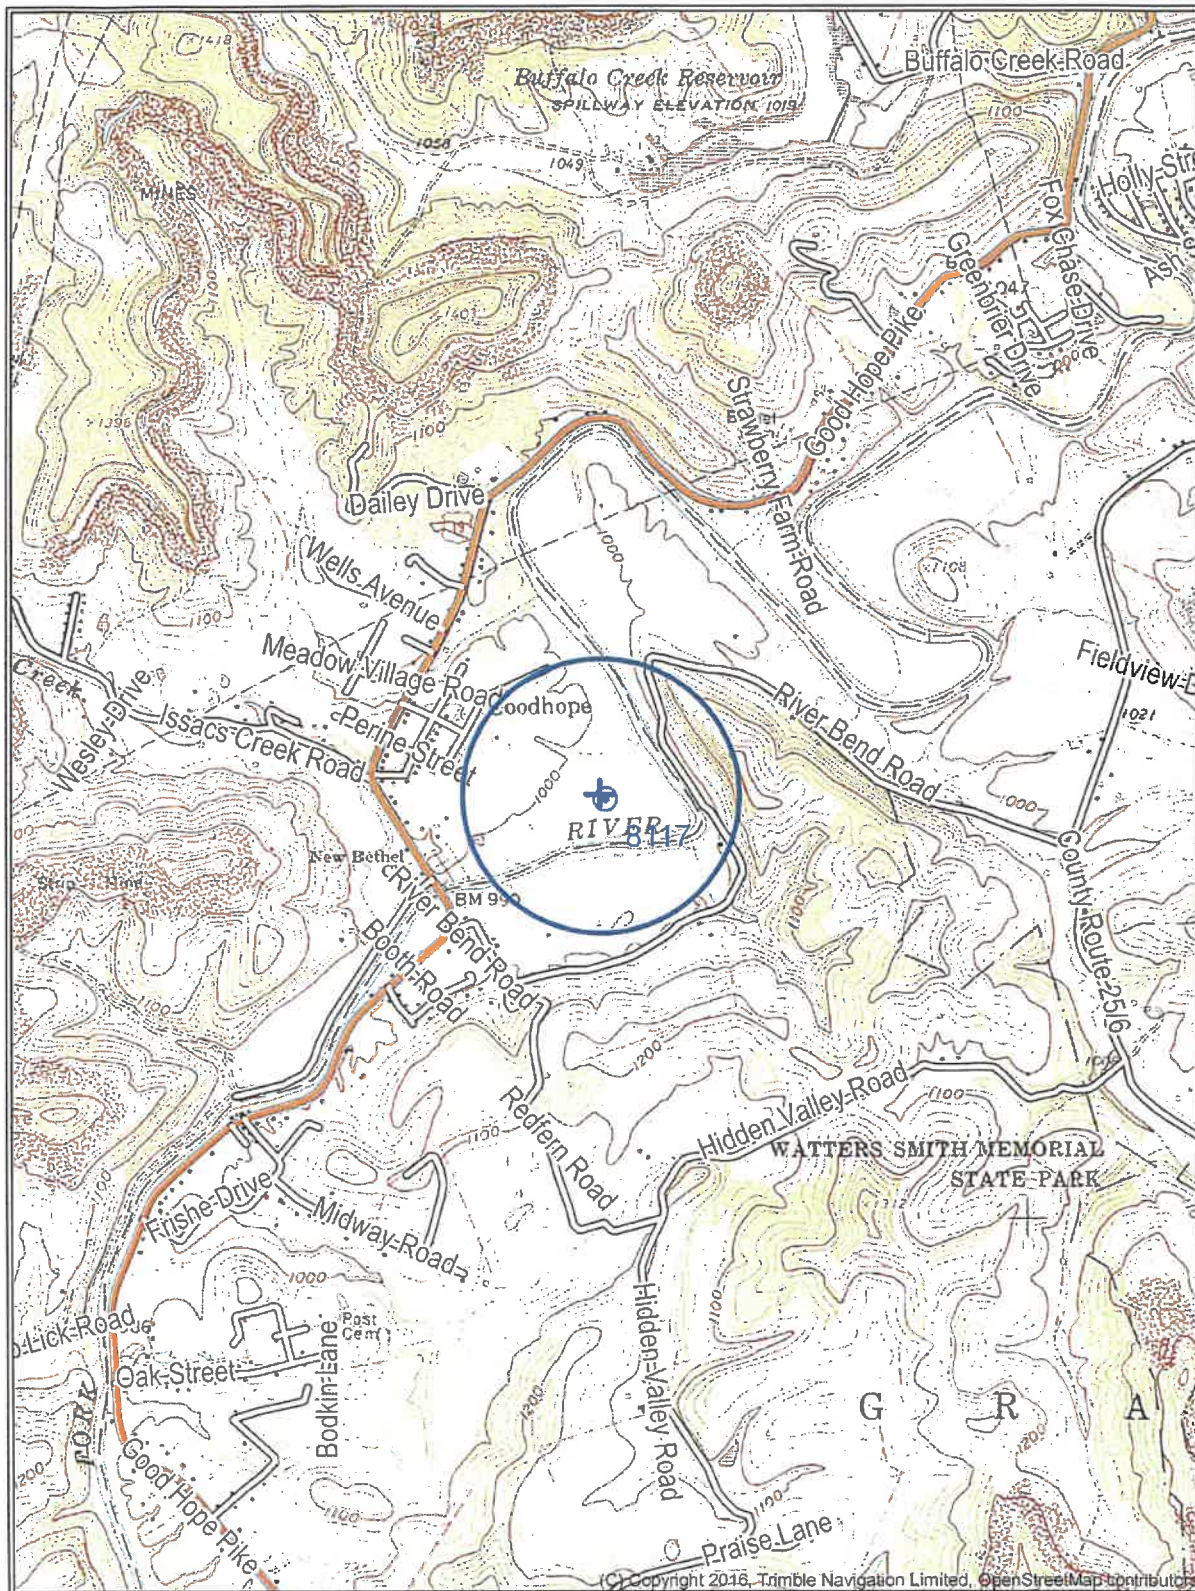

RECEIVED
Office of Oil and Gas

JUL 13 2026

WV Department of
Environmental Protection

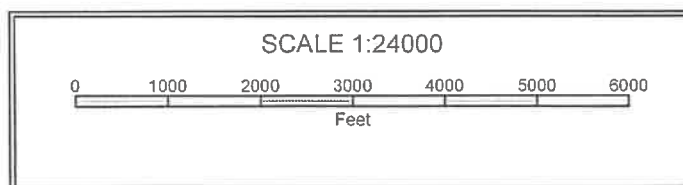

08/21/2026

WW-7
8-30-06



West Virginia Department of Environmental Protection
Office of Oil and Gas

WELL LOCATION FORM: GPS

RECEIVED
Office of Oil and Gas

JUL 13 2026

WV Department of
Environmental Protection

API: 47 033 00745 WELL NO.: 8117

FARM NAME: G.W. WASHBURN

RESPONSIBLE PARTY NAME: EASTERN GAS TRANSMISSION AND STORAGE, INC.

COUNTY: HARRISON DISTRICT: UNION OUTSIDE

QUADRANGLE: WEST MILFORD

SURFACE OWNER: BRIAN WAYNE MYERS

ROYALTY OWNER: HG ENERGY II APPALACHIA, LLC; BLACK BEAR ENERGY CORP.; WACO OIL AND GAS CO., INC.; WILLIAM E. WAGNER

UTM GPS NORTHING: 4336818.61

UTM GPS EASTING: 549009.88 GPS ELEVATION: 300.13M / 985'

The Responsible Party named above has chosen to submit GPS coordinates in lieu of preparing a new well location plat for a plugging permit or assigned API number on the above well. The Office of Oil and Gas will not accept GPS coordinates that do not meet the following requirements:

1. Datum: NAD 1983, Zone: 17 North, Coordinate Units: meters, Altitude: height above mean sea level (MSL) – meters.
2. Accuracy to Datum – 3.05 meters
3. Data Collection Method:
Survey grade GPS ____: Post Processed Differential ____

Real-Time Differential ____

Mapping Grade GPS X: Post Processed Differential ____

Real-Time Differential ____

4. Letter size copy of the topography map showing the well location.

I the undersigned, hereby certify this data is correct to the best of my knowledge and belief and shows all the information required by law and the regulations issued and prescribed by the Office of Oil and Gas.


Signature


Title

5-22-2026
Date

08/21/2026