



DIVERSIFIED
energy



47-033-00747

Well Plugging Map

Legend

- Well
- Pits
- Pad
- Access Road
- Public Roads

RECEIVED
Office of Oil and Gas
SEP 03 2026
WV Department of
Environmental Protection

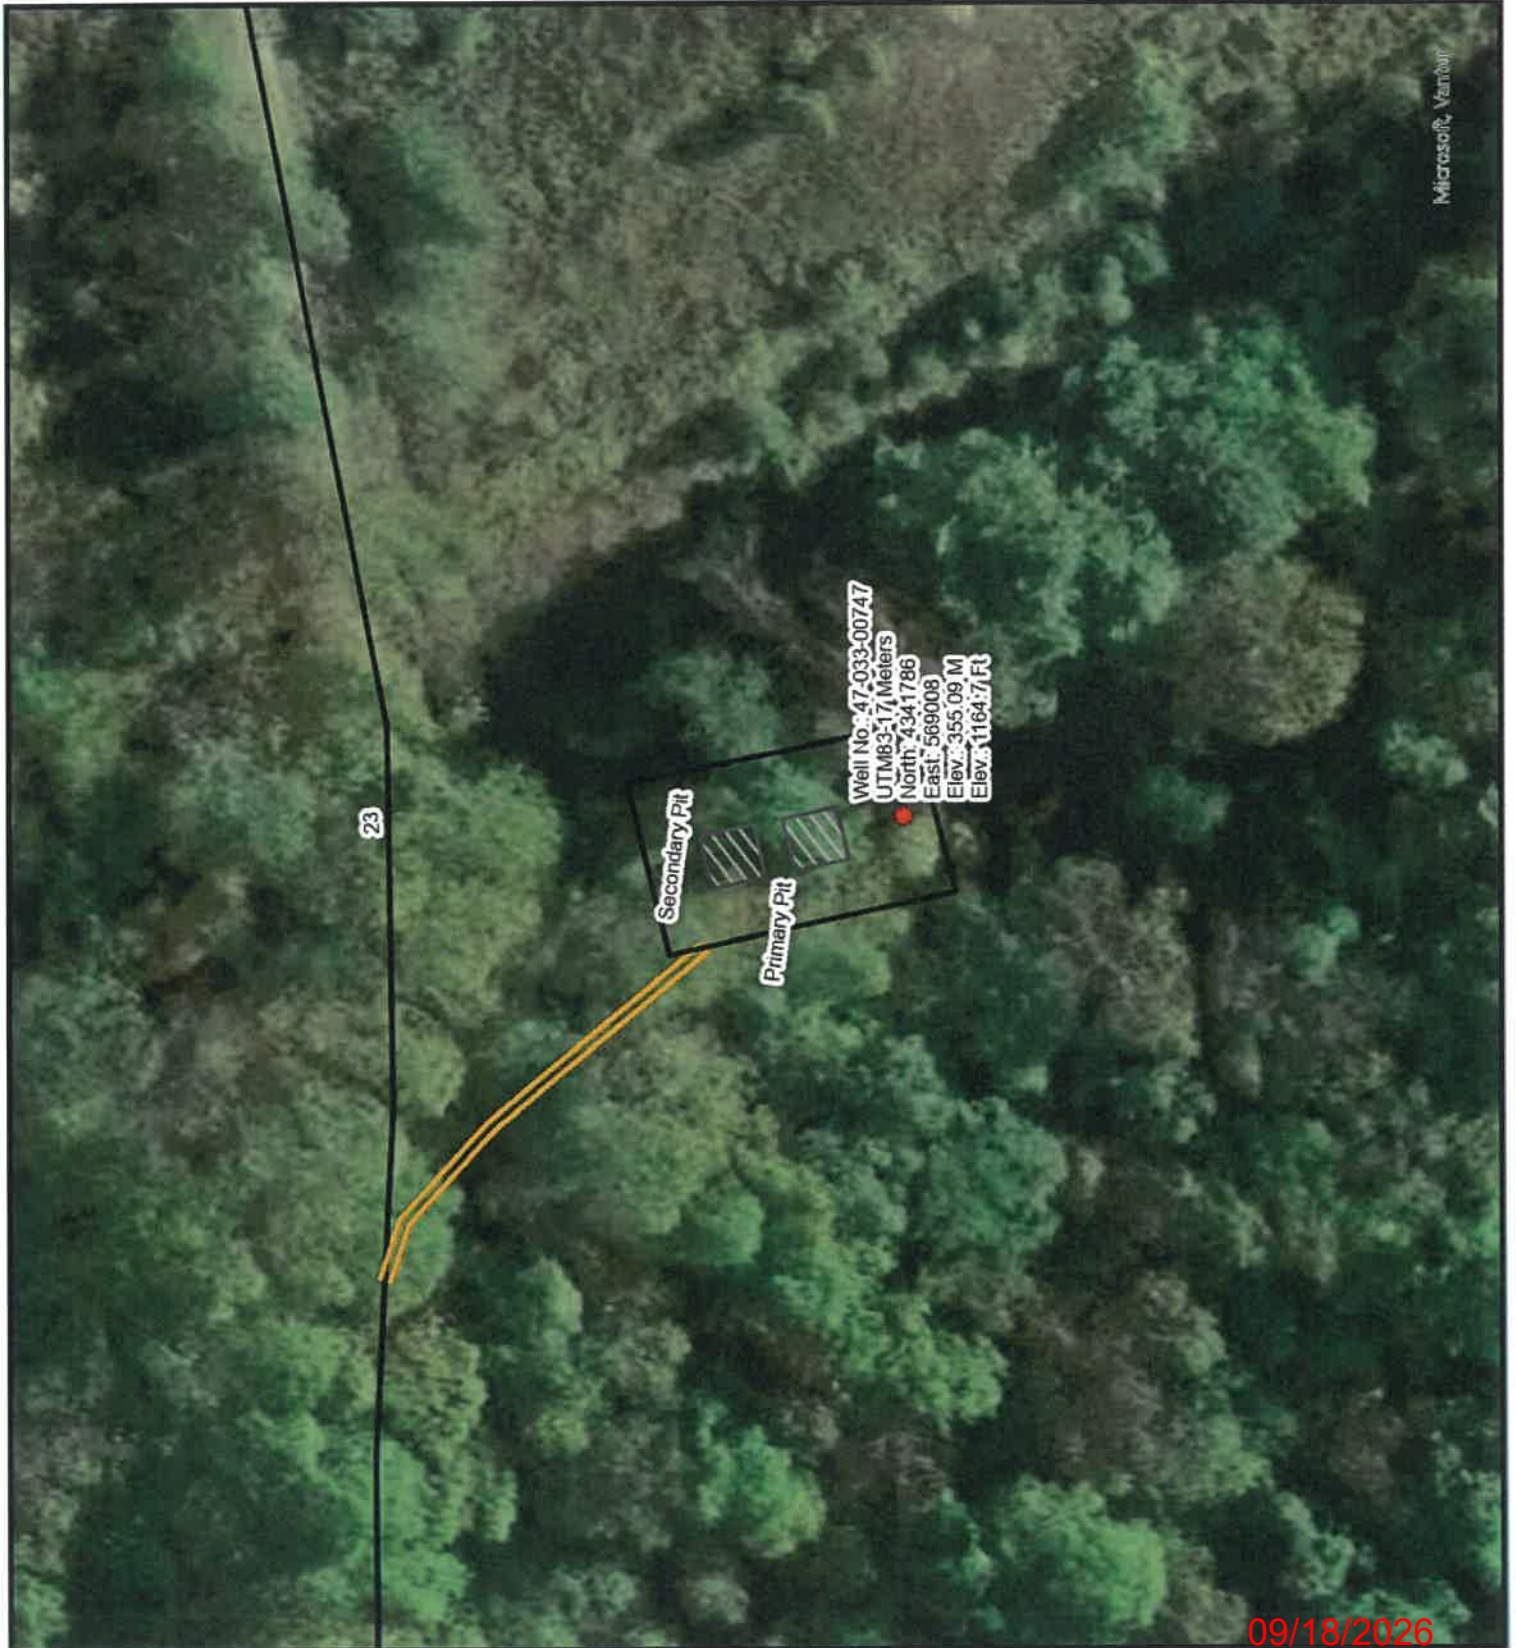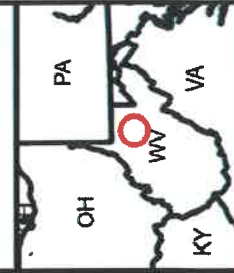





DIVERSIFIED
energy

47-033-00747

Well Plugging Map

Legend

- Well
- Pits
- Pad
- Access Road
- Public Roads

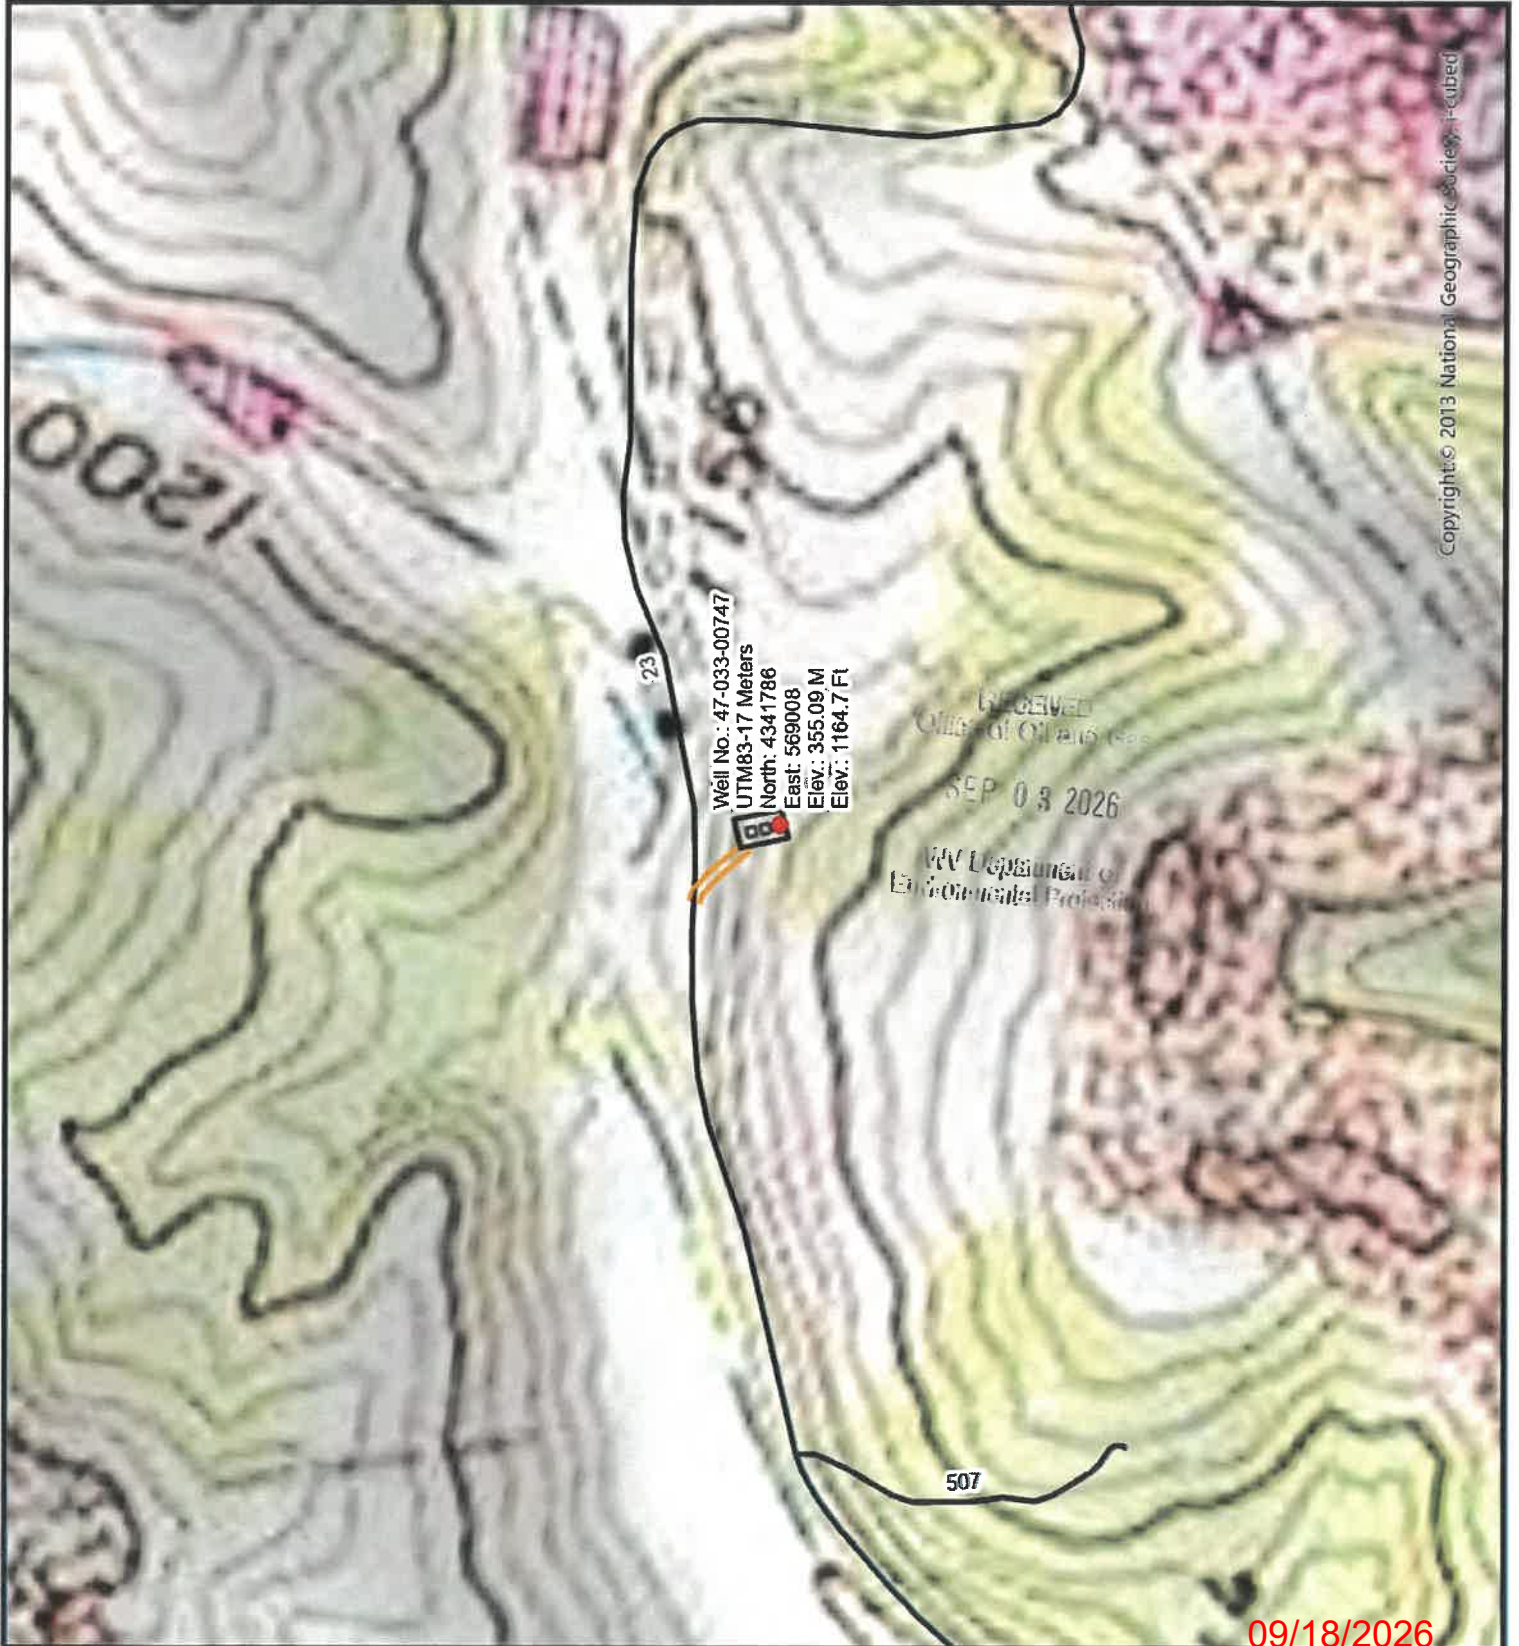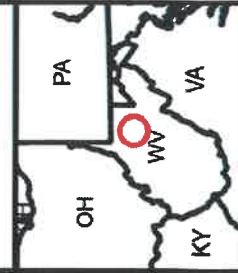

WW-7
8-30-06



West Virginia Department of Environmental Protection
Office of Oil and Gas
WELL LOCATION FORM: GPS

API: 4703300747 WELL NO.: JJ Horner 2
FARM NAME: JJ Horner
RESPONSIBLE PARTY NAME: Diversified Production, LLC
COUNTY: Harrison DISTRICT: Simpson-Outside
QUADRANGLE: Brownton 7.5'
SURFACE OWNER: Robert W. Cobun, II
ROYALTY OWNER: Undetermined
UTM GPS NORTHING: 4341786
UTM GPS EASTING: 569008 GPS ELEVATION: 1164.7'

The Responsible Party named above has chosen to submit GPS coordinates in lieu of preparing a new well location plat for a plugging permit or assigned API number on the above well. The Office of Oil and Gas will not accept GPS coordinates that do not meet the following requirements:

1. Datum: NAD 1983, Zone: 17 North, Coordinate Units: meters, Altitude: height above mean sea level (MSL) – meters.
2. Accuracy to Datum – 3.05 meters
3. Data Collection Method:
Survey grade GPS ____: Post Processed Differential ____
Real-Time Differential ____
Mapping Grade GPS X: Post Processed Differential X
Real-Time Differential ____

4. Letter size copy of the topography map showing the well location.

I the undersigned, hereby certify this data is correct to the best of my knowledge and belief and shows all the information required by law and the regulations issued and prescribed by the Office of Oil and Gas.

Signature

Nick Bumgardner - Plugging Manager

Title

Date

RECEIVED
Office of Oil and Gas
SEP 03 2026
WV Department of
Environmental Protection

09/18/2026