
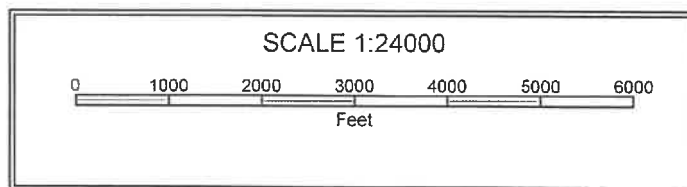


4703300830P

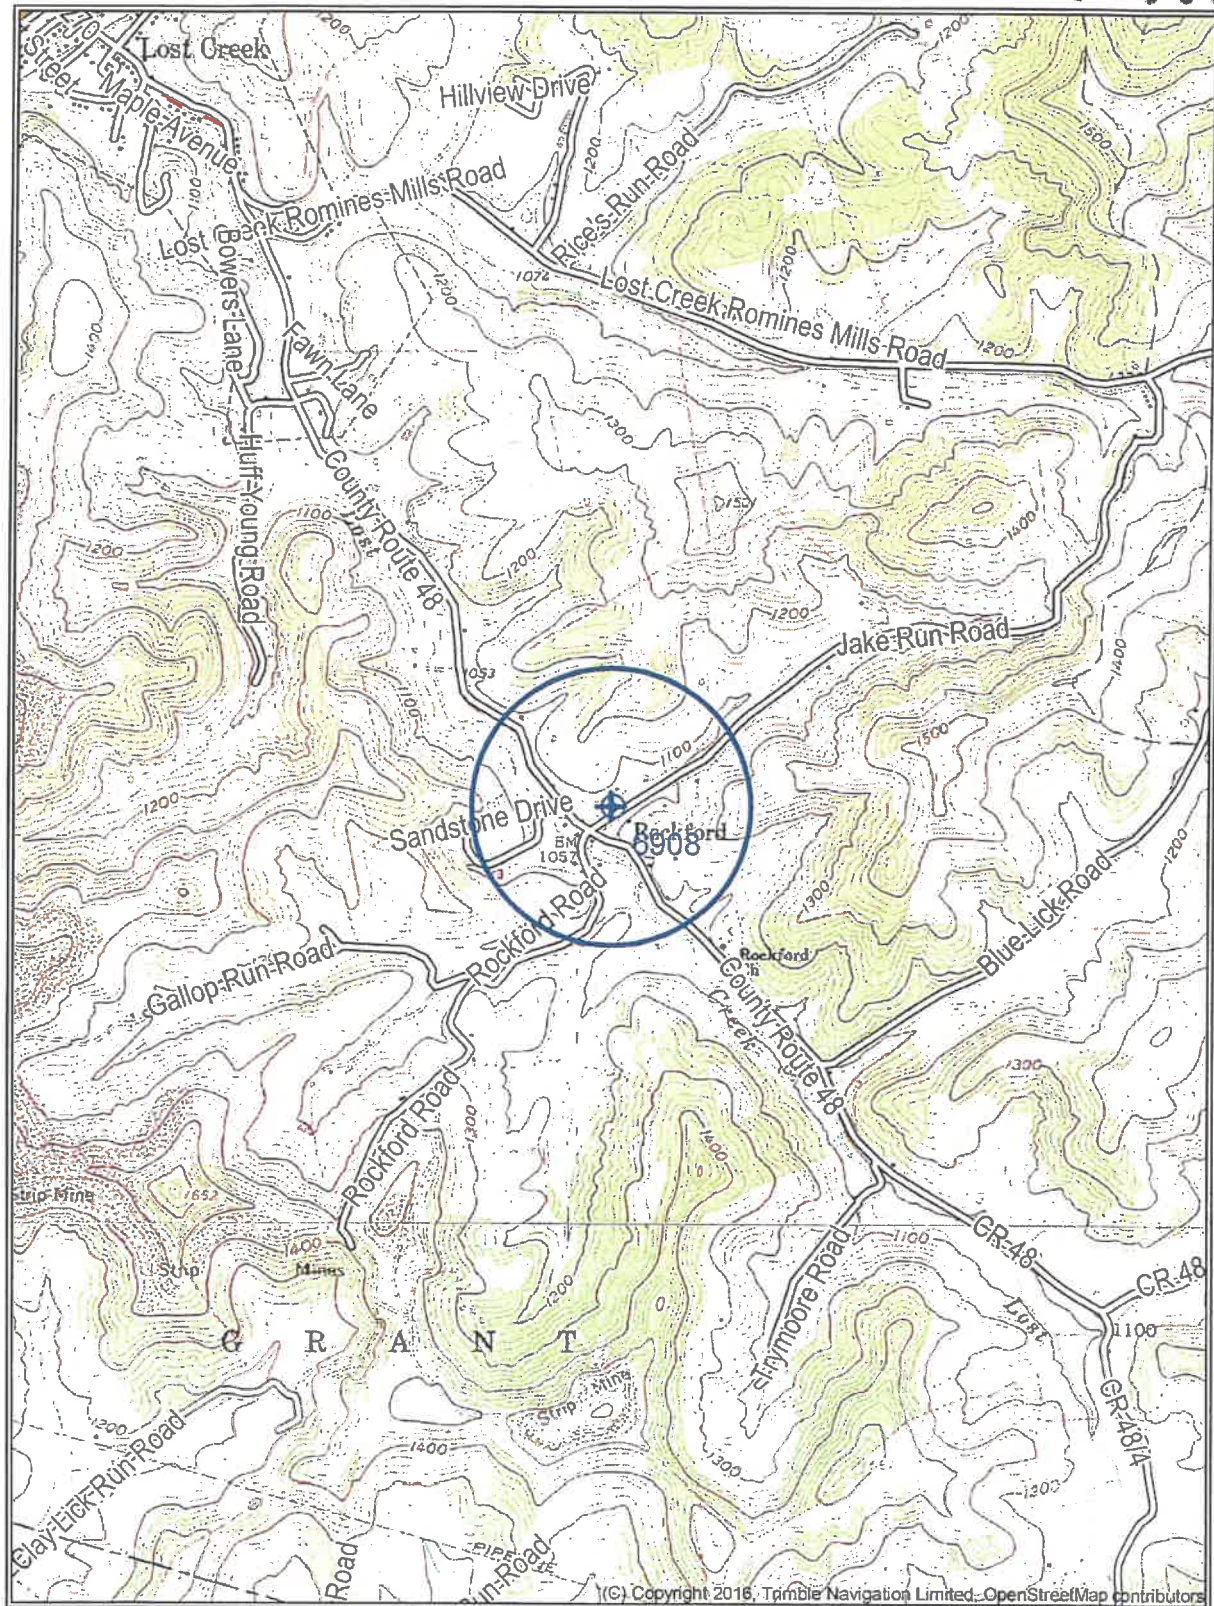

RECEIVED
Office of Oil and Gas

07 2026

Department of
Environmental Protection

08/28/2026

WW-7
8-30-06

4703300830P



West Virginia Department of Environmental Protection
Office of Oil and Gas

WELL LOCATION FORM: GPS

API: 47-033-00830 WELL NO.: 6908

FARM NAME: L.A. VAN HORN

RESPONSIBLE PARTY NAME: EASTERN GAS TRANSMISSION AND STORAGE, INC.

COUNTY: HARRISON DISTRICT: GRANT-OUTSIDE

QUADRANGLE: WEST MILFORD

SURFACE OWNER: STEPHEN B. RIEL

ROYALTY OWNER: _____

UTM GPS NORTHING: 4332240.70

UTM GPS EASTING: 557782.67 GPS ELEVATION: 323.87M / 1063'

The Responsible Party named above has chosen to submit GPS coordinates in lieu of preparing a new well location plat for a plugging permit or assigned API number on the above well. The Office of Oil and Gas will not accept GPS coordinates that do not meet the following requirements:

1. Datum: NAD 1983, Zone: 17 North, Coordinate Units: meters, Altitude: height above mean sea level (MSL) – meters.
2. Accuracy to Datum – 3.05 meters
3. Data Collection Method:

Survey grade GPS ____: Post Processed Differential ____


Real-Time Differential ____

Mapping Grade GPS X: Post Processed Differential ____

Real-Time Differential ____

4. Letter size copy of the topography map showing the well location.

I the undersigned, hereby certify this data is correct to the best of my knowledge and belief and shows all the information required by law and the regulations issued and prescribed by the Office of Oil and Gas.

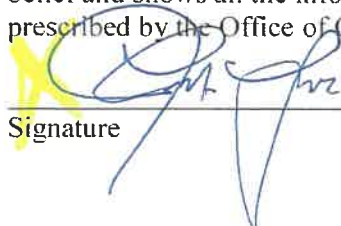
Signature

Director - Storage Ops.
Title

5-22-2026
Date

RECEIVED
Office of Oil and Gas

APR 7 2026

WV Department of
Environmental Protection

08/28/2026