




Diversified Gas & Oil
Corporation
100 Diversified Way
Pikeville KY, 41051


47-0333-01031

Well Plugging Map

Legend

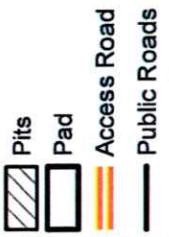

RECEIVED
Office Of Oil and Gas
JAN 6 2026
U.S. Department of
Energy, Washington

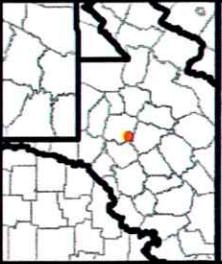

A scale bar and a north arrow. The scale bar is labeled '1" = 50' and has markings for 0, 25, and 50. The north arrow is a triangle with a line pointing towards the top-left.



01/16/2026



Diversified Gas & Oil
Corporation
100 Diversified Way
Pleasant KY, 41051


47-033-01031

Well Plugging Map


Legend

Well
Pits
Pad
Access Road
Public Roads

REMOVED
Office Of Oil and Gas
JAN 6 2026

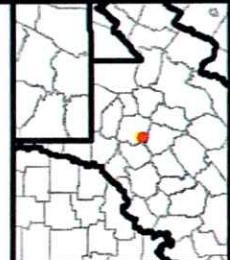

1" = 500'
0 250 500
Ft
N

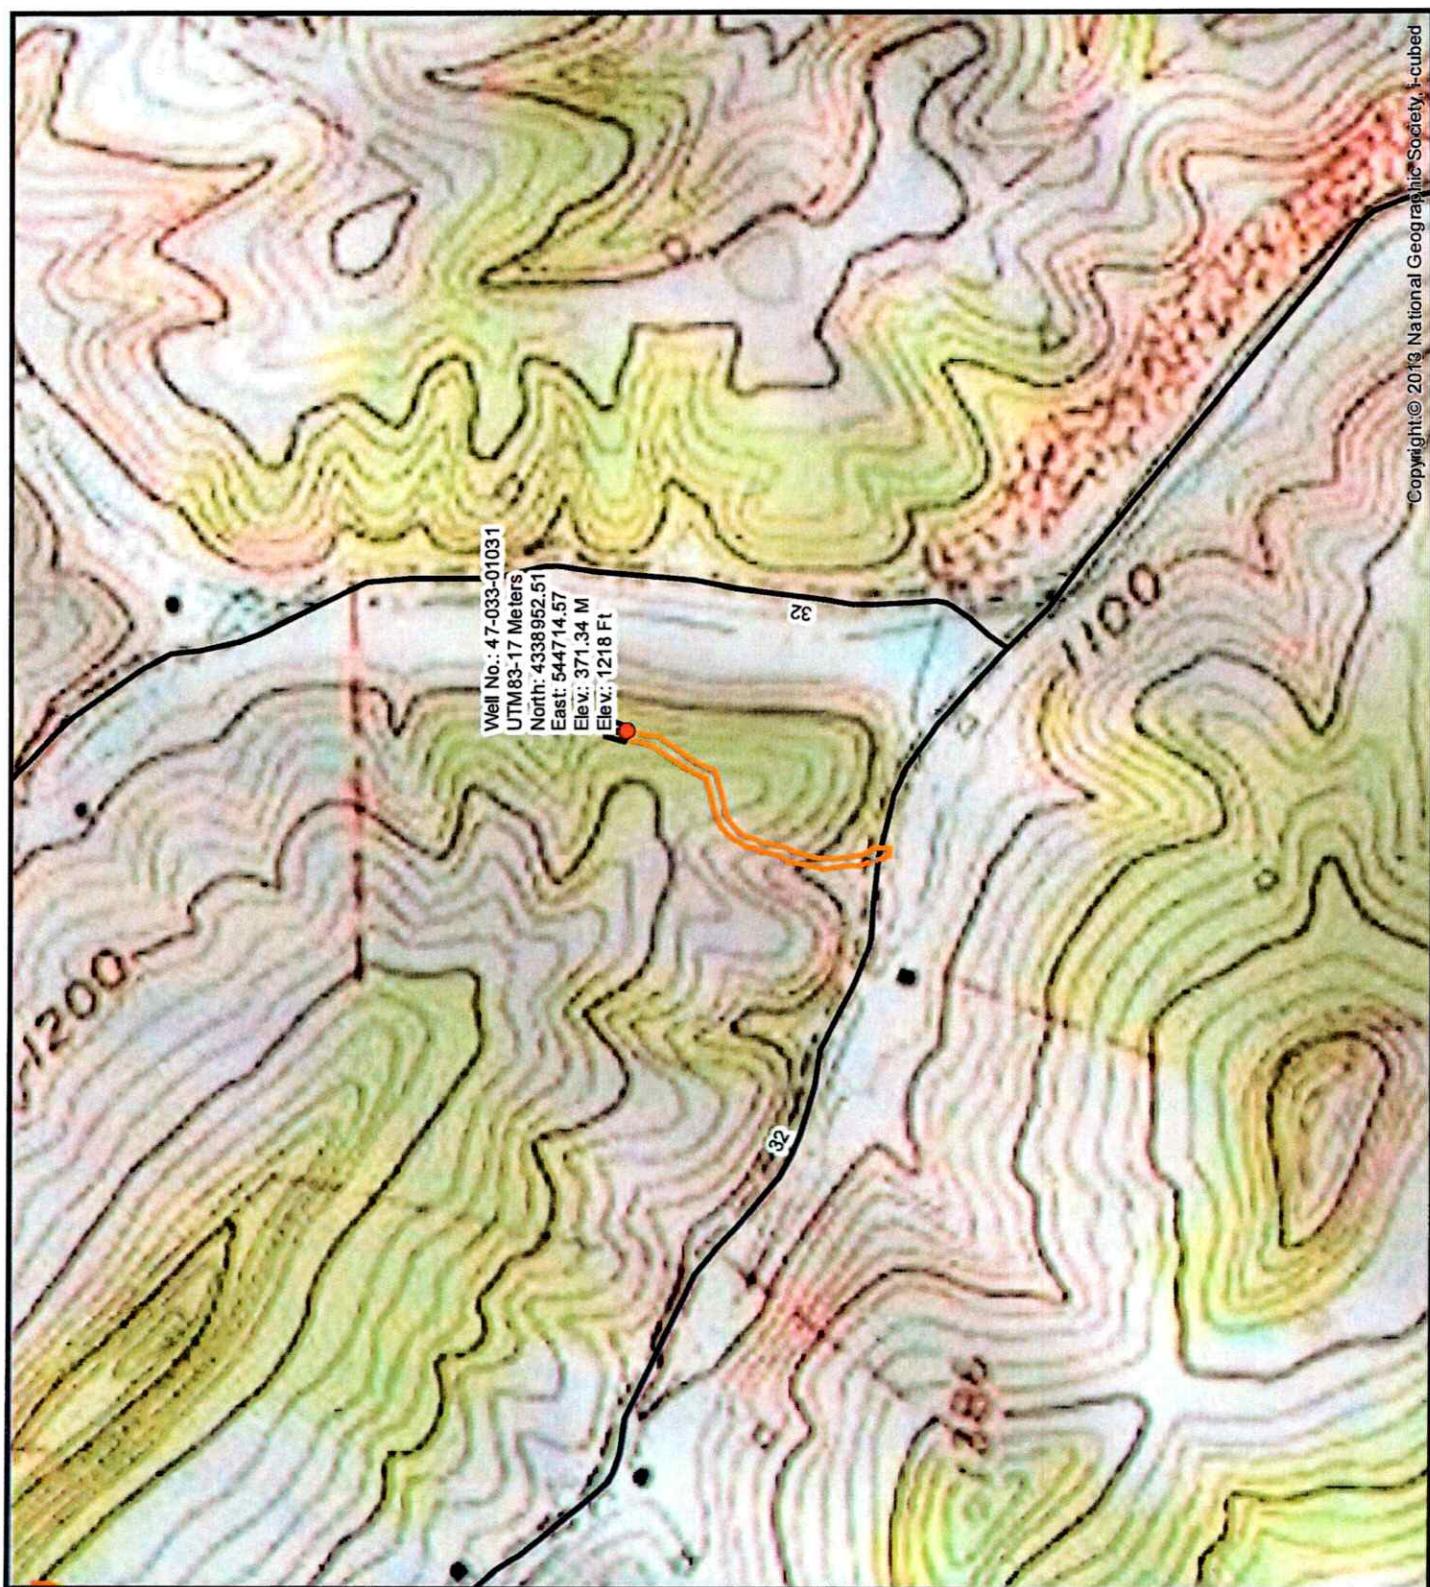

01/16/2026

Copyright © 2013 National Geographic Society. i-cubed

WW-7
8-30-06

RECEIVED
Office of Oil and Gas
JAN 6 2026
WV Department of
Environmental Protection



West Virginia Department of Environmental Protection
Office of Oil and Gas
WELL LOCATION FORM: GPS

API: 4703301031 WELL NO.: BROWN 1 WALDO

FARM NAME: Waldo Brown (QW & DE Wickenhofer)

RESPONSIBLE PARTY NAME: Diversified Production, LLC

COUNTY: Harrison DISTRICT: Union

QUADRANGLE: Weston 7.5'

SURFACE OWNER: Edwin L. Bowyer II & April D. Bowyer

ROYALTY OWNER: Ronald Brown, Diane Mayes, Jean E. King, John & Christine Snider, Melanie Alexander

UTM GPS NORTHING: 4338952.51

UTM GPS EASTING: 544714.57 GPS ELEVATION: 1218'

The Responsible Party named above has chosen to submit GPS coordinates in lieu of preparing a new well location plat for a plugging permit or assigned API number on the above well. The Office of Oil and Gas will not accept GPS coordinates that do not meet the following requirements:

1. Datum: NAD 1983, Zone: 17 North, Coordinate Units: meters, Altitude: height above mean sea level (MSL) – meters.
2. Accuracy to Datum – 3.05 meters
3. Data Collection Method:

Survey grade GPS : Post Processed Differential


Real-Time Differential

Mapping Grade GPS X : Post Processed Differential X

Real-Time Differential


4. Letter size copy of the topography map showing the well location.

I the undersigned, hereby certify this data is correct to the best of my knowledge and belief and shows all the information required by law and the regulations issued and prescribed by the Office of Oil and Gas.

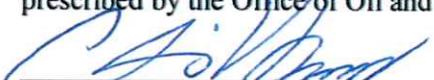
Signature

Chris Veazey - Director of Administration

Title

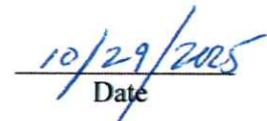
Date