

WW-7
8-30-06



West Virginia Department of Environmental Protection
Office of Oil and Gas
WELL LOCATION FORM: GPS

API: 47-085-03964 WELL NO.: WV 602434 (J. A. Thomas #2434)

FARM NAME: J. A. Thomas

RESPONSIBLE PARTY NAME: EQT Production Company

COUNTY: Ritchie DISTRICT: Clay

QUADRANGLE: Pennsboro 7.5'

SURFACE OWNER: Vernon C. Thomas

ROYALTY OWNER: Vernon C. Thomas

UTM GPS NORTHING: 4348812


UTM GPS EASTING: 508249 GPS ELEVATION: 279m (917ft)

The Responsible Party named above has chosen to submit GPS coordinates in lieu of preparing a new well location plat for a plugging permit or assigned API number on the above well. The Office of Oil and Gas will not accept GPS coordinates that do not meet the following requirements:

1. Datum: NAD 1983, Zone: 17 North, Coordinate Units: meters, Altitude: height above mean sea level (MSL) – meters.
2. Accuracy to Datum – 3.05 meters
3. Data Collection Method:
Survey grade GPS _____ : Post Processed Differential _____
Real-Time Differential _____
Mapping Grade GPS X : Post Processed Differential X
Real-Time Differential _____

4. **Letter size copy of the topography map showing the well location.**

I the undersigned, hereby certify this data is correct to the best of my knowledge and belief and shows all the information required by law and the regulations issued and prescribed by the Office of Oil and Gas.

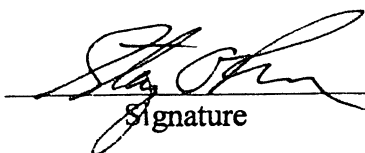
Signature

PS # 2180
Title

2/17/2020
Date

RECEIVED
Office of Oil and Gas
MAY 11 2020
WV Department of
Environmental Protection

Topo Quad: Pennsboro 7.5' Scale: 1" = 200'


County: Ritchie Date: February 17, 2020

District: Clay Project No: 68-38-00-08

47-085-03964 WV 602434 (J. A. Thomas #2434)

Topo

LOD Location Map

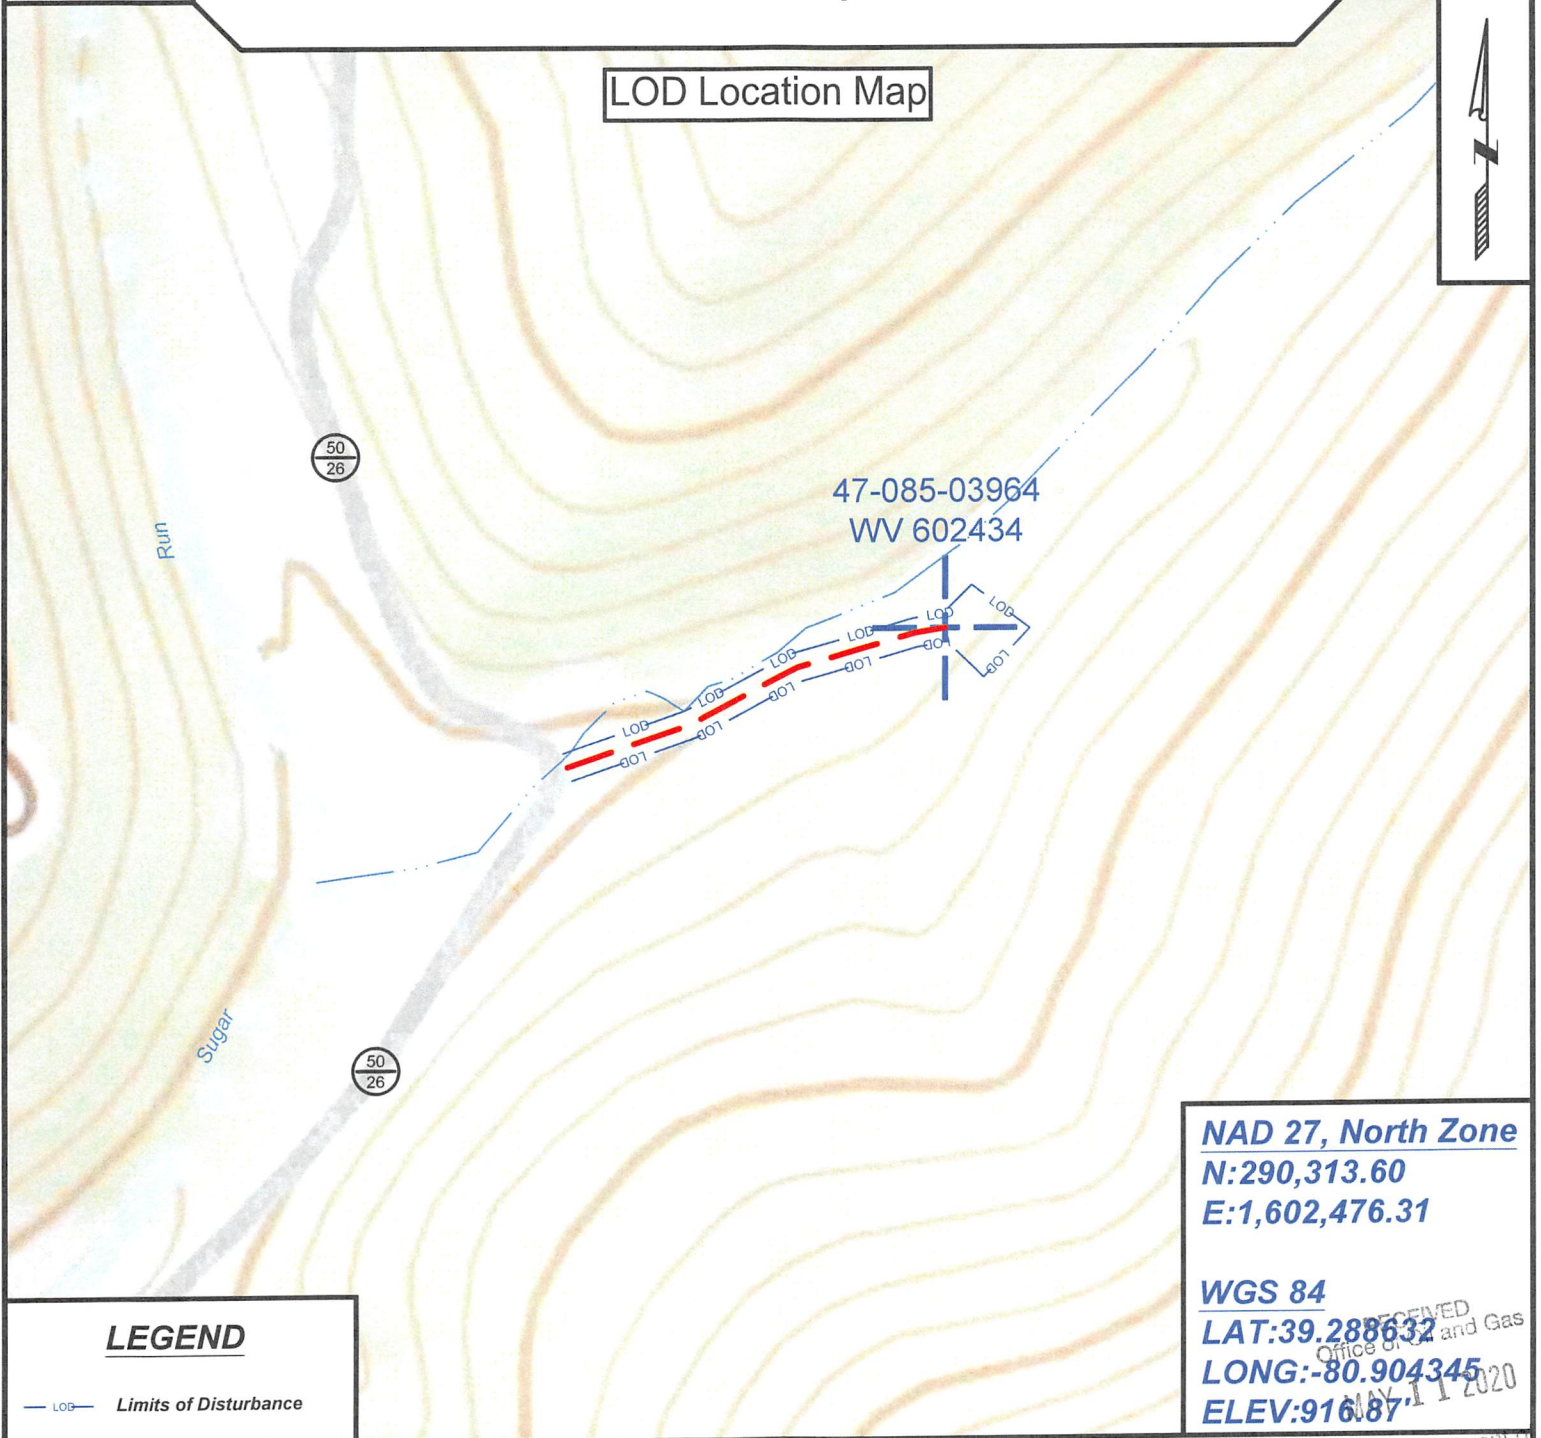

NAD 27, North Zone
N:290,313.60
E:1,602,476.31

WGS 84
LAT:39.288632
LONG:-80.904345
ELEV:916.87

RECEIVED
 Office of Land and Gas
 MAY 11 2020

LEGEND

— LOD — Limits of Disturbance



SURVEYING AND MAPPING SERVICES PERFORMED BY:
ALLEGHENY SURVEYS, INC.

1-800-482-8606
 237 Birch River Road
 Birch River, WV 26610
 PH: (304) 649-8606
 FAX: (304) 649-8608

PREPARED FOR:

EQT Production Company

400 Woodcliff Drive
 Canonsburg, PA 15317

WV Department of
 Environmental Protection

