

WW-7  
8-30-06



RECEIVED  
Office of Oil and Gas  
4703301264P  
AUG 04 2026  
WV Department of  
Environmental Protection

West Virginia Department of Environmental Protection  
Office of Oil and Gas  
**WELL LOCATION FORM: GPS**

API: 47-033-01264 WELL NO.: 182  
FARM NAME: B SMITH  
RESPONSIBLE PARTY NAME: Consol Gas Company  
COUNTY: Harrison DISTRICT: Sardis  
QUADRANGLE: Wallace  
SURFACE OWNER: Gary Scott & Ashley Dawn Marchiny  
ROYALTY OWNER: \_\_\_\_\_  
UTM GPS NORTHING: 4362993  
UTM GPS EASTING: 546191 GPS ELEVATION: 1060

The Responsible Party named above has chosen to submit GPS coordinates in lieu of preparing a new well location plat for a plugging permit or assigned API number on the above well. The Office of Oil and Gas will not accept GPS coordinates that do not meet the following requirements:

1. Datum: NAD 1983, Zone: 17 North, Coordinate Units: meters, Altitude: height above mean sea level (MSL) – meters.
2. Accuracy to Datum – 3.05 meters
3. Data Collection Method:

Survey grade GPS \_\_\_\_ : Post Processed Differential \_\_\_\_

Real-Time Differential \_\_\_\_

Mapping Grade GPS X : Post Processed Differential X

Real-Time Differential \_\_\_\_

4. **Letter size copy of the topography map showing the well location.**



I the undersigned, hereby certify this data is correct to the best of my knowledge and belief and shows all the information required by law and the regulations issued and prescribed by the Office of Oil and Gas.

[Signature]  
Signature

Project Manager  
Title

8-3-26  
Date  
**08/28/2026**

4703301264P

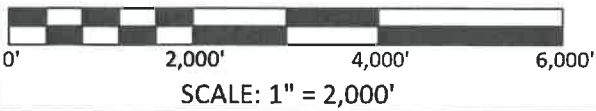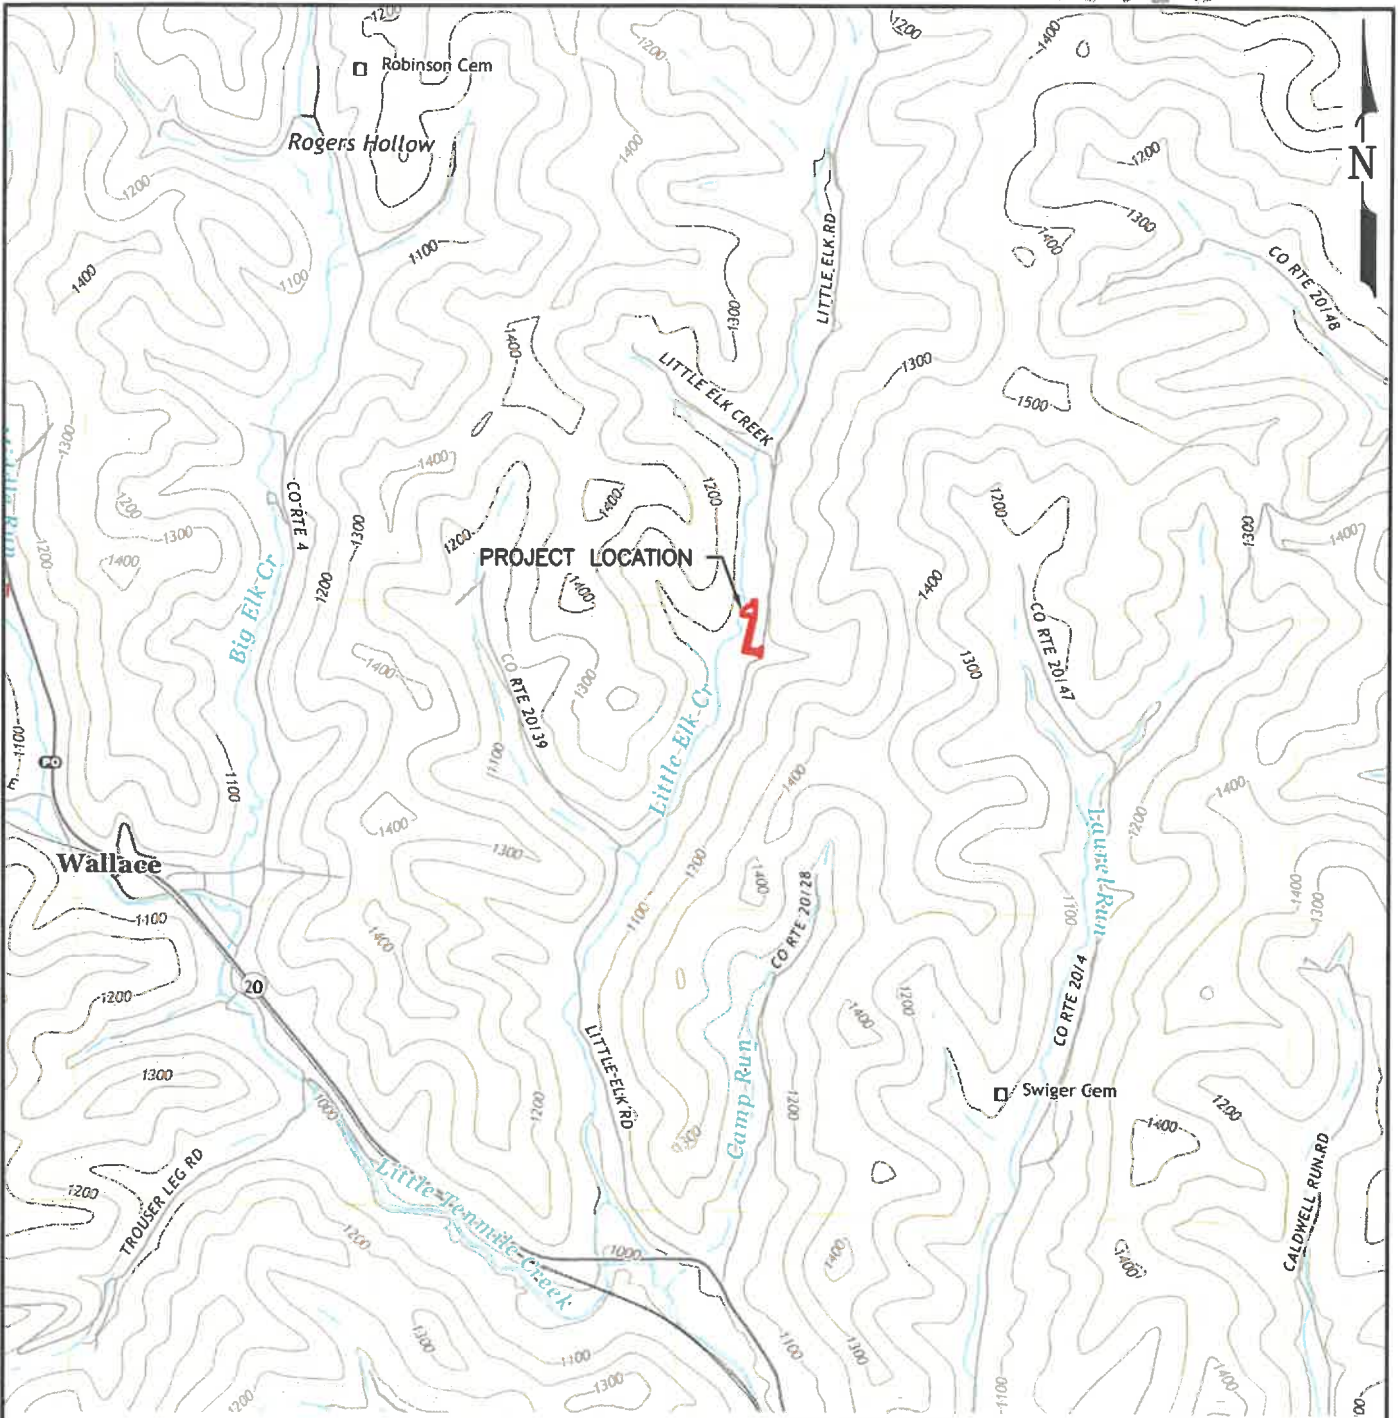

**REFERENCE:**

1. USGS 7.5 MIN. TOPOGRAPHIC QUADRANGLE  
WALLACE, WV, DATED 2019.



|             |           |
|-------------|-----------|
| DATE        | 6/4/2026  |
| DRAWN BY    | SDH       |
| CHECKED BY  | BLB       |
| APPROVED BY | ZMD       |
| SCALE       | 1"=2,000' |

CNX GAS COMPANY LLC  
API 47-033-01264 WELL PLUGGING  
SARDIS DISTRICT  
HARRISON COUNTY  
WEST VIRGINIA

**PROJECT LOCATION MAP**

SHEET 1 OF 1

08/28/2026

47-033-01264  
Well 182 B Smith Farm

Legend  
17 s 546191 4362993

17 s 546191 4362993

Google Earth  
Image © 2026 Airbus



50 m

20/3

08/28/2026