

WW-7
8-30-06

4703301404P



West Virginia Department of Environmental Protection
Office of Oil and Gas
WELL LOCATION FORM: GPS

API: 4703301404 WELL NO.: Bonnell M

FARM NAME: M. Bonnell

RESPONSIBLE PARTY NAME: Diversified Production, LLC

COUNTY: Harrison DISTRICT: Union Outside

QUADRANGLE: West Milford 7.5'

SURFACE OWNER: Samuel S. Stark

ROYALTY OWNER: Mary F. Hartshorn

UTM GPS NORTHING: 4340213.99

UTM GPS EASTING: 550784.94 GPS ELEVATION: 1174.18'

The Responsible Party named above has chosen to submit GPS coordinates in lieu of preparing a new well location plat for a plugging permit or assigned API number on the above well. The Office of Oil and Gas will not accept GPS coordinates that do not meet the following requirements:

- Datum: NAD 1983, Zone: 17 North, Coordinate Units: meters, Altitude: height above mean sea level (MSL) – meters.
- Accuracy to Datum – 3.05 meters
- Data Collection Method:

Survey grade GPS : Post Processed Differential

Real-Time Differential

Mapping Grade GPS : Post Processed Differential

Real-Time Differential

- Letter size copy of the topography map showing the well location.**

I the undersigned, hereby certify this data is correct to the best of my knowledge and belief and shows all the information required by law and the regulations issued and prescribed by the Office of Oil and Gas.

Chris Veazey
Signature

Chris Veazey - Director of Administration
Title

02/08/24
Date

RECEIVED
Office of Oil & Gas

FEB 20 2024

WV Department of
Environmental Protection

03/01/2024

4703301404 P



Diversified Gas & Oil Corporation
100 Diversified Way
Pikeville KY, 41051

47-033-01404



Plugging Map

Legend

- Well
- Access Road
- ▨ Pits
- Pad
- Public Roads

RECEIVED
Office of Oil & Gas
FEB 20 2024

WV Department of
Environmental Protection

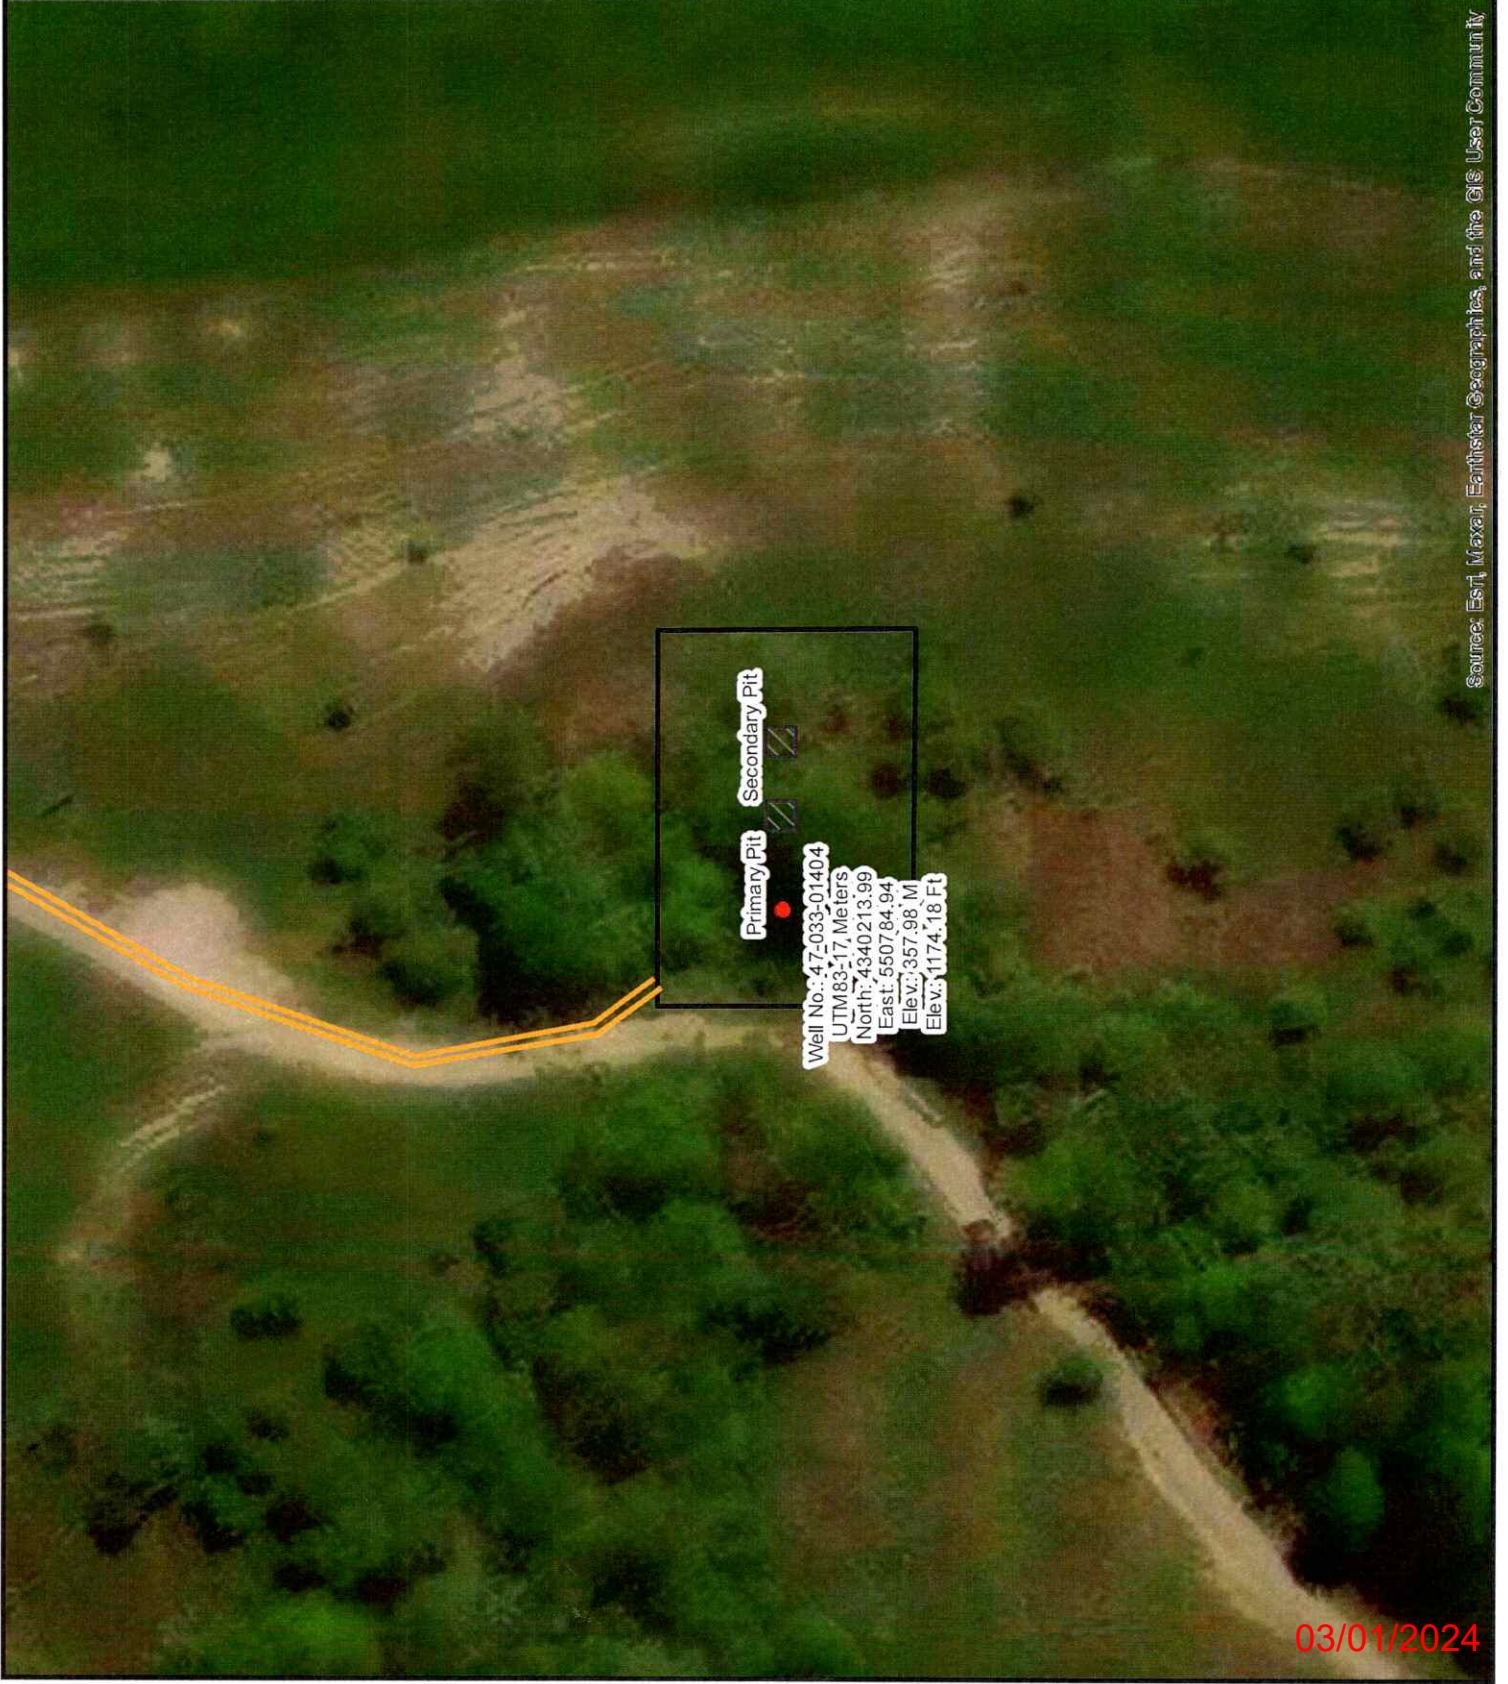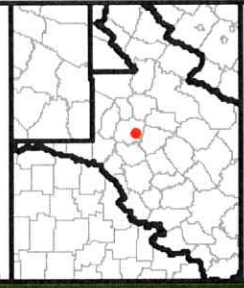

Primary Pit Secondary Pit

Well No.: 47-033-01404
UTM83: 17, Meters
North: 4340213.99
East: 550784.94
Elev.: 357.98 M
Elev.: 1174.18 Ft

Source: Esri, Maxar, Earthstar Geographics, and the GIS User Community

03/01/2024