

WW-7
5-02



West Virginia Department of Environmental Protection
Office of Oil and Gas
WELL LOCATION FORM: GPS

API: 47-033-01455 WELL NO.: 7285
FARM NAME: FAIRMONT COAL COMPANY
RESPONSIBLE PARTY NAME: CNX GAS COMPANY LLC
COUNTY: HARRISON DISTRICT: COAL
QUADRANGLE: WOLF SUMMIT
SURFACE OWNER: RANDALL L. NUTTER
ROYALTY OWNER: CNX GAS COMPANY LLC
UTM GPS NORTHING: 4,351,242.56 METERS
UTM GPS EASTING: 552,511.24 METERS GPS ELEVATION: 390.68 METERS (1281.4')

The Responsible Party named above has chosen to submit GPS coordinates in lieu of preparing a new well location plat for a plugging permit on the above well. The Office of Oil and Gas will not accept GPS coordinates that do not meet the following requirements:


- 1. Datum: NAD 1983, Zone: 17 Coordinate Units: meters Altitude: Height above mean sea level (MSL) - meters
- 2. Accuracy to Datum - 3.05 meters
- 3. Data Collection Method: Survey Grade GPS ____ : Post Processed Differential ____ Real-Time Differential ____
Mapping Grade GPS X : Post Processed Differential ____ Real-Time Differential X

I the undersigned hereby state this data is correct to the best of my knowledge and belief and shows all the information required by law and the regulation issued and prescribed by the Office of Oil and Gas.

Signature [Signature]
Stephen D. Losh, PS #674


Title WV Professional Surveyor #674

Date 11/13/14

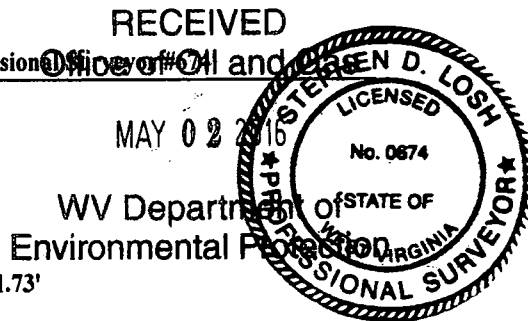

CNX USE: NAD 27 WV NORTH SPC: 7285 = 295,866.40' 1,747,854.56' ELEV. = 1281.73'

06/10/2016

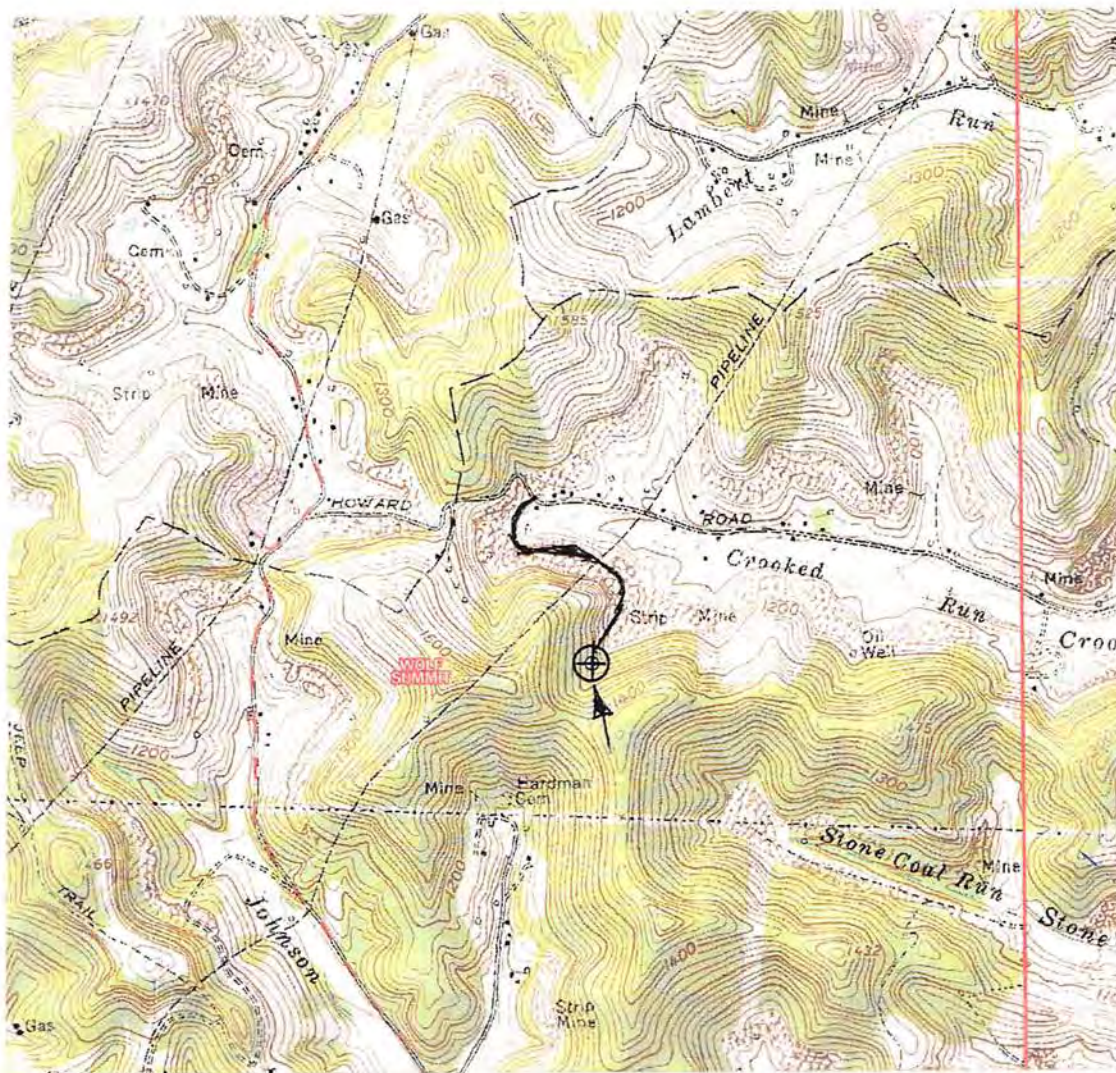

SDW
4/11/16

DRAWINGS TO ACCOMPANY FORM WW-9	
CNX GAS COMPANY LLC	
P. O. BOX 1248	
JANE LEW, WV 26378	
WATERSHED:	CROOKED RUN
DISTRICT:	COAL
COUNTY:	HARRISON
QUADRANGLE:	WOLF SUMMIT
DATE:	11/13/14

RECEIVED
Office of Oil and Gas
MAY 02 2016
WV Department of
Environmental Protection

LAND SURVEYING SERVICES
21 CEDAR LANE
BRIDGEPORT, WV 26330
PHONE: 304-842-2018 OR 5762