



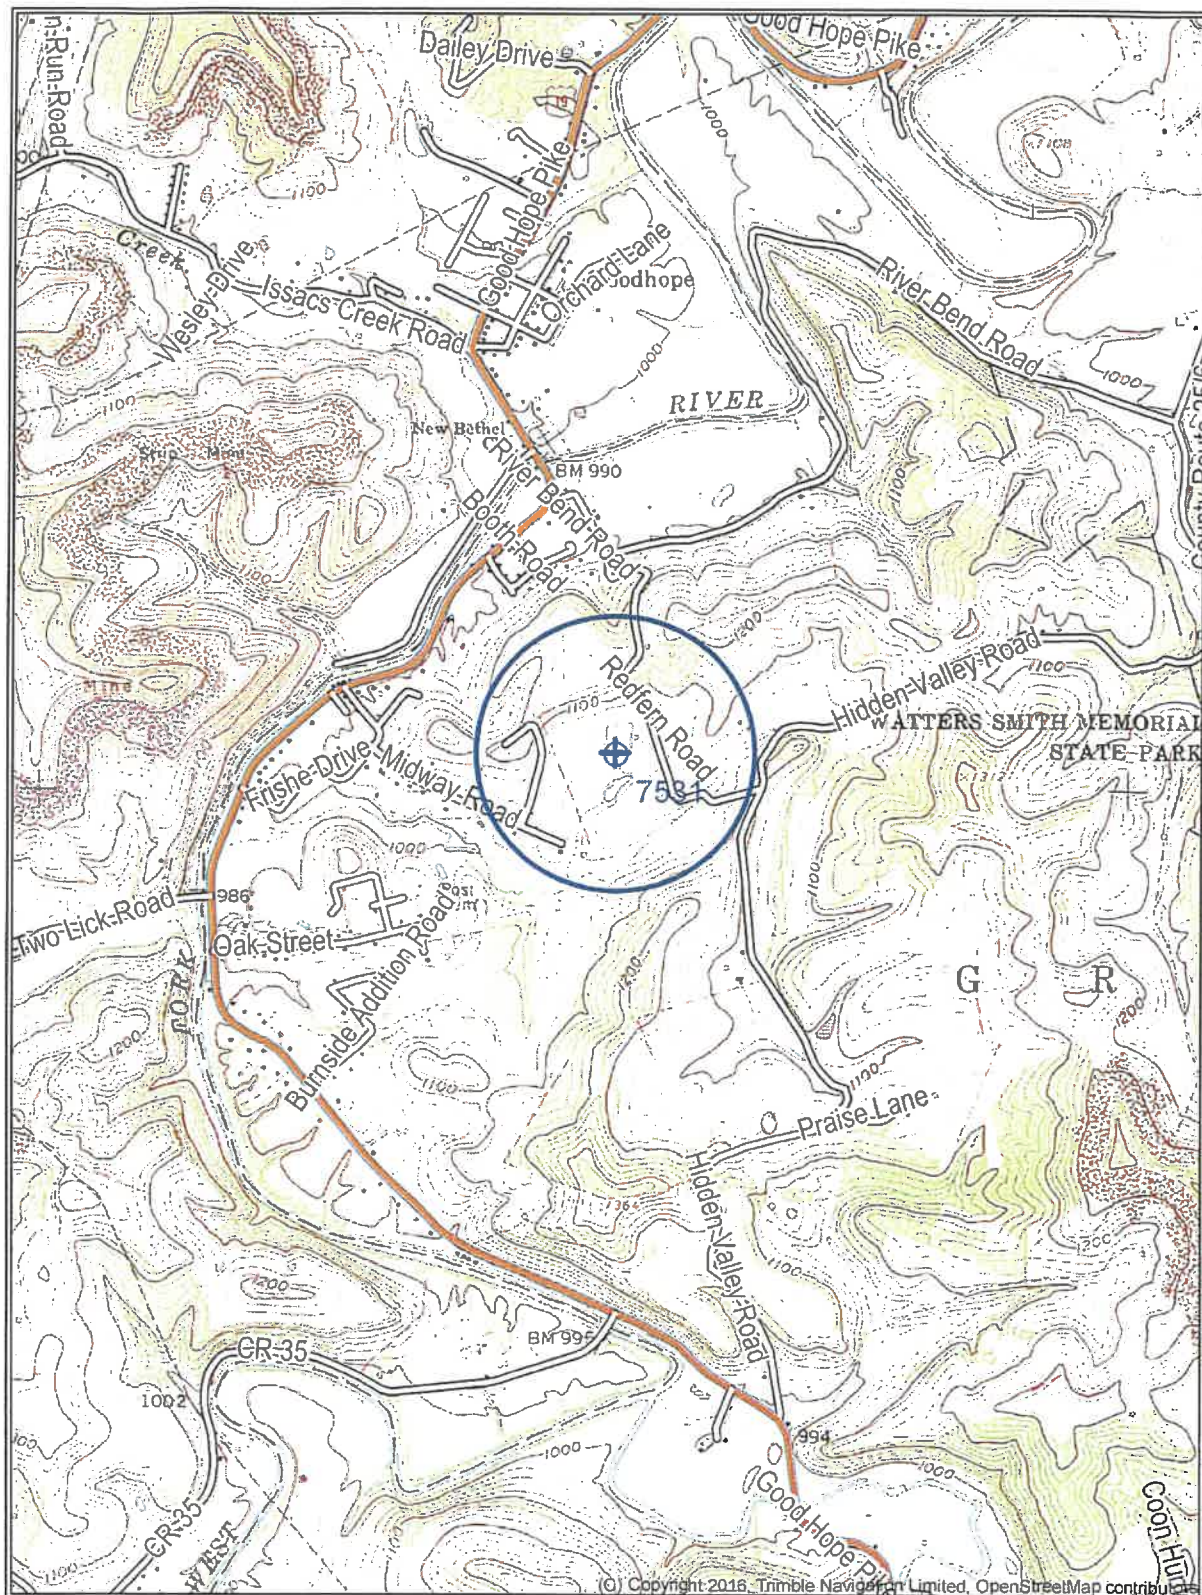

RECEIVED
Office of Oil and Gas
JUN 01 2026
WV Department of
Environmental Protection

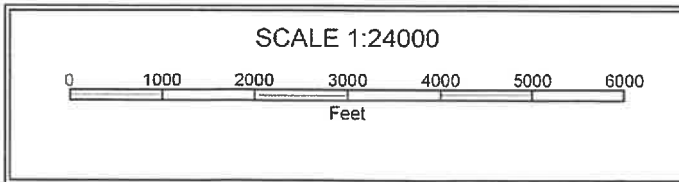

06/26/2026

WW-7
8-30-06



West Virginia Department of Environmental Protection
Office of Oil and Gas

WELL LOCATION FORM: GPS

API: 47-033-01488 WELL NO.: 7531
FARM NAME: BURNSIDE
RESPONSIBLE PARTY NAME: EASTERN GAS TRANSMISSION & STORAGE
COUNTY: HARRISON DISTRICT: GRANT-OUTSIDE
QUADRANGLE: WEST MILFORD
SURFACE OWNER: CATHY LOUISE BURNSIDE
ROYALTY OWNER: JR Garrett II, Mark V. Schumacher, Kristin Messenger, Claude J. Ryan III
UTM GPS NORTHING: 4335537
UTM GPS EASTING: 470548721 GPS ELEVATION: 1050'

The Responsible Party named above has chosen to submit GPS coordinates in lieu of preparing a new well location plat for a plugging permit or assigned API number on the above well. The Office of Oil and Gas will not accept GPS coordinates that do not meet the following requirements:

1. Datum: NAD 1983, Zone: 17 North, Coordinate Units: meters, Altitude: height above mean sea level (MSL) – meters.
2. Accuracy to Datum – 3.05 meters
3. Data Collection Method:

Survey grade GPS ____: Post Processed Differential ____

Real-Time Differential ____

Mapping Grade GPS X: Post Processed Differential ____

Real-Time Differential ____

4. **Letter size copy of the topography map showing the well location.**

I the undersigned, hereby certify this data is correct to the best of my knowledge and belief and shows all the information required by law and the regulations issued and prescribed by the Office of Oil and Gas.

Signature

Title

Date

RECEIVED
Office of Oil and Gas
JUN 01 2026
WV Department of
Environmental Protection

06/26/2026