


GRID NORTH
W.V. NORTH, NAD83 DATUM, US FT

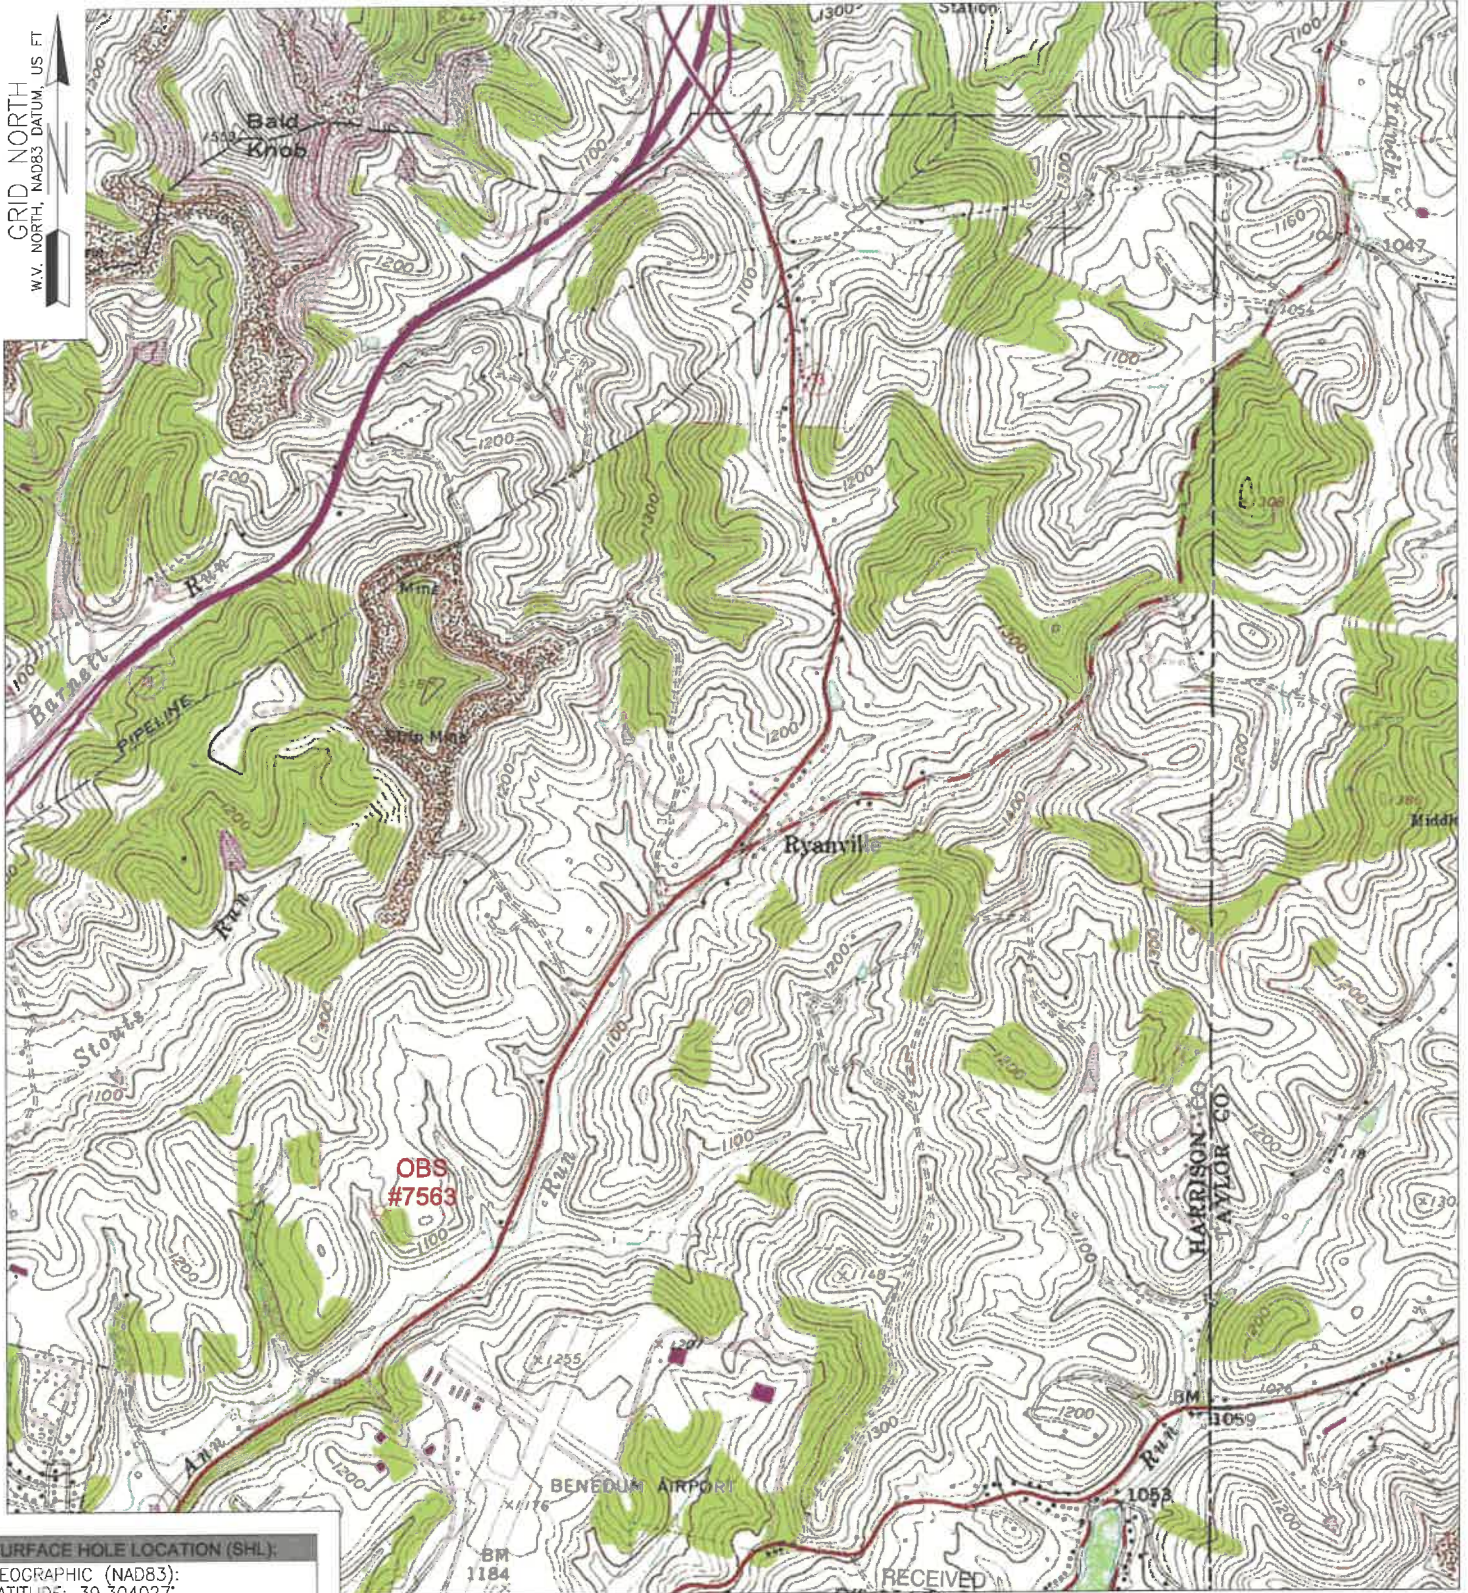

SURFACE HOLE LOCATION (SHL):
 GEOGRAPHIC (NAD83):
 LATITUDE: 39.304027°
 LONGITUDE: -80.234238°
 UTM (NAD83, ZONE 17, FEET):
 NORTHING: 14,274,233.662
 EASTING: 1,857,031.521
 UTM (NAD83, ZONE 17, METERS):
 NORTHING: 4,350,795.122
 EASTING: 566,024.340

RECEIVED
Office of Oil and Gas
2000 0 2000
JUN 12 2023
GRAPHIC SCALE IN FEET

WELL OPERATOR: Eastern Gas Transmission and Storage, Inc.	WELL (FARM) NAME: GAWTHROP, CORNELIA	WELL # 7563	SERIAL #
ADDRESS: 925 White Oaks Blvd., Bridgeport, WV 26330	COUNTY - CODE HARRISON - 33	DISTRICT; SIMPSON BRIDGEPORT CORP.	
SURFACE OWNER: GAWTHROP, CORNELIA	USGS 7 1/2 QUADRANGLE MAP NAME WEST MILFORD	API: 47-033-01492	

WW-7
8-30-06

4703301492P



West Virginia Department of Environmental Protection
Office of Oil and Gas

WELL LOCATION FORM: GPS

API: 47-033-01492 WELL NO.: 7563

FARM NAME: Gawthrop, Cornelia

RESPONSIBLE PARTY NAME: Eastern Gas Transmission and Storage, Inc.

COUNTY: Harrison DISTRICT: Simpson Bridgeport Corp.

QUADRANGLE: West Milford

SURFACE OWNER: BRIDGEPORT MUNICIPAL BUILDING COMMISSION

ROYALTY OWNER: Five-J Energy, Inc., The Leon B. Davis and Ruth G. Davis Revocable Trust, Betty Y. Gawthrop Testamentary Trust, Asa Gawthrop, & Karen Lynn Gibson

UTM GPS NORTHING: 4,350,795.122

UTM GPS EASTING: 566,024.340 GPS ELEVATION: 1088.26'

The Responsible Party named above has chosen to submit GPS coordinates in lieu of preparing a new well location plat for a plugging permit or assigned API number on the above well. The Office of Oil and Gas will not accept GPS coordinates that do not meet the following requirements:

1. Datum: NAD 1983, Zone: 17 North, Coordinate Units: meters, Altitude: height above mean sea level (MSL) – meters.
2. Accuracy to Datum – 3.05 meters
3. Data Collection Method:

Survey grade GPS : Post Processed Differential _____
Real-Time Differential

Mapping Grade GPS _____ : Post Processed Differential _____
Real-Time Differential _____

4. Letter size copy of the topography map showing the well location.

I the undersigned, hereby certify this data is correct to the best of my knowledge and belief and shows all the information required by law and the regulations issued and prescribed by the Office of Oil and Gas.

Michael R. Hyman
Digitally signed by Michael R. Hyman
Date: 2023.04.28 09:43:51 -04'00'
Signature

Surveyor
Title

4-28-2023
Date

RECEIVED
Office of Oil and Gas
JUN 12 2023
WV Department of
Environmental Protection

06/30/2023