

WW-7
8-30-06



West Virginia Department of Environmental Protection
Office of Oil and Gas
WELL LOCATION FORM: GPS

API: 47-033-01666 WELL NO.: WV 604260 (Figott #4260)

FARM NAME: L. M. Figott

RESPONSIBLE PARTY NAME: EOT Production Company

COUNTY: Harrison DISTRICT: Eagle-Outside

QUADRANGLE: Shimston 7.5'

SURFACE OWNER: Diane Moran and William D. Poling

ROYALTY OWNER: Diane Moran and William D. Poling

UTM GPS NORTHING: 4361828

UTM GPS EASTING: 556508 GPS ELEVATION: 332 m (1091 ft)

The Responsible Party named above has chosen to submit GPS coordinates in lieu of preparing a new well location plat for a plugging permit or assigned API number on the above well. The Office of Oil and Gas will not accept GPS coordinates that do not meet the following requirements:

1. Datum: NAD 1983, Zone: 17 North, Coordinate Units: meters, Altitude: height above mean sea level (MSL) – meters.
2. Accuracy to Datum – 3.05 meters
3. Data Collection Method:
Survey grade GPS _____ : Post Processed Differential _____
Real-Time Differential _____
Mapping Grade GPS X : Post Processed Differential X
Real-Time Differential _____

4. Letter size copy of the topography map showing the well location.

I the undersigned, hereby certify this data is correct to the best of my knowledge and belief and shows all the information required by law and the regulations issued and prescribed by the Office of Oil and Gas.


Signature

PS#2180
Title

11/2/18
Date

Topo Quad: Shinnston 7.5'

Scale: 1" = 2000'

County: Harrison


Date: November 2, 2018

District: Eagle-Outside

Project No: 70-36-00-08

47-033-01666 WV 604260 (Pigott #4260)

Topo

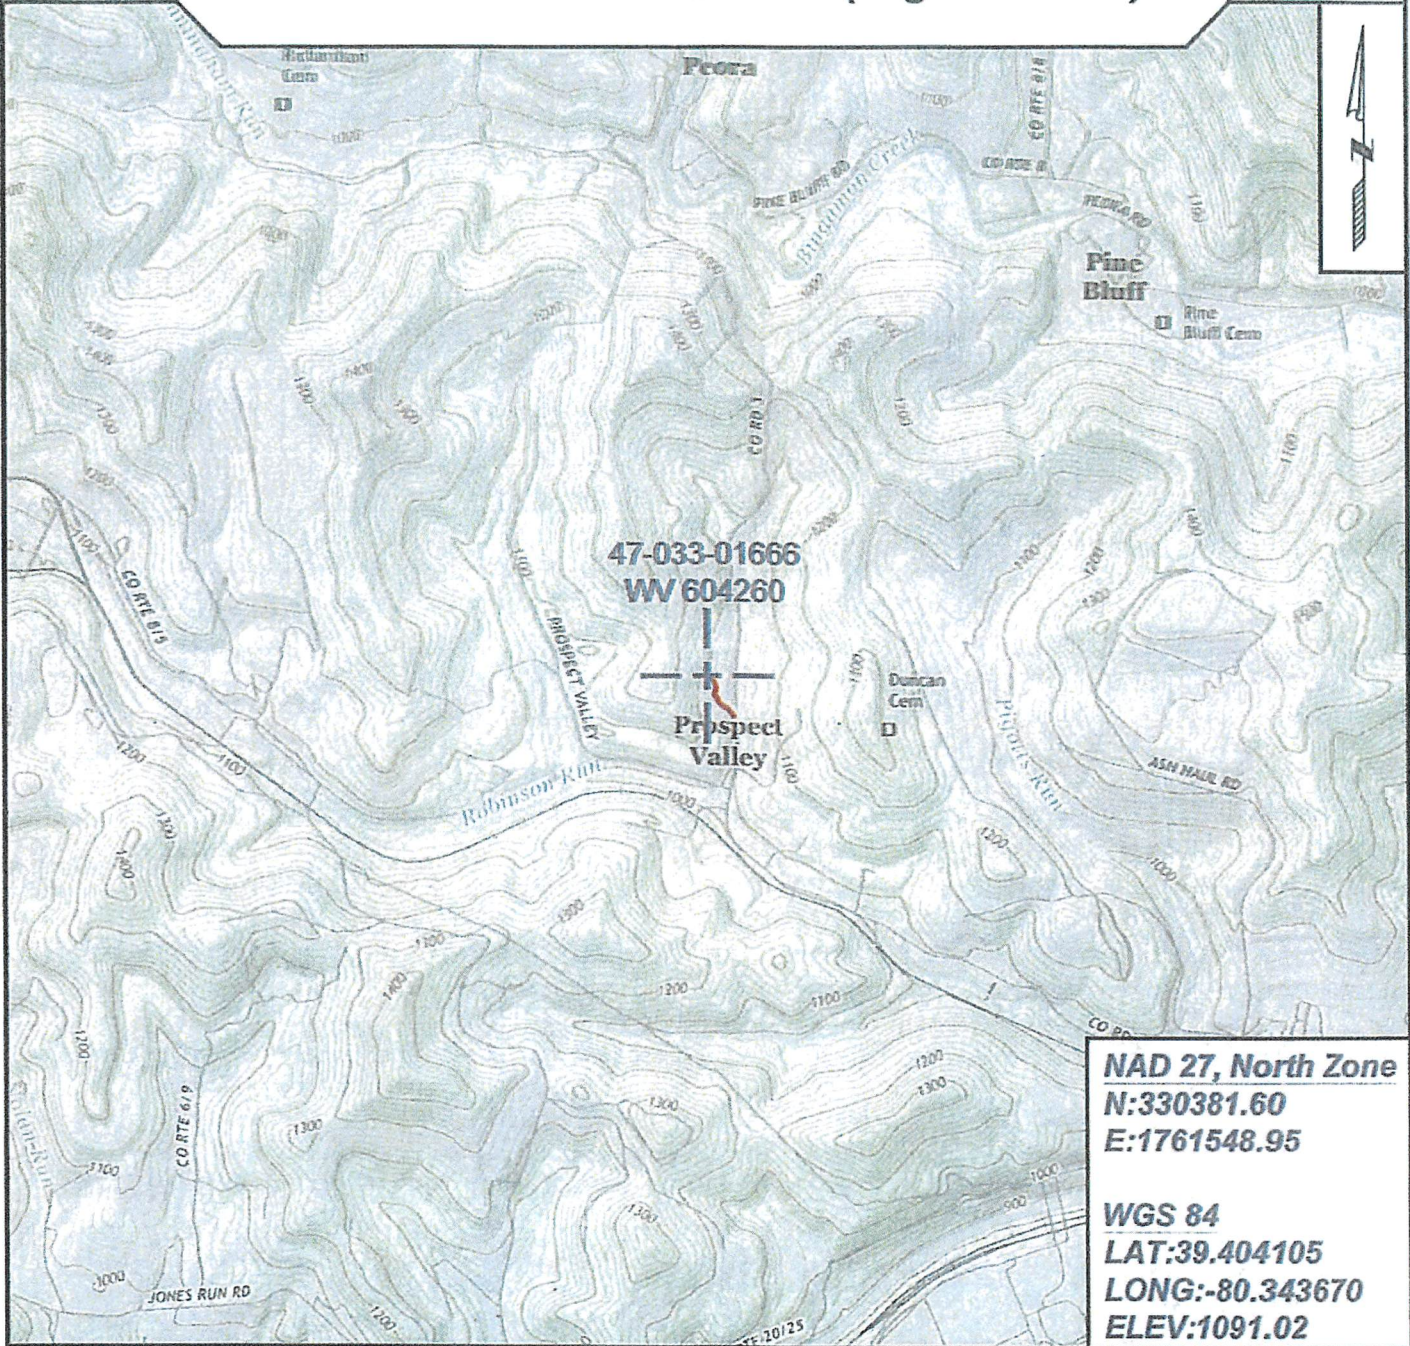

NAD 27, North Zone
N:330381.60
E:1761548.95

WGS 84
LAT:39.404105
LONG:-80.343670
ELEV:1091.02



SURVEYING AND MAPPING SERVICES PERFORMED BY:
ALLEGHENY SURVEYS, INC.
 1-800-482-8606
 237 Birch River Road
 Birch River, WV 26610
 PH: (304) 649-8606
 FAX: (304) 649-8608

PREPARED FOR:
EQT Production Company
 2400 Ansys Drive
 Canonsburg, PA 15317