

RECEIVED
Office of Oil & Gas

MAR 19 2012

WV Department of
Environmental Protection

West Virginia Department of Environmental Protection
Office of Oil & Gas

WELL LOCATION FORM: GPS

API: 47- 033 1805 P WELL NO: No. 2

FARM NAME: B.F Nuzum

RESPONSIBLE PARTY NAME: East Resources, Inc.

COUNTY: Harrison DISTRICT: Clay

QUADRANGLE: Fairmont West 7.5'

SURFACE OWNER: Ronald & Grace Gough NA

ROYALTY OWNER: East Resources, Inc. et al.

UTM GPS NORTHING: 4,360,573 (NAD 83)

UTM GPS EASTING: 567,662 (NAD 83) GPS ELEVATION: 103 m.

The Responsible Party named above has chosen to submit GPS coordinates in lieu of preparing a new well location plat for a plugging permit on the above well. The Office of Oil & Gas will not accept GPS coordinates that do not meet the following requirements:

1. Datum: NAD 1983, Zone:17 North, Coordinate Units: meters, Altitude: height above mean sea level (MSL) - meters.
2. Accuracy to Datum - 3.05 meters
3. Data Collection Method:

Survey Grade GPS	<input type="checkbox"/> Post Processed Differential	<input type="checkbox"/>
	<input type="checkbox"/> Real-Time Differential	<input type="checkbox"/>
Mapping Grade GPS	<input checked="" type="checkbox"/> Post Processed Differential	<input checked="" type="checkbox"/>
	<input type="checkbox"/> Real-Time Differential	<input type="checkbox"/>

I the undersigned, hereby certify this data is correct to the best of my knowledge and belief and shows all the information required by law and the regulations issued and prescribed by the Office of Oil and Gas.


Diane C White Diane C White

Accountant
Title

March 8, 2012
Date

SUBJECT WELL
B.F. Nuzum No. 2
47-033-1805

33-01805P

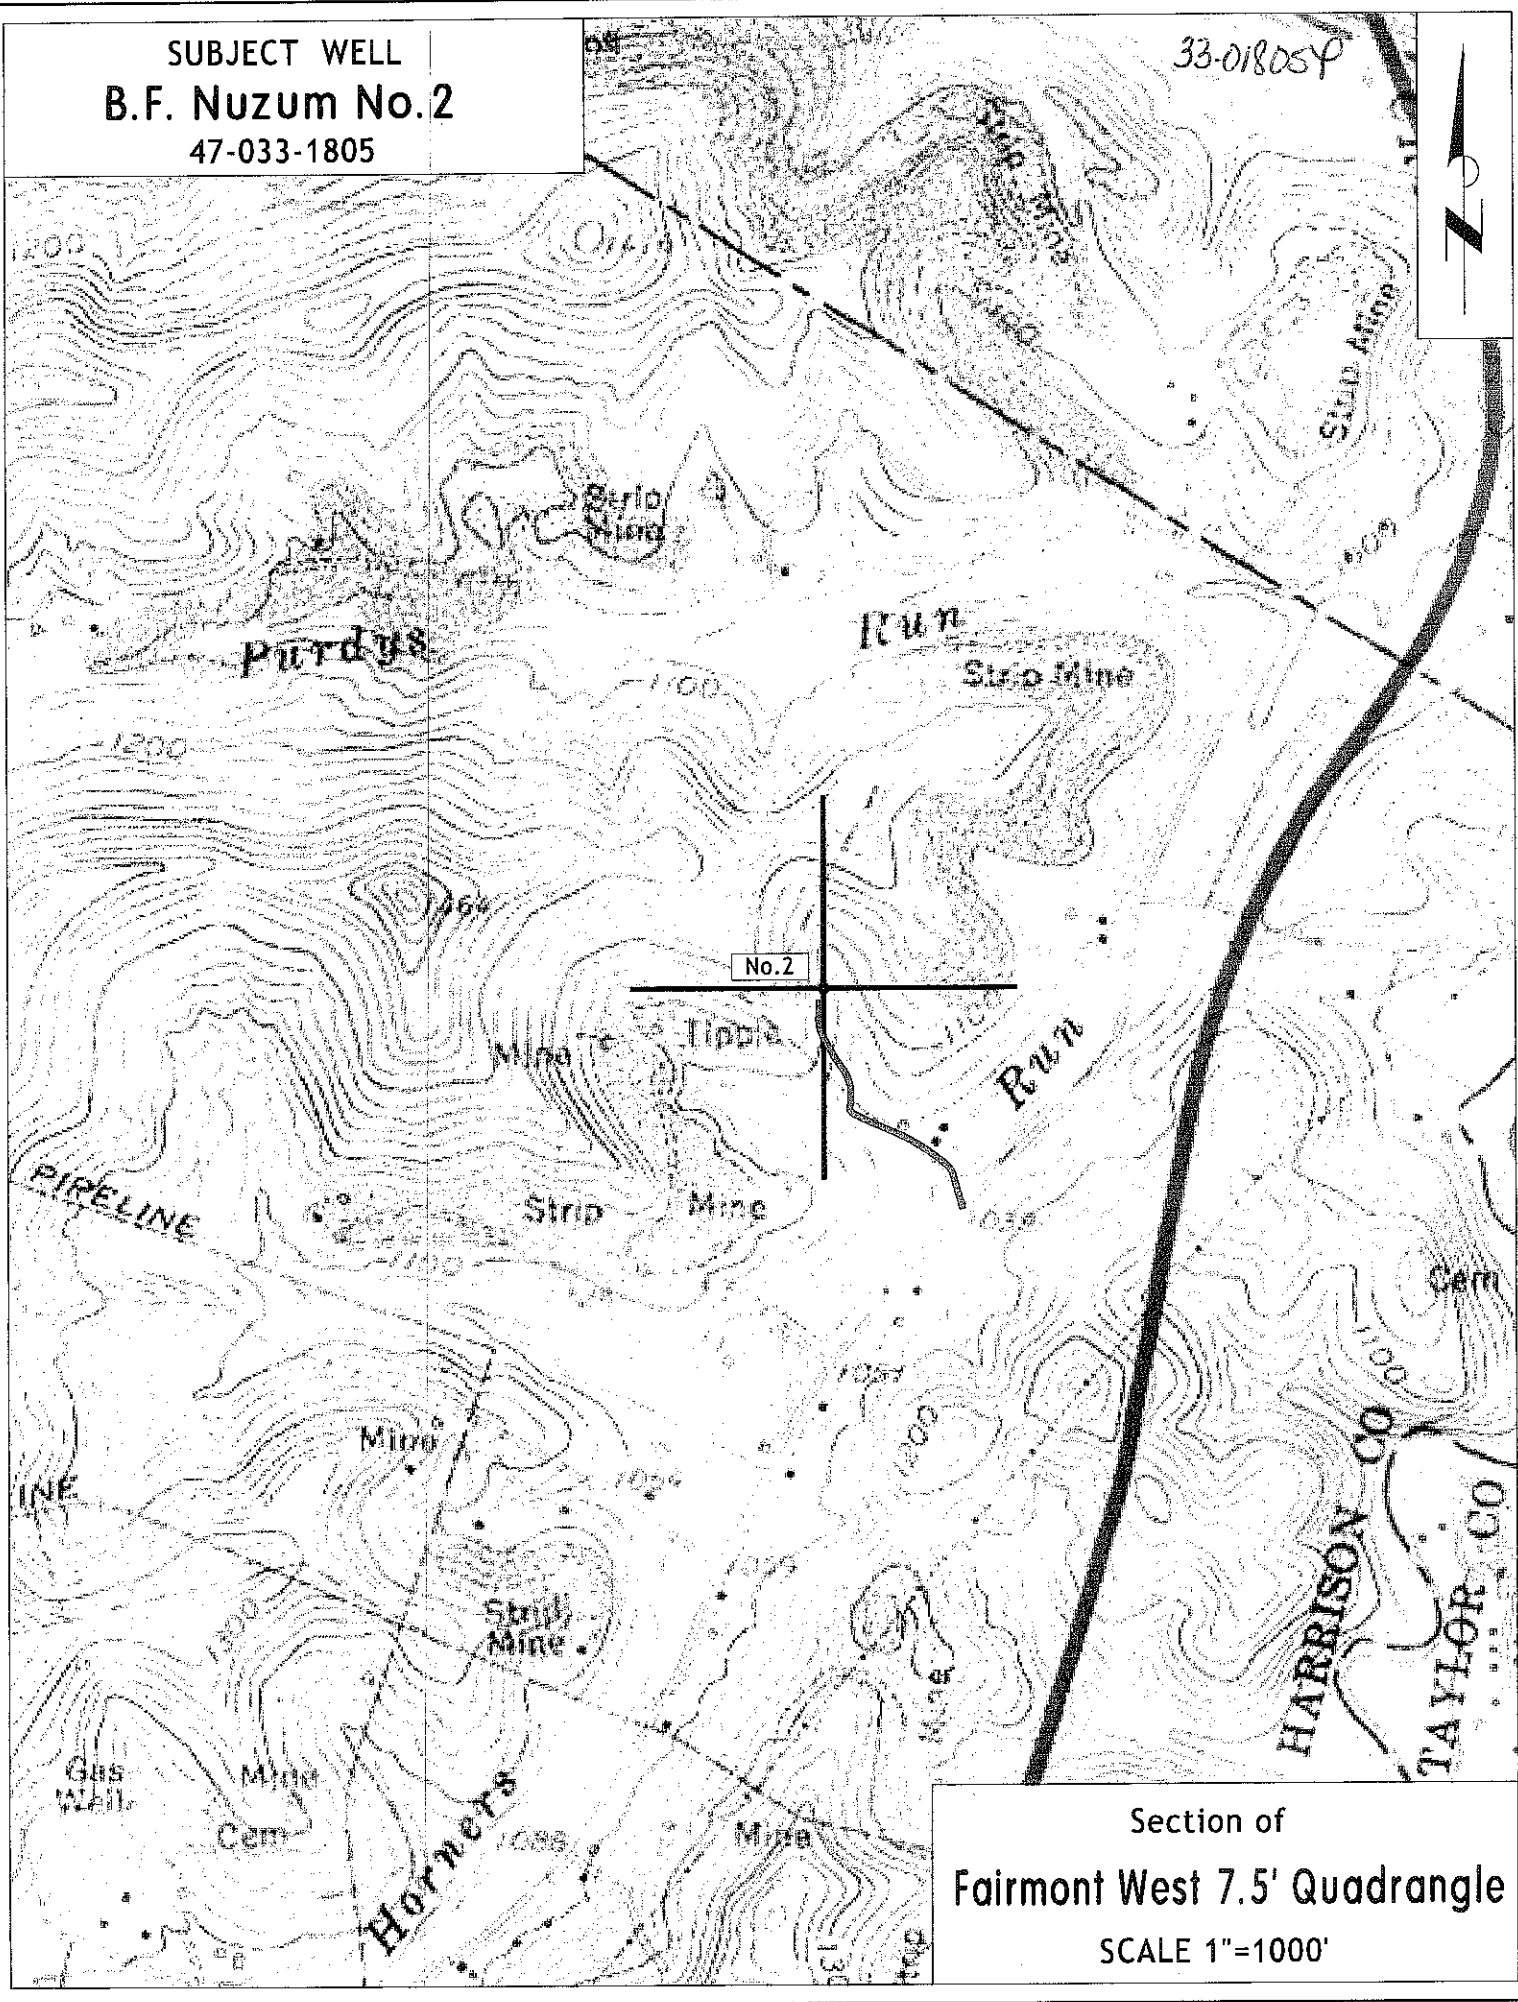

Section of
Fairmont West 7.5' Quadrangle
SCALE 1"=1000'