

✓ LATITUDE 39° 27' 30".

0.135

0.24W

80° 30' 00"

LONGITUDE

7'5 OGIS topo location -

7.5' loc 0.135  
0.24W

15' loc 3.015  
(calc.) 0.24W

Company Pennycuik 3

Farm Harriet Talkington

Centerpoint (NE) 15'


Quad Tolson 7.5'

County Harrison

District Sards

WELL LOCATION MAP

File No. 033-1846

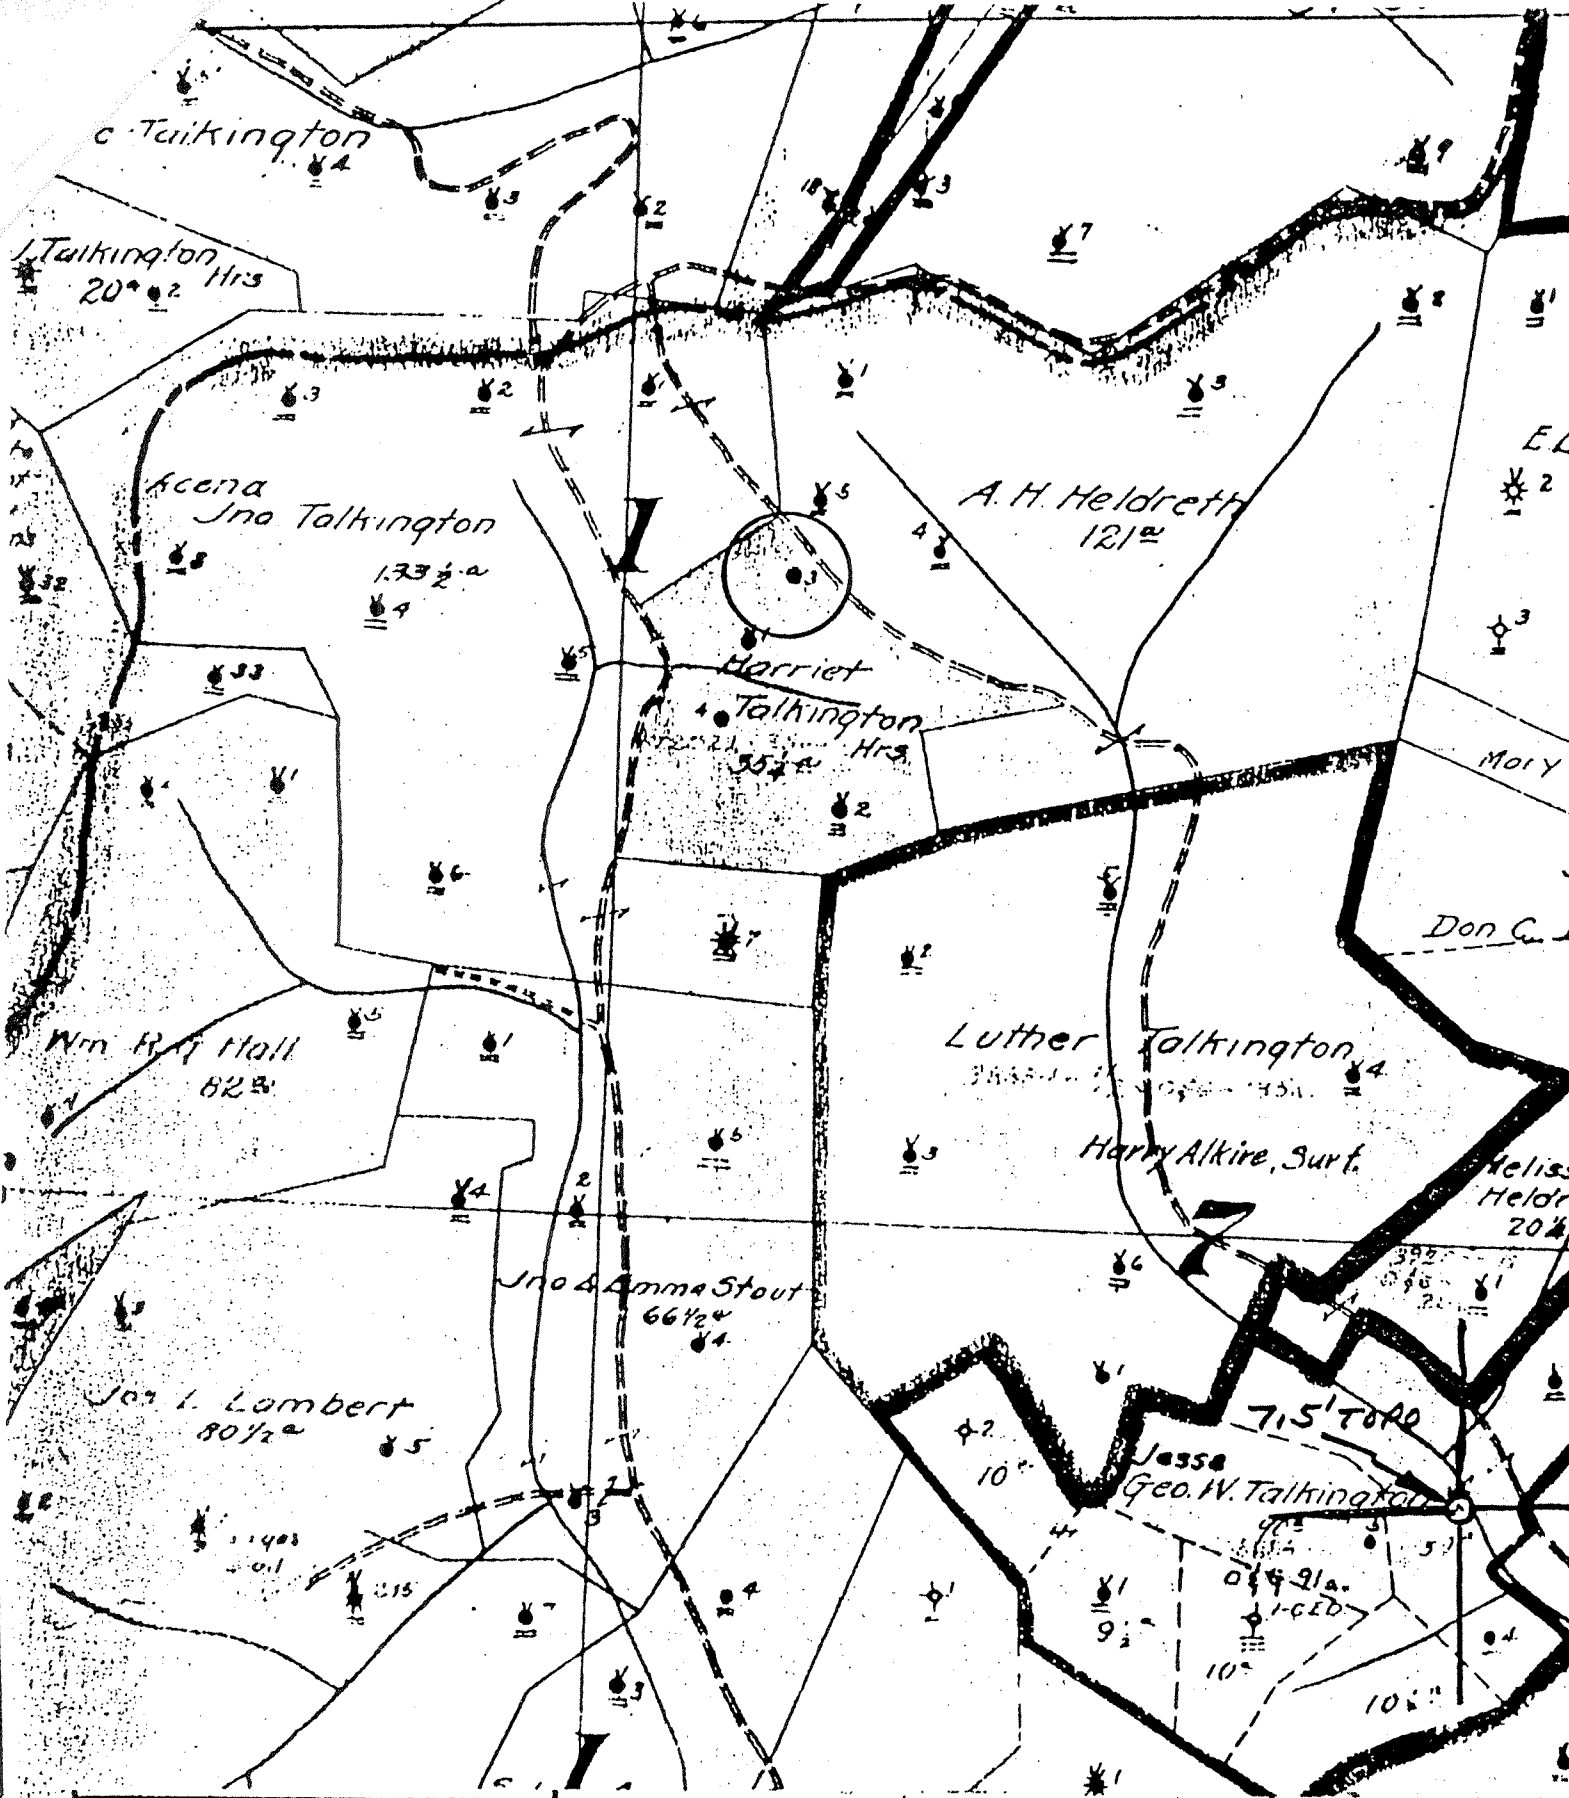

(+) DENOTES LOCATION OF WELL ON UNITED STATES TOPOGRAPHIC MAPS

FORM IV-6  
(8-78)  
**N49 N1 E7**



STATE OF WEST VIRGINIA  
DEPARTMENT OF MINES  
OIL AND GAS DIVISION

DATE 1-9-1979  
OPERATOR'S WELL NO. 3  
API WELL NO. 47-033-1846  
STATE COUNTY PERMIT

WELL TYPE: OIL  GAS  LIQUID INJECTION  WASTE DISPOSAL   
( IF "GAS", PRODUCTION  STORAGE  DEEP  SHALLOW   
LOCATION: ELEVATION \_\_\_\_\_ WATER SHED MIDDLE RUN  
DISTRICT SARDIS COUNTY HARRISON  
QUADRANGLE FOLSOM 7.5'

SURFACE OWNER \_\_\_\_\_ ACREAGE \_\_\_\_\_  
OIL & GAS ROYALTY OWNER \_\_\_\_\_ LEASE ACREAGE \_\_\_\_\_  
LEASE NO. \_\_\_\_\_

PROPOSED WORK: DRILL  CONVERT  DRILL DEEPER  REDRILL  FRACTURE OR STIMULATE  PLUS OFF OLD FORMATION  PERFORATE NEW FORMATION  OTHER PHYSICAL CHANGE IN WELL (SPECIFY) \_\_\_\_\_

PLUS AND ABANDON  CLEAN OUT AND REPLUG   
TARGET FORMATION \_\_\_\_\_ ESTIMATED DEPTH \_\_\_\_\_  
WELL OPERATOR Pennzoil Company DESIGNATED AGENT James A. Crews  
ADDRESS P. O. Box 1588 ADDRESS P. O. Box 1588  
Parkersburg, WV 26101 Parkersburg, WV 26101

**HARRIETT TALKINGTON - 3**

Well No. **X 2** *Harriett Falkington Farm* Acres  
 Lease No. *Jardis* District *Falmer County* State *W. Va.*  
 Bought from *W. S. & C. Co.* Contractor  
 Drilling Commenced *191* Drilling Completed *191*

ROCK FORMATION	TOP	BOTTOM	STEEL LINE MEASUREMENT	REMARKS
<i>Top. Coal</i>	<i>1190</i>	<i>1148</i>		
<i>Thin sand</i>	<i>3200</i>	<i>3270</i>		
<i>London "</i>	<i>3276</i>			
<i>Fourth "</i>	<i>3313</i>			
<i>Gas in London</i>	<i>3285</i>	<i>3245</i>		
<i>Gas in Fourth</i>	<i>3316</i>		<i>3316</i>	
<i>Total depth</i>		<i>3320</i>		
<i>Now filled up to</i>	<i>3248</i>			
<i>Shot June 24, 1914 - 30 lb. 4" x 11" Sect. Top of shot 3285</i> <i>" " " " " " " " " " 3283</i> <i>" " " " " " " " " " 3287</i> <i>" " " " " " " " " " 3281</i>				

CASING RECORD AS TALLIED. NOT STEEL LINE MEASUREMENT

SIZE	PUT IN WELL		PULLED OUT		LEFT IN WELL		Shot Date	Amount	Sand Result	Packer Size	Depth Set
	FEET	IN.	FEET	IN.	FEET	IN.					
<i>10"</i>			<i>pulled</i>								
<i>8 1/4"</i>											
<i>6"</i>	<i>2470</i>										
<i>5"</i>	<i>3280</i>										

Production First 24 Hours \_\_\_\_\_ Bbls. Gas Test \_\_\_\_\_  
 Approved by *[Signature]* Superintendent

033-1846

47-033-1846