

WW-7
8-30-06



West Virginia Department of Environmental Protection
Office of Oil and Gas

WELL LOCATION FORM: GPS

API: 47-033-02133 WELL NO.: 7570
 FARM NAME: Hugh Jarvis
 RESPONSIBLE PARTY NAME: Dominion Energy Transmission, Inc.
 COUNTY: Harrison DISTRICT: Simpson
 QUADRANGLE: Rosemont
 SURFACE OWNER: Julia C. Compton Trust
 ROYALTY OWNER: Hugh Jarvis, et. al.
 UTM GPS NORTHING: 4352522
 UTM GPS EASTING: 566236 GPS ELEVATION: 449 m (1473')

The Responsible Party named above has chosen to submit GPS coordinates in lieu of preparing a new well location plat for a plugging permit or assigned API number on the above well. The Office of Oil and Gas will not accept GPS coordinates that do not meet the following requirements:

- Datum: NAD 1983, Zone: 17 North, Coordinate Units: meters, Altitude: height above mean sea level (MSL) – meters.
- Accuracy to Datum – 3.05 meters
- Data Collection Method:

Survey grade GPS : Post Processed Differential _____

Real-Time Differential _____

Mapping Grade GPS _____ : Post Processed Differential _____

Real-Time Differential _____

- Letter size copy of the topography map showing the well location.**

I the undersigned, hereby certify this data is correct to the best of my knowledge and belief and shows all the information required by law and the regulations issued and prescribed by the Office of Oil and Gas.

[Signature]
Signature


Project manager
Title

09/17/20
Date

RECEIVED
Office of Oil and Gas

SEP 01 2020

WV Department of
Environmental Protection

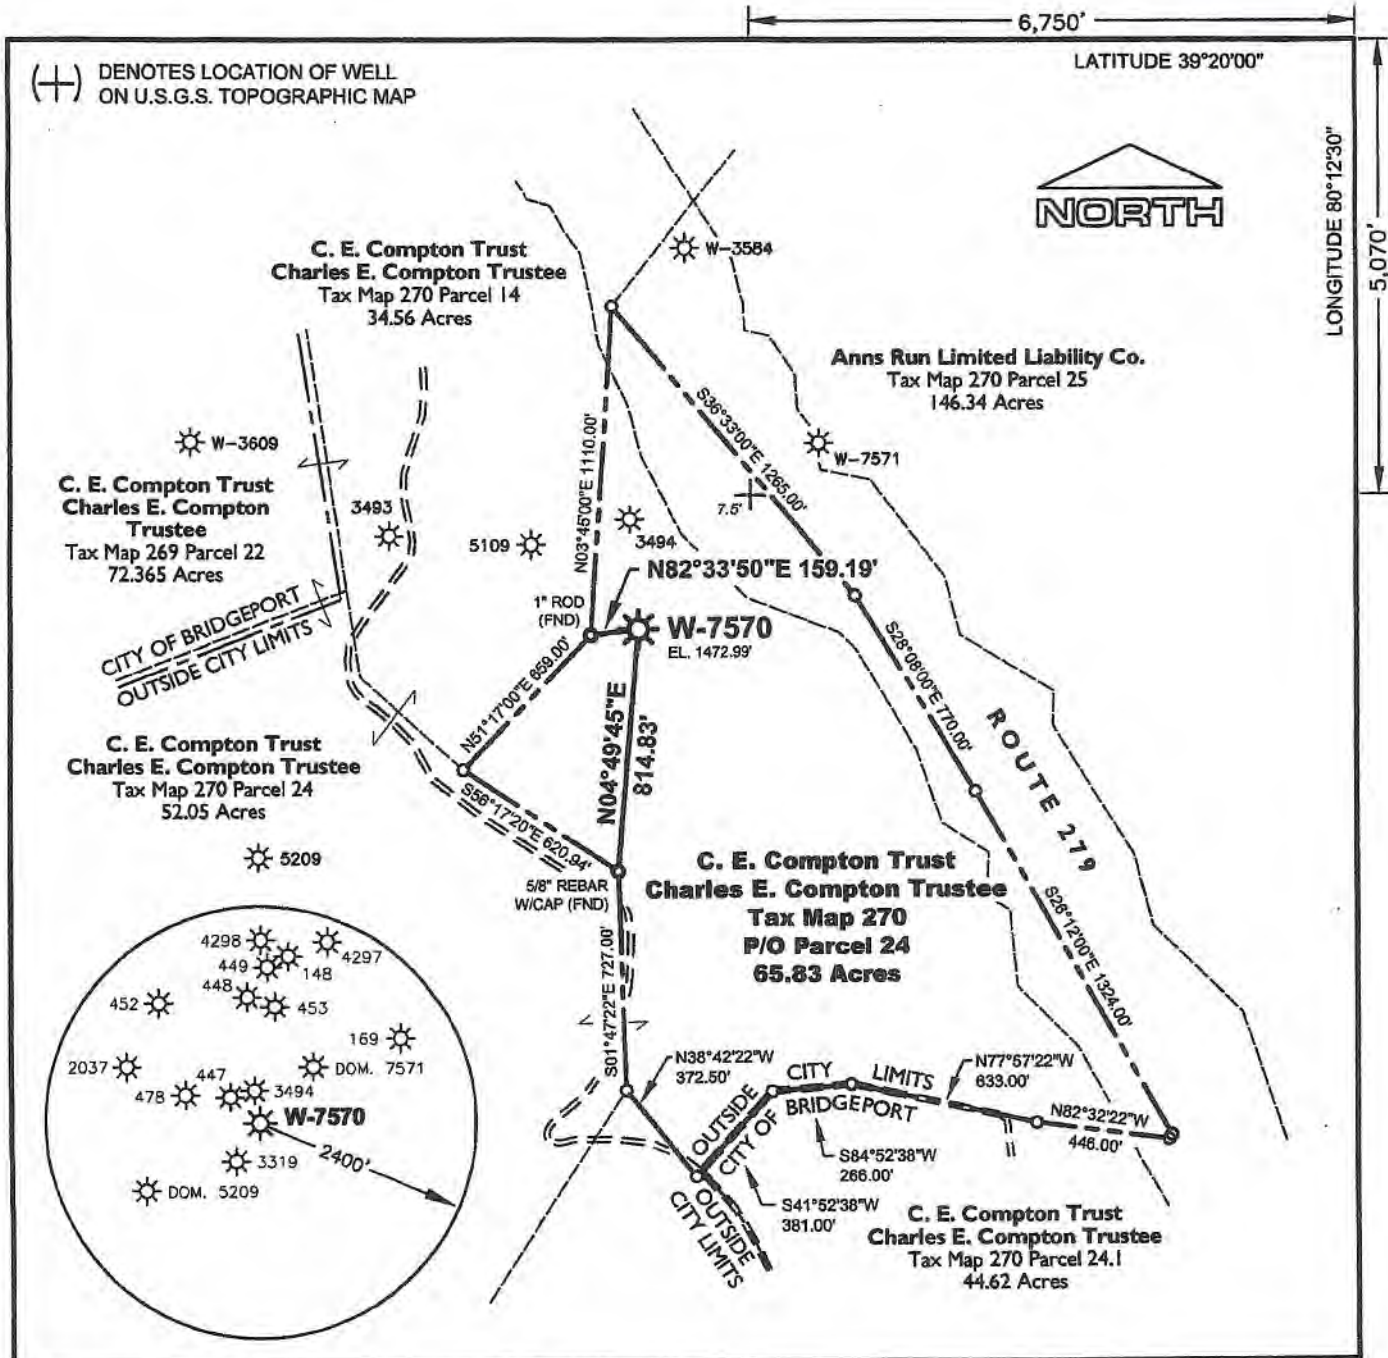

MSES consultants, inc.

FILE NO. 11-109-W7570
 DRAWN BY RRC/MVS
 SCALE 1" = 600'
 MIN. DEGREE OF ACCURACY 1 IN 2500
 PROVEN SOURCE OF ELEVATION :
DGPS (SUBMETER MAPPING GRADE)

I, THE UNDERSIGNED, HEREBY CERTIFY THAT THIS PLAT IS CORRECT TO THE BEST OF MY KNOWLEDGE AND BELIEF, AND THAT IT SHOWS ALL INFORMATION REQUIRED BY LAW AND REGULATIONS ISSUED AND PRESCRIBED BY THE DEPARTMENT OF MINES.

(SIGNED) _____
 R.P.E. _____ P.S. 864

STATE OF WEST VIRGINIA
 DEPARTMENT OF MINES
OIL AND GAS DIVISION



DATE APRIL 19, 20 11
 OPERATOR'S WELL NO. W-7570
 API WELL NO.
47 033 02133 P
 STATE COUNTY PERMIT NO.

RECEIVED: Office of Oil and Gas

SEP 01 2020

WELL TYPE: OIL GAS LIQUID INJECTION WASTE DISPOSAL
 IF "GAS", PRODUCTION STORAGE DEEP SHALLOW

LOCATION: ELEVATION 1472.99 WATERSHED STOUTS RUN OF BARNETT RUN
 DISTRICT SIMPSON COUNTY HARRISON
 QUADRANGLE ROSEMONT 7.5' NEAREST TOWN RYANVILLE

WV Department of Environmental Protection

SURFACE OWNER C. E. COMPTON TRUST CHARLES E. COMPTON TRUSTEE ACREAGE 65.83
 OIL & GAS ROYALTY OWNER W. B. MAXWELL, HRS. & H. JARVIS, ESTATE LEASE ACREAGE 334
 LEASE NO. 49807-52357

PROPOSED WORK: DRILL CONVERT DRILL DEEPER REDRILL FRACTURE OR STIMULATE
 PLUG OFF OLD FORMATION PERFORATE NEW FORMATION
 OTHER PHYSICAL CHANGE IN WELL (SPECIFY) Recase Existing
 PLUG AND ABANDON CLEAN OUT AND REPLUG

TARGET FORMATION 50 FOOT SAND ESTIMATED DEPTH 2225'
 WELL OPERATOR DOMINION TRANSMISSION, INC. DESIGNATED AGENT JAMES D. BLASINGAME
 ADDRESS 445 WEST MAIN STREET ADDRESS 445 WEST MAIN STREET
CLARKSBURG, WV 26301 CLARKSBURG, WV 26301

COUNTY **033**
 PERMIT NO. **02133**