



DIVERSIFIED
energy



47-033-02249

Well Plugging Map

RECEIVED
Office of Oil and Gas
10/2/2026
WV Department of
Environmental Protection

Legend
Well
Pits
Pit Pad
Access Road
Public Roads

RECEIVED
Office of Oil and Gas
10/2/2026
WV Department of
Environmental Protection

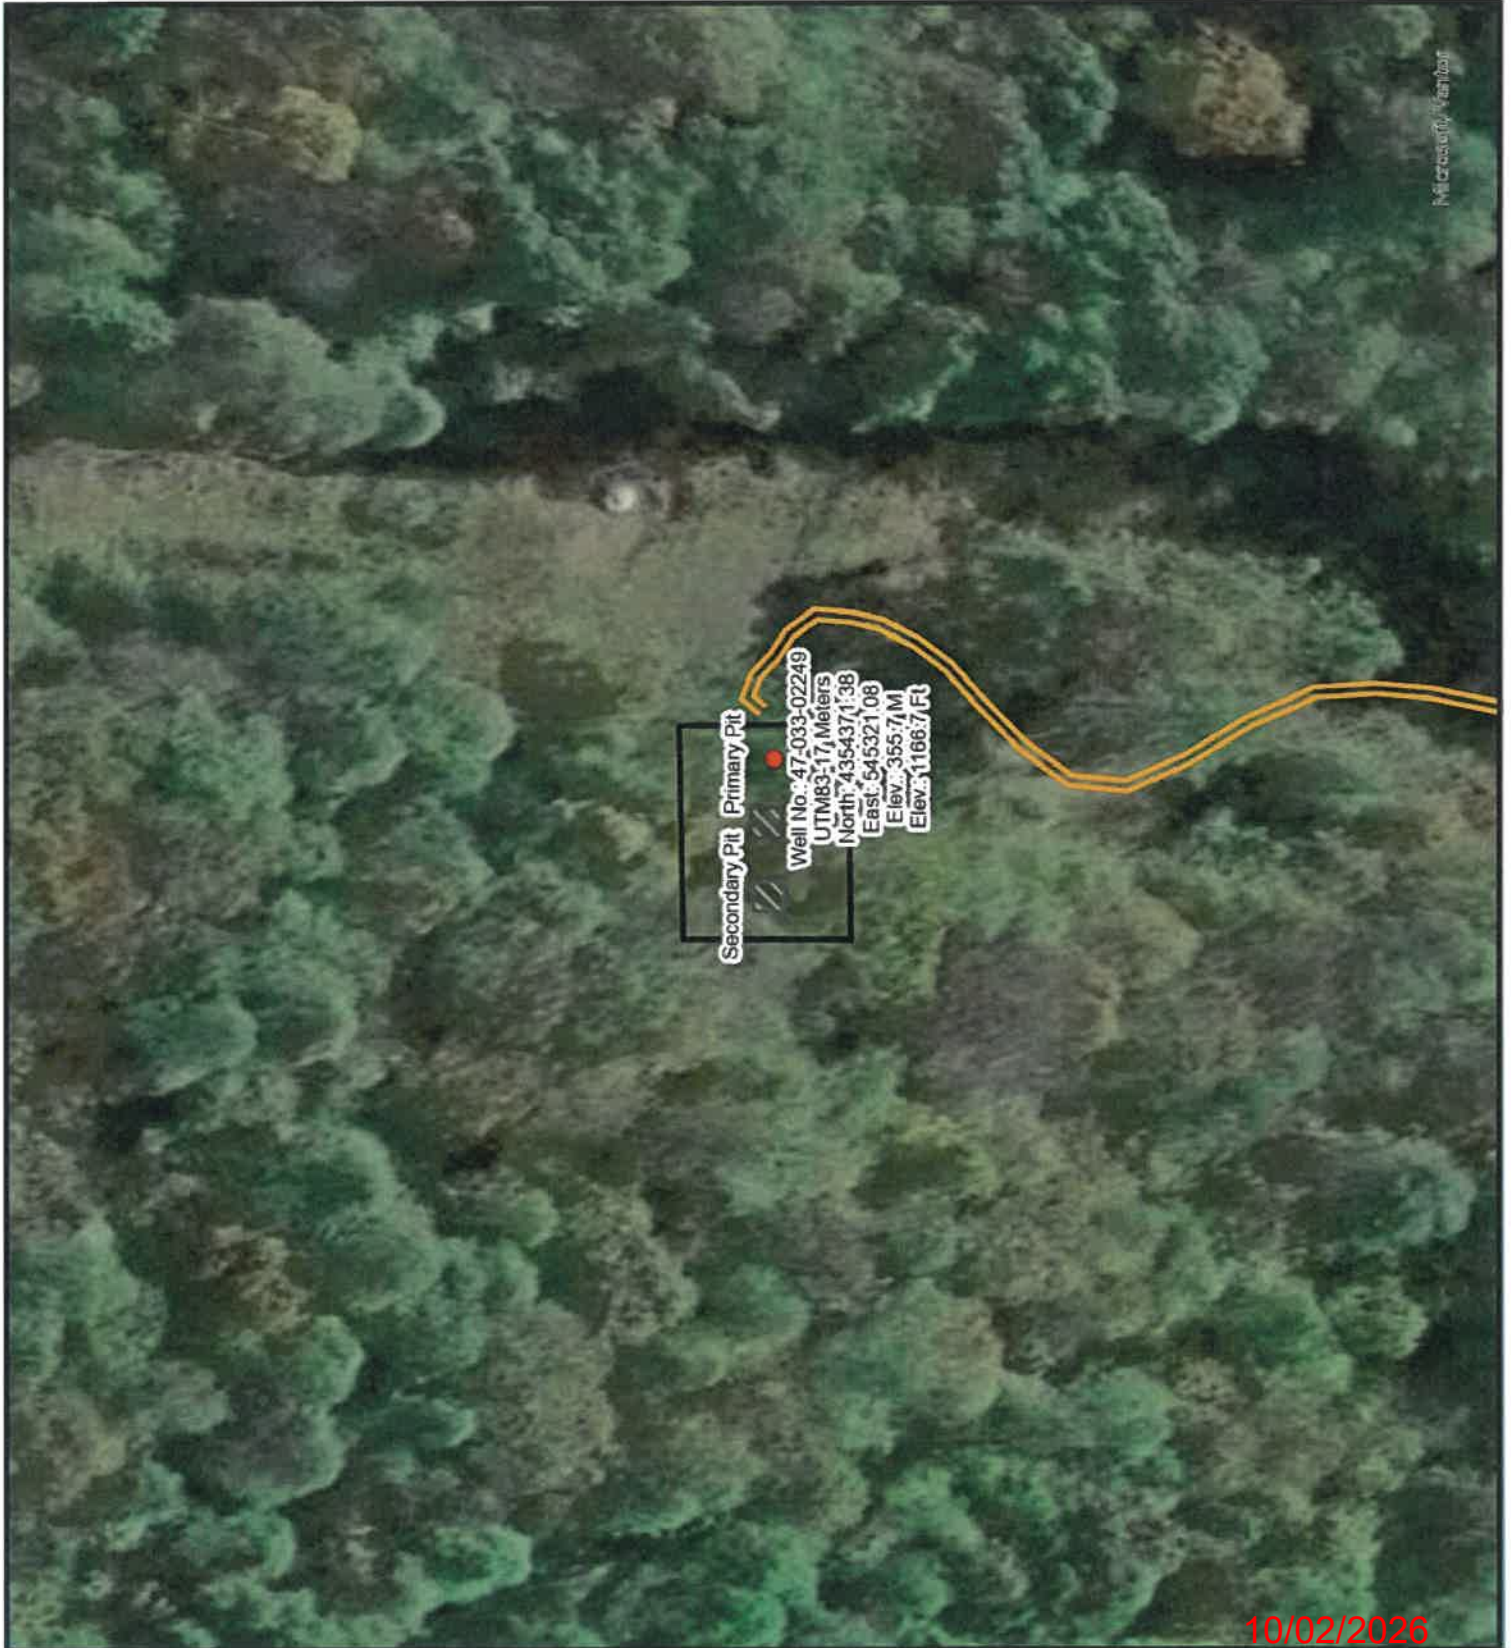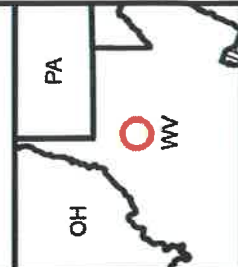



DIVERSIFIED
energy


47-033-02249

Well Plugging Map


Legend

- Well
- Pits
- Pad
- Access Road
- Public Roads

RECEIVED
Office of Oil and Gas
SEP 10 2026
WV Department of
Environmental Protection

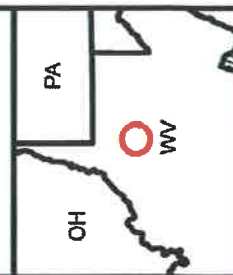

Well No.: 47-033-02249
UTM83-17 Meters
North: 4354371.38
East: 545321.08
Elev.: 355.7 M
Elev.: 1166.7 Ft

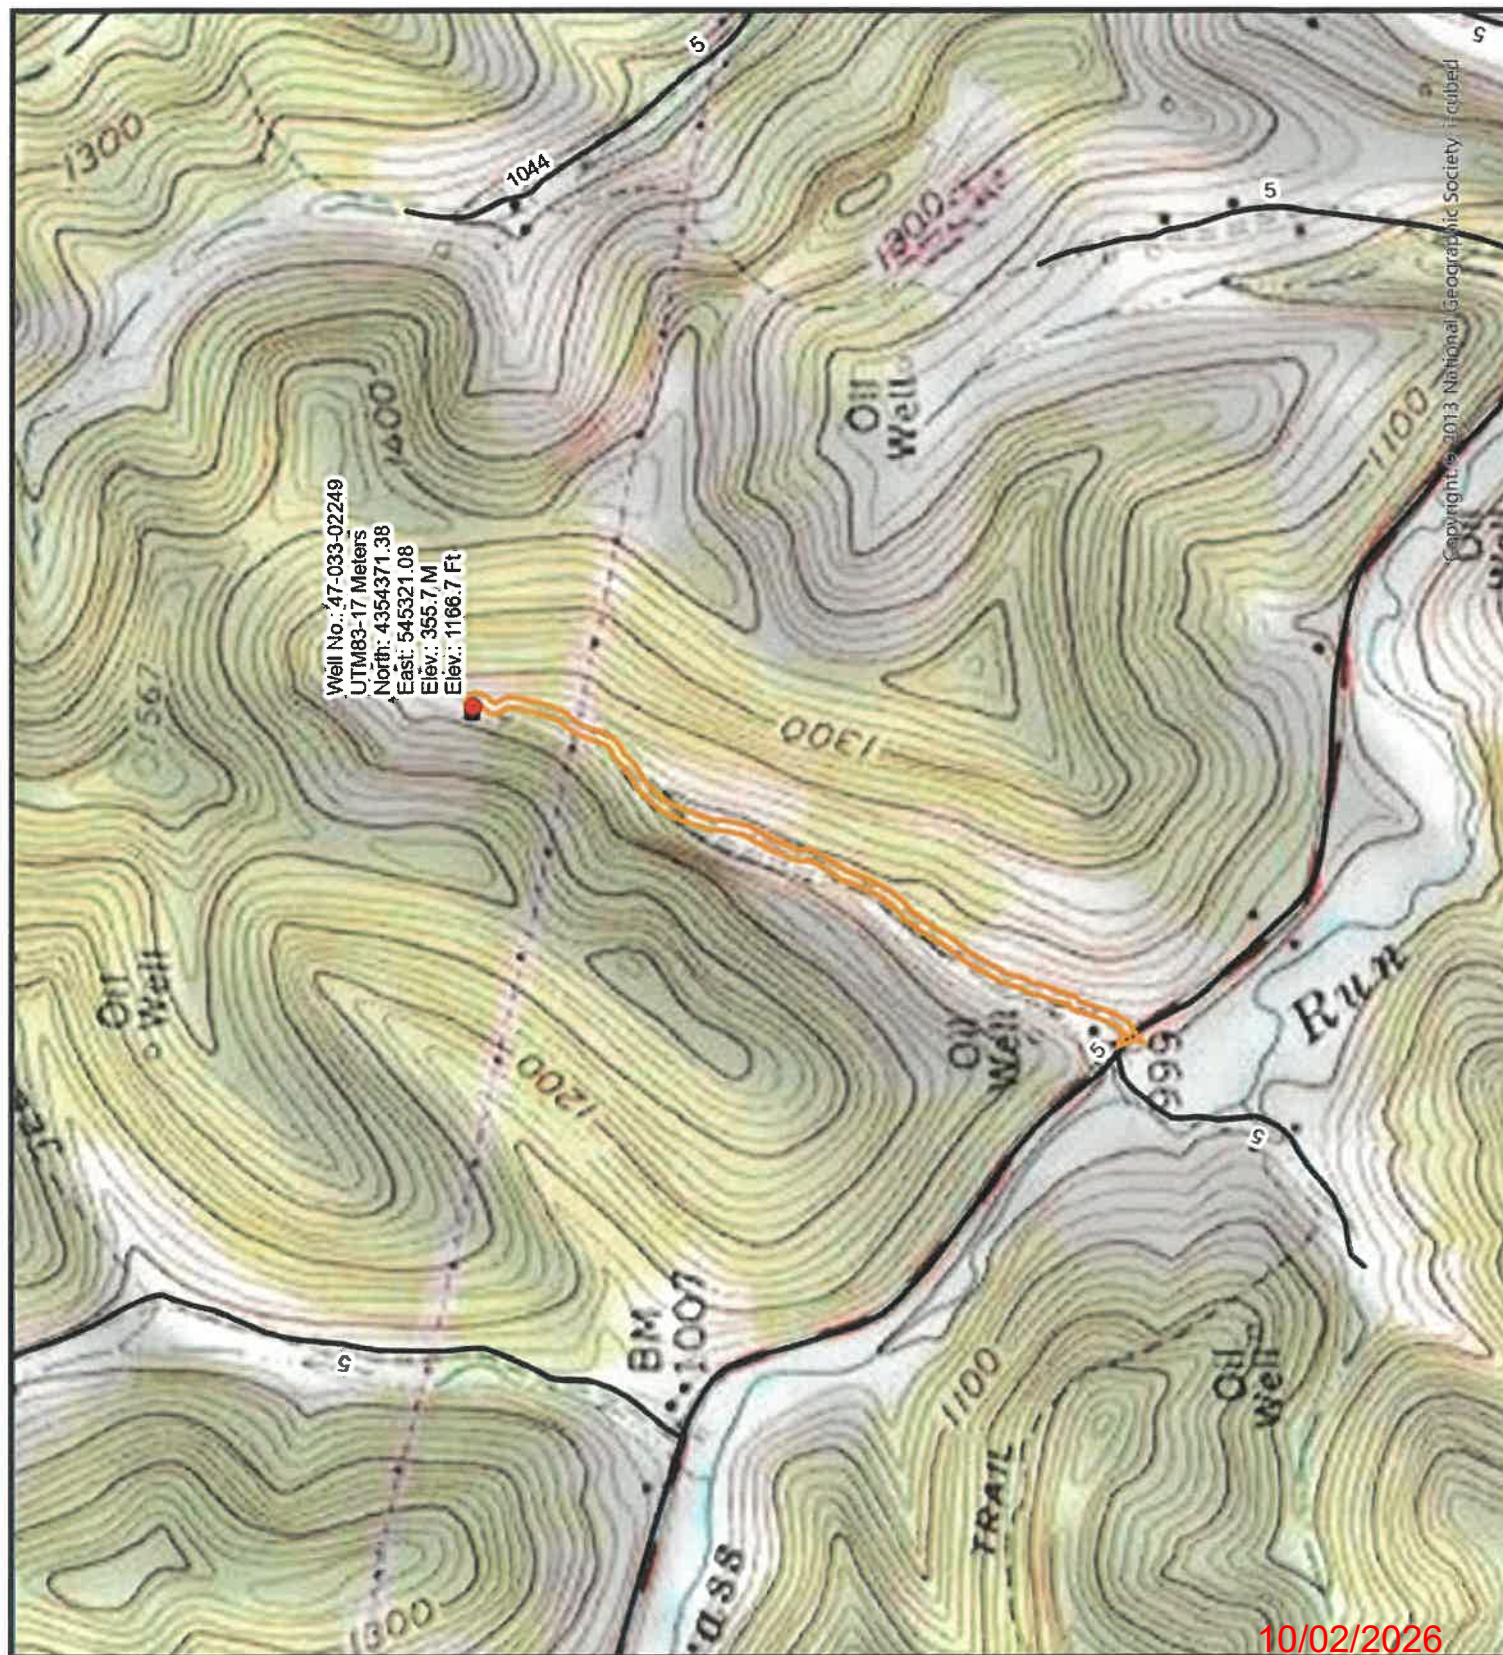

10/02/2026

WW-7
8-30-06



West Virginia Department of Environmental Protection
Office of Oil and Gas
WELL LOCATION FORM: GPS

API: 4703302249 WELL NO.: MORRIS 1 JOHN
FARM NAME: John W. Morris
RESPONSIBLE PARTY NAME: Diversified Production, LLC
COUNTY: Harrison DISTRICT: Ten Mile-Outside
QUADRANGLE: Wolf Summit 7.5'
SURFACE OWNER: Alden C. Morris
ROYALTY OWNER: Alden C. Morris & AMP IV, LP
UTM GPS NORTHING: 4354371.38
UTM GPS EASTING: 545321.08 GPS ELEVATION: 1166.7'

The Responsible Party named above has chosen to submit GPS coordinates in lieu of preparing a new well location plat for a plugging permit or assigned API number on the above well. The Office of Oil and Gas will not accept GPS coordinates that do not meet the following requirements:

1. Datum: NAD 1983, Zone: 17 North, Coordinate Units: meters, Altitude: height above mean sea level (MSL) – meters.
2. Accuracy to Datum – 3.05 meters
3. Data Collection Method:

Survey grade GPS ____: Post Processed Differential ____

Real-Time Differential ____

Mapping Grade GPS X: Post Processed Differential X


Real-Time Differential ____

4. Letter size copy of the topography map showing the well location.

I the undersigned, hereby certify this data is correct to the best of my knowledge and belief and shows all the information required by law and the regulations issued and prescribed by the Office of Oil and Gas.


Signature

Chris Veazey - Director of Administration
Title

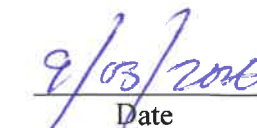
Date

RECEIVED
Office of Oil and Gas
SEP 10 2006
WV Department of
Environmental Protection

10/02/2026