


NATURAL GAS COMPANY  
 LOCATION FOR WELL No. 2824

Buffalo DISTRICT  
 Buffalo, Harrison County, West Virginia  
 268 N. 4 E. 13 W.  
 To Case in Charleston 10-29-1912  
 One hundred feet from Chas. Herbert farm and  
 four hundred feet from Emily M. Carty farm

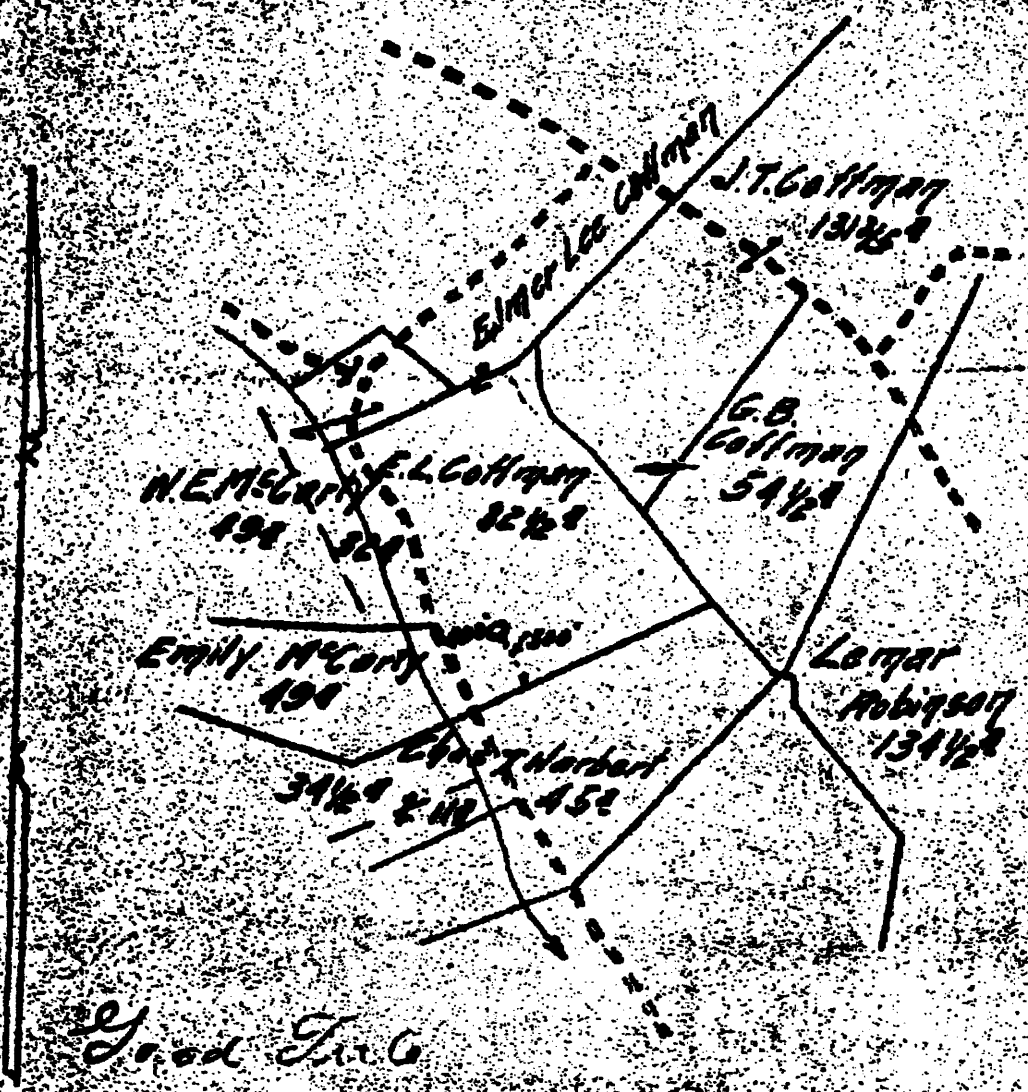

RESERVE Eight acres around the well casing

SPECIAL INSTRUCTIONS Cement to casing inside Farming Coal Co. same basin which is located Well 605

Location made 11-9-12 by H. Graham as per plat, except as noted. On field map 11-11-12 Returned to Pittsburgh 11-11-12

Location changed on account of  
 Authorized by \_\_\_\_\_ Date \_\_\_\_\_ Signed by \_\_\_\_\_

331  
 Harrison 2291

Op. C

