





DIVERSIFIED
energy

47-033-02848

Well Plugging Map

Legend

- Well
- Pits
- Pad
- Access Road
- Public Roads

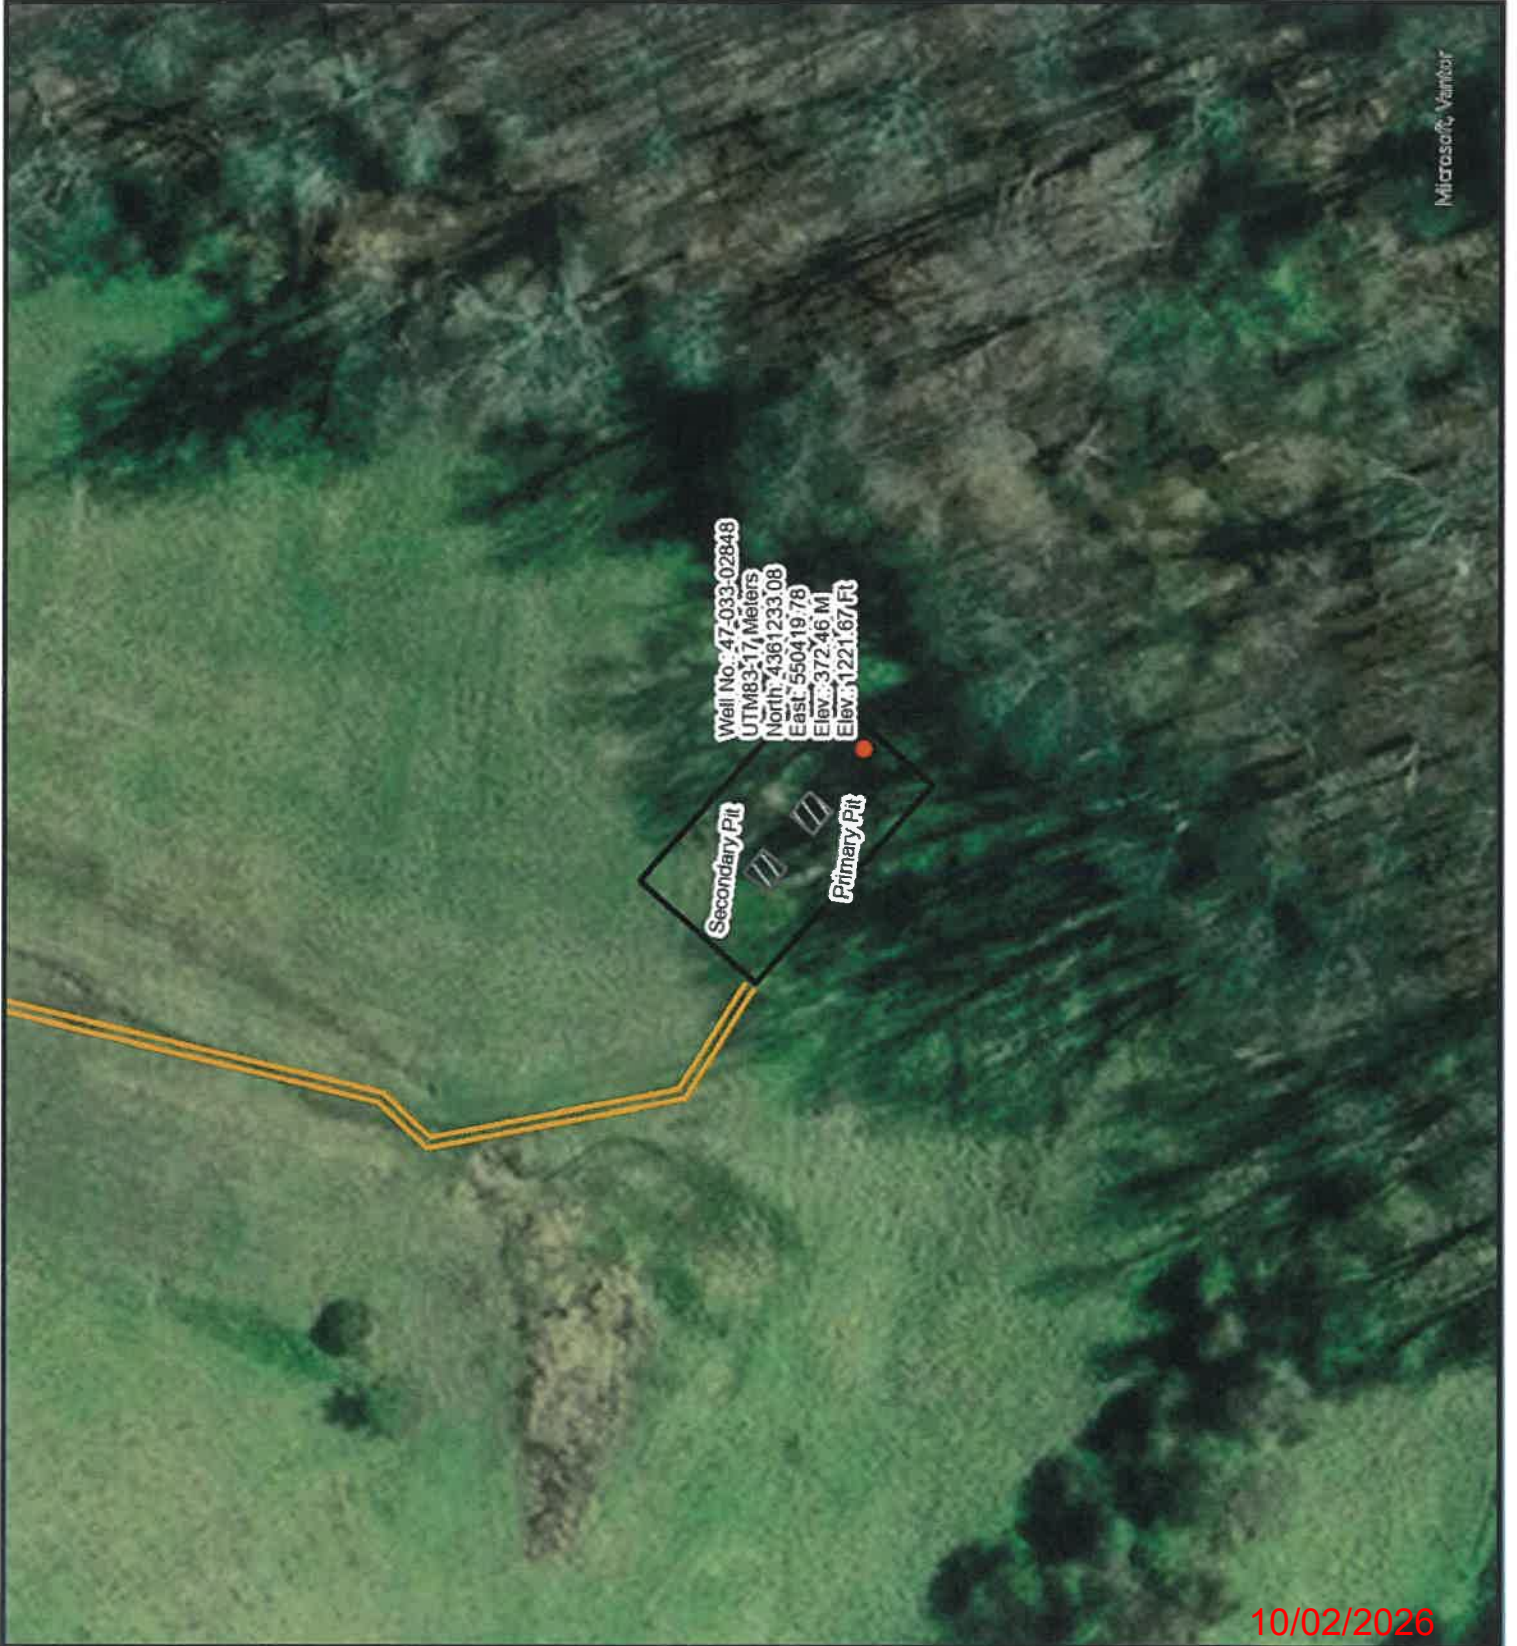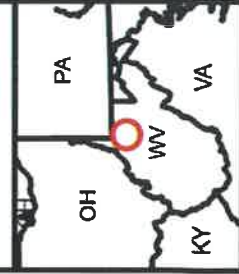

10/02/2026





DIVERSIFIED
energy

47-033-02848
Well Plugging Map

Legend

- Well
- Pits
- Pad
- Access Road
- Public Roads

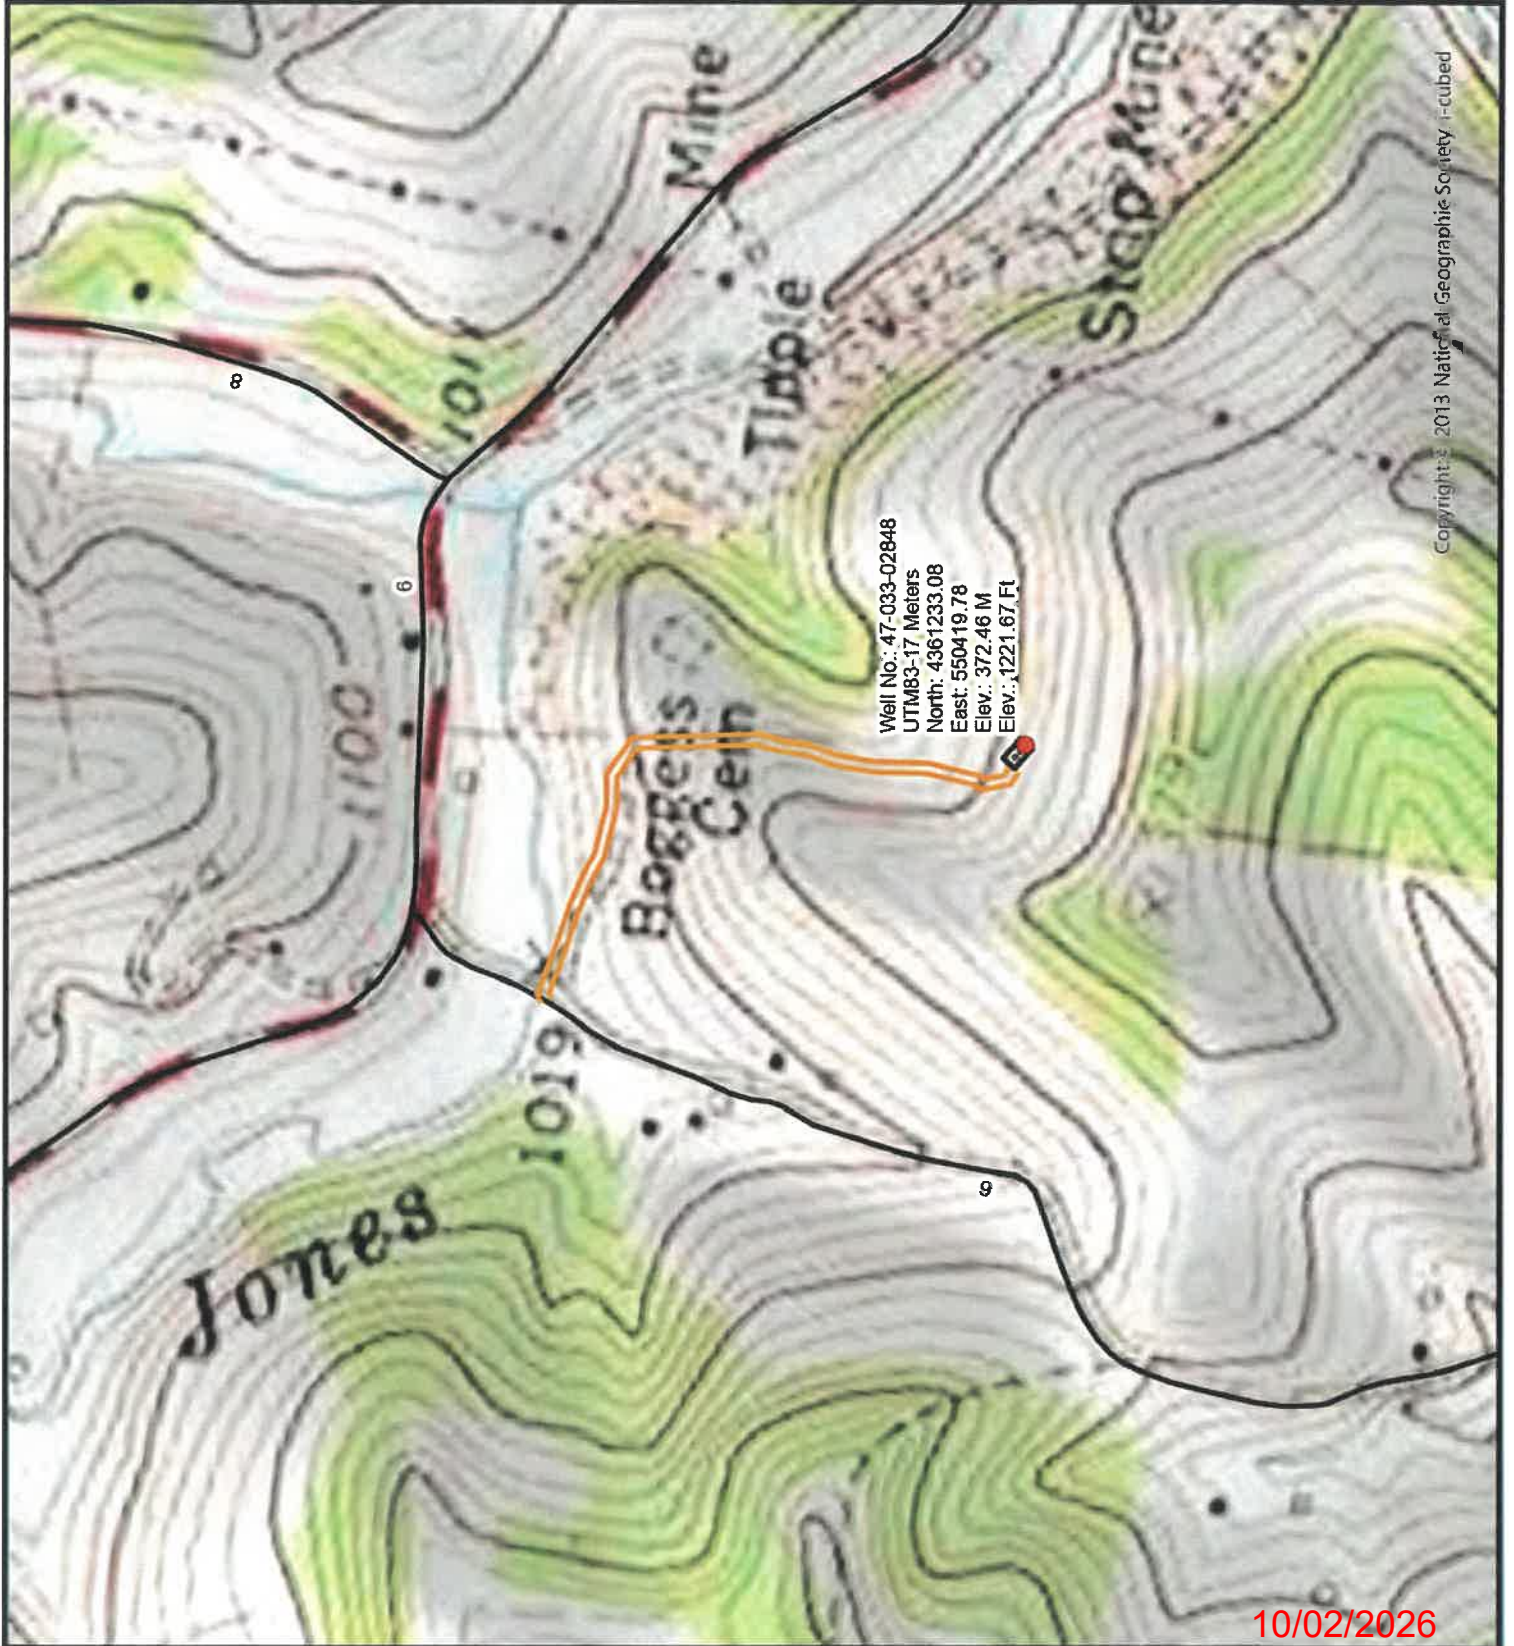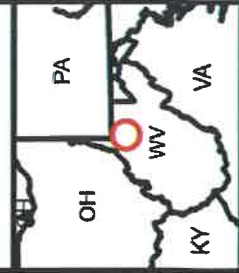

10/02/2026

WW-7
8-30-06



West Virginia Department of Environmental Protection
Office of Oil and Gas
WELL LOCATION FORM: GPS

API: 4703302848 WELL NO.: ROGER-MARTIN 1

FARM NAME: Herbert Martin

RESPONSIBLE PARTY NAME: Diversified Production, LLC

COUNTY: Harrison DISTRICT: Eagle

QUADRANGLE: Wallace 7.5'

SURFACE OWNER: Michael W. Owens & Fallon B. Owens

ROYALTY OWNER: Harold R. Martin

UTM GPS NORTHING: 4361233.08


UTM GPS EASTING: 550419.78 GPS ELEVATION: 1221.67'

The Responsible Party named above has chosen to submit GPS coordinates in lieu of preparing a new well location plat for a plugging permit or assigned API number on the above well. The Office of Oil and Gas will not accept GPS coordinates that do not meet the following requirements:

1. Datum: NAD 1983, Zone: 17 North, Coordinate Units: meters, ^{Altitude} height above mean sea level (MSL) – meters.
2. Accuracy to Datum – 3.05 meters
3. Data Collection Method:
Survey grade GPS ____ : Post Processed Differential ____
Real-Time Differential ____
Mapping Grade GPS X : Post Processed Differential X
Real-Time Differential ____

4. **Letter size copy of the topography map showing the well location.**

I the undersigned, hereby certify this data is correct to the best of my knowledge and belief and shows all the information required by law and the regulations issued and prescribed by the Office of Oil and Gas.

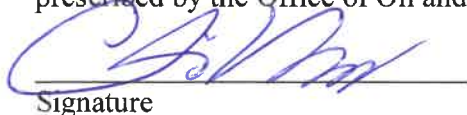
Signature

Chris Veazey - Director of Administration
Title


Date

10/02/2026