

47-033-03652 P

WW-7
8-30-06



West Virginia Department of Environmental Protection
Office of Oil and Gas
WELL LOCATION FORM: GPS

API: 47-033-03652 WELL NO.: Cathers #1 S-761

FARM NAME: Nathan Goff III

RESPONSIBLE PARTY NAME: Jerry L. Jackson

COUNTY: Harrison DISTRICT: Coal

QUADRANGLE: Wolf Summit

SURFACE OWNER: Payton Despard Fireman

ROYALTY OWNER: H. Goff Porter

UTM GPS NORTHING: 4349045.8

UTM GPS EASTING: 550825.2 GPS ELEVATION: 1244'

The Responsible Party named above has chosen to submit GPS coordinates in lieu of preparing a new well location plat for a plugging permit or assigned API number on the above well. The Office of Oil and Gas will not accept GPS coordinates that do not meet the following requirements:

1. Datum: NAD 1983, Zone: 17 North, Coordinate Units: meters, Altitude: height above mean sea level (MSL) – meters.
2. Accuracy to Datum – 3.05 meters
3. Data Collection Method:

Survey grade GPS : Post Processed Differential

Real-Time Differential

Mapping Grade GPS : Post Processed Differential

Real-Time Differential

4. **Letter size copy of the topography map showing the well location.**


I the undersigned, hereby certify this data is correct to the best of my knowledge and belief and shows all the information required by law and the regulations issued and prescribed by the Office of Oil and Gas.

Signature

Land Manager
Title

8/01/2019
Date


RECEIVED
Office of Oil and Gas
AUG 15 2019
WV Department of
Environmental Protection

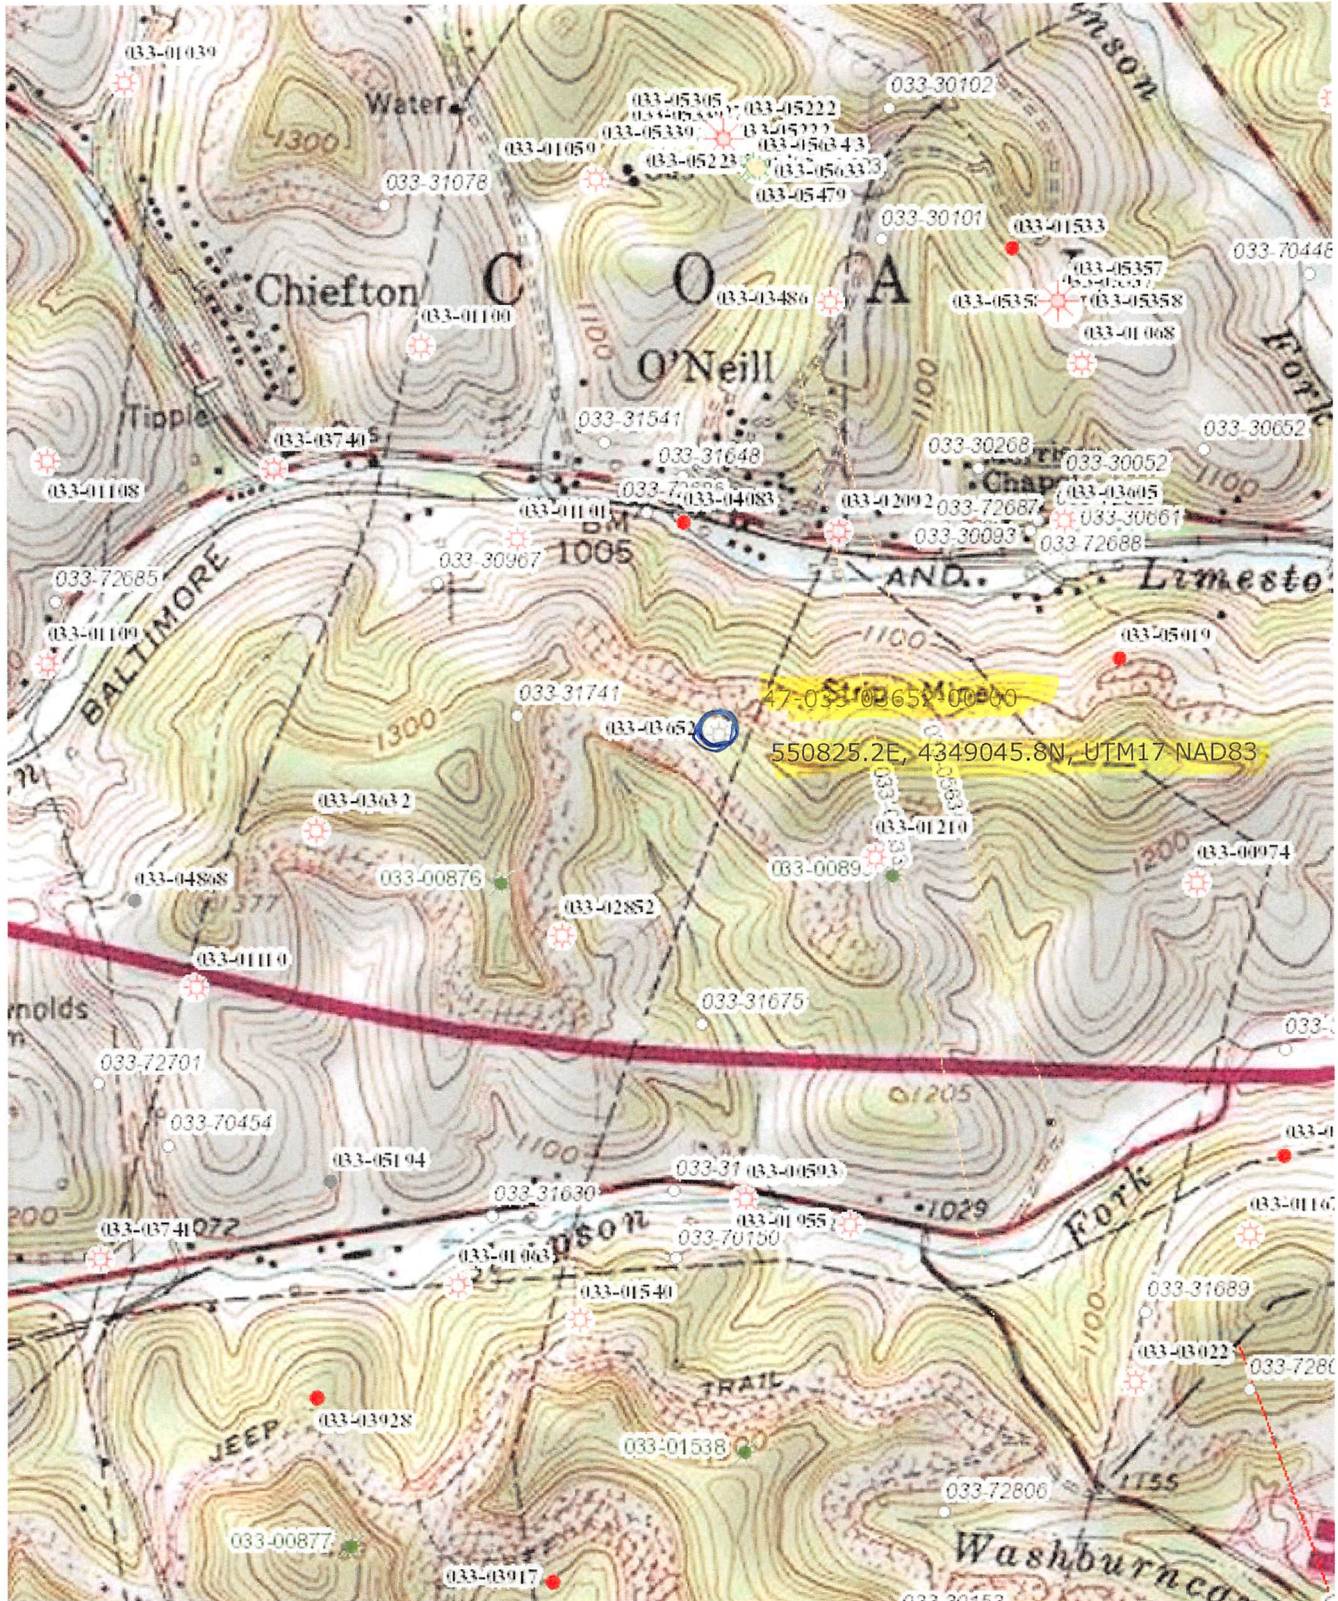

SURFACE OWNER: 33-03652

PAYTON D. FIREMAN
1425 SARATOGA AVE.
MORGANTOWN, WV 26505

NORTH

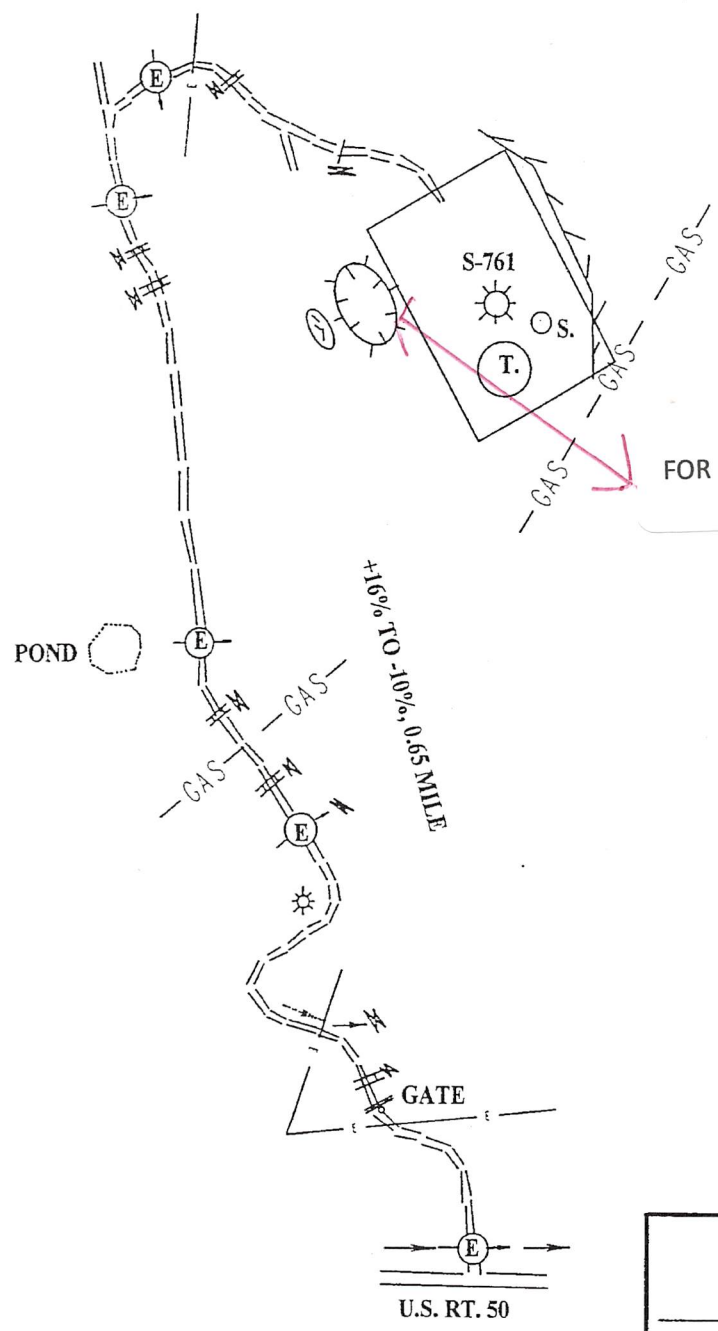

FOR PLUGGING NO PITTS WILL BE BUILT

THIS PLAN IS FOR THE REWORK OF AN EXISTING GAS WELL. ENTIRE LENGTH OF ACCESS ROAD IS EXISTING WELL ROAD. ROCK WILL BE USED WHERE NECESSARY.

DRAWINGS TO ACCOMPANY FORM WW-9

ENERVEST OPERATING, LLC

P. O. DRAWER 1878

CLARKSBURG, WV 26302

WATERSHED: SIMPSON FORK

DISTRICT: COAL COUNTY: HARRISON

QUADRANGLE: WOLF SUMMIT WELL NO.: S-761

DATE: 05/12/04 PAGE of

RECEIVED
Office of Oil and Gas

AUG 15 2019

WV Department of
Environmental Protection

RECEIVED
Office of Oil & Gas
Office of Chief
MAY 21 2004
WV Department of
Environmental Protection

LAND SURVEYING SERVICES
21 CEDAR LANE
BRIDGEPORT, WV 26330
PHONE: 304-842-2018 OR 5762