

WW-7
8-30-06



West Virginia Department of Environmental Protection
Office of Oil and Gas
WELL LOCATION FORM: GPS

API: 47-033-03841 WELL NO.: E-889 David Shrader

FARM NAME: William Harvath

RESPONSIBLE PARTY NAME: Jerry L. Jackson

COUNTY: Harrison DISTRICT: Sardis

QUADRANGLE: ~~Wolf~~ Wallace

SURFACE OWNER: Gary A. Marchiny et al

ROYALTY OWNER: David Shrader

UTM GPS NORTHING: 4359372.8

UTM GPS EASTING: 547503.1 GPS ELEVATION: 1104'

The Responsible Party named above has chosen to submit GPS coordinates in lieu of preparing a new well location plat for a plugging permit or assigned API number on the above well. The Office of Oil and Gas will not accept GPS coordinates that do not meet the following requirements:

- Datum: NAD 1983, Zone: 17 North, Coordinate Units: meters, Altitude: height above mean sea level (MSL) – meters.
- Accuracy to Datum – 3.05 meters
- Data Collection Method:
Survey grade GPS ____: Post Processed Differential ____
Real-Time Differential ____
Mapping Grade GPS ____: Post Processed Differential ____
Real-Time Differential ____
- Letter size copy of the topography map showing the well location.**


I the undersigned, hereby certify this data is correct to the best of my knowledge and belief and shows all the information required by law and the regulations issued and prescribed by the Office of Oil and Gas.

Signature

Land Manager
Title

8/01/2019
Date

RECEIVED
Office of Oil and Gas
AUG 15 2019
WV Department of
Environmental Protection

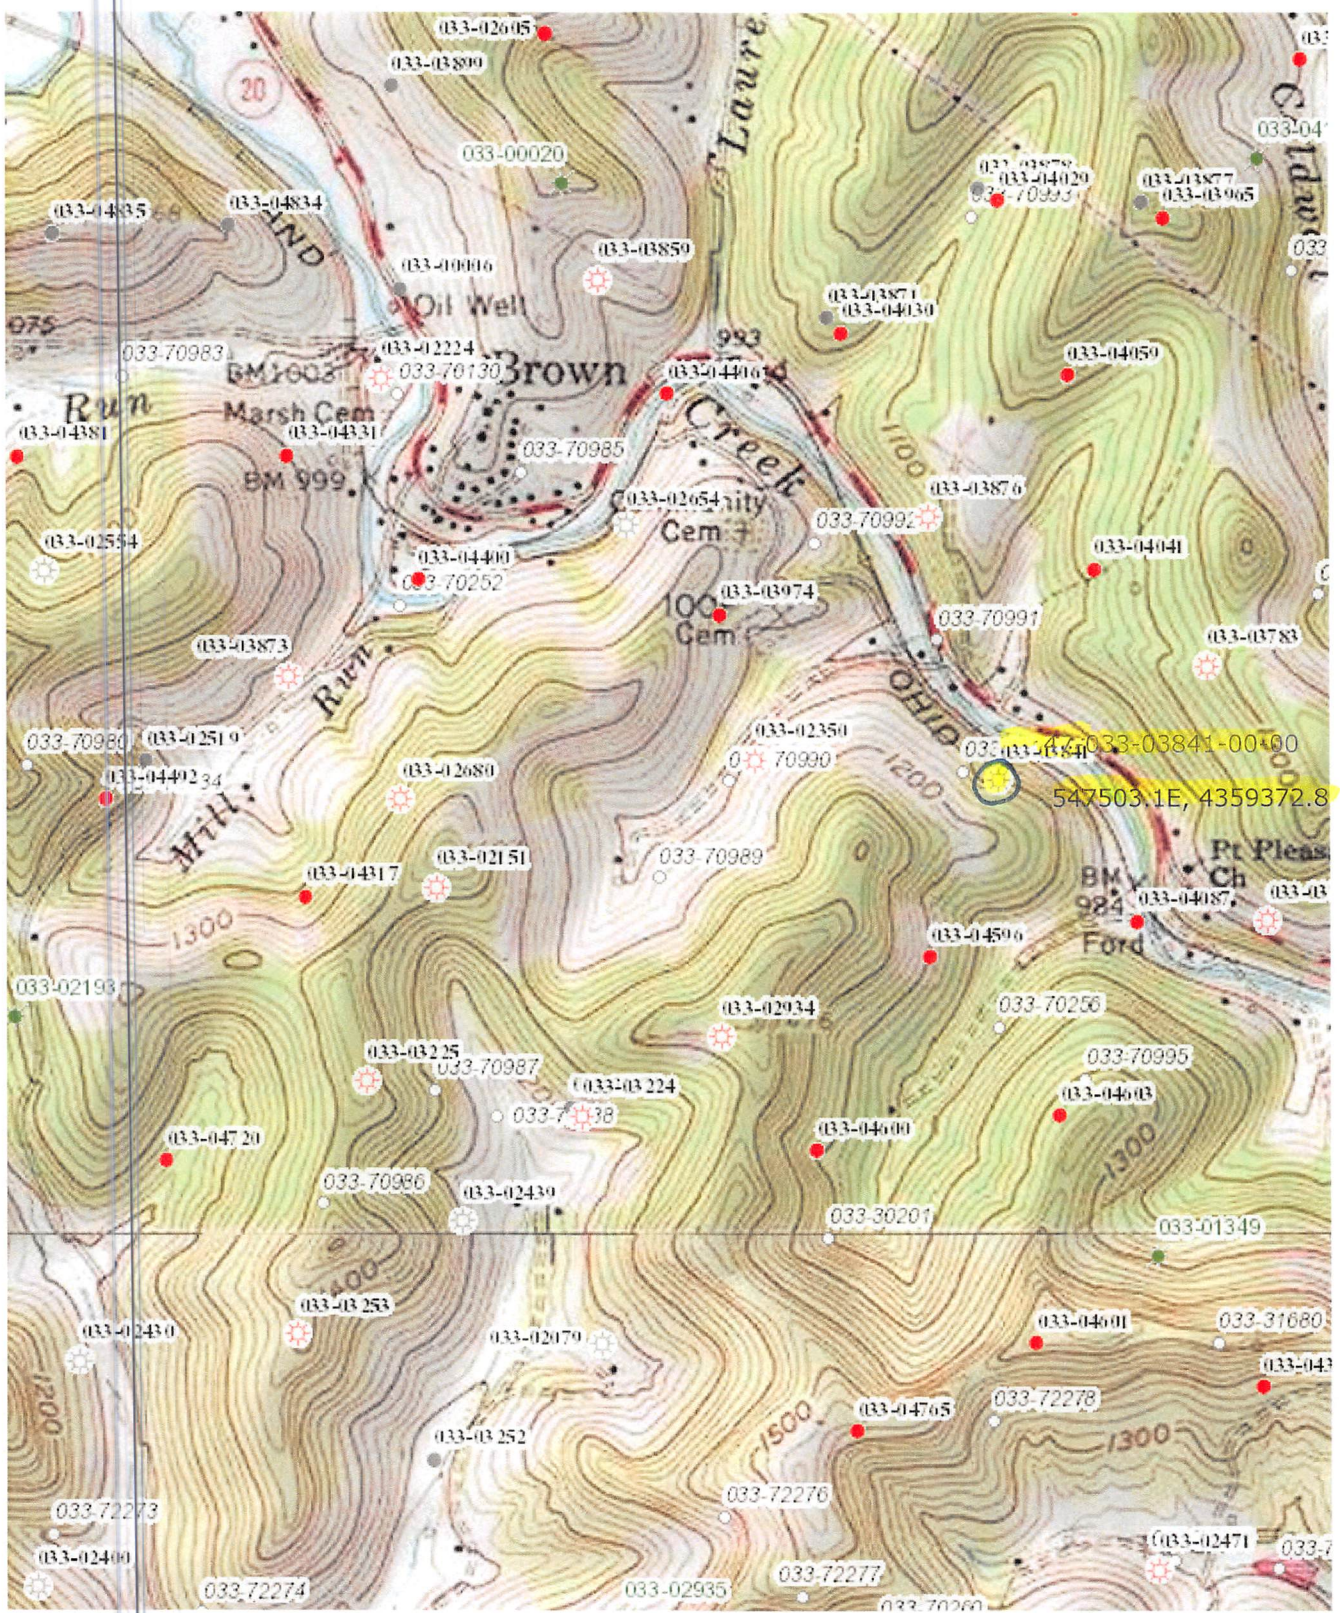



David Shrader E-889

ENERVEST

47-033-0384A

WEBB J E HEIRS-1

E STROTHER 1 -K-L-269

Sardis
Harrison

Strother Hollow Rd

STROTHER E ESTATE-2

Strother Hollow Rd

Fullen Farm Rd

West Virginia

SE MARTIN-2141

Wallace Pike

Tater Patch Rd

SHRADER DAVID-E-889
LONA E SWIGER-3841

CSX Transportation

RECEIVED
Office of Oil and Gas
AUG 15 2019
WV Department of
Environmental Protection



CSX Transportation

Wallace Pike

20

CSX Transportation

20





David Shrader E-889

47-033-03841P

Sardis

Harrison

EXISTING ROAD

SHRADER DAVID E-889

FOR PLUGGING NO PITTS WILL BE BUILT

LOMA E SWIGER-3841

SHRADER DAVID E-889

CSX Transportation

CSX Transportation

RECEIVED
Office of Oil and Gas

AUG 15 2019

WV Department of
Environmental Protection

20

Date Printed: 2019-07-30

