

No.112
UTM Coordinates
(NAD83)
Meters
N - 4,347,725
E - 543,381


NOTES ON SURVEY
 1 - The survey shown hereon is from original drilling permit dated August 28, 2007.
 2 - Plat has been updated to show as-drilled Latitude/Longitude information and current surface owner information.
 3 - Latitude and Longitude established by DGPS Survey.

CALL TABLE					
(A)	N75°14'E	606.06'	(B)	N4°09'W	375.89'
(C)	N80°40'E	1020.5'	(D)	S89°25'E	264.00'
(E)	S57°17'E	379.92'	(F)	S80°00'E	483.21'
(G)	N80°31'E	260.33'	(H)	S84°57'E	98.02'
(I)	S73°48'E	138.43'	(J)	S89°39'E	266.94'
(K)	S15°59'E	58.69'	(L)	N28°30'E	66.00'
(M)	N56°30'E	107.25'	(N)	S40°00'W	99.00'

⊕ DENOTES LOCATION OF WELL ON UNITED STATES TOPOGRAPHIC MAPS.

FILE NO. 1042-39
 MAP NO. N S E W
 SCALE 1" = 1000'
 MINIMUM DEGREE OF ACCURACY Sub-Meter DGPS
 PROVEN SOURCE OF ELEVATION DGPS Survey

I THE UNDERSIGNED, HEREBY CERTIFY THAT THIS PLAT IS CORRECT TO THE BEST OF MY KNOWLEDGE AND BELIEF AND SHOWS ALL THE INFORMATION REQUIRED BY LAW AND THE REGULATIONS ISSUED AND PRESCRIBED BY THE DEPARTMENT OF MINES.
 (SIGNED) [Signature]
 TIMOTHY P. ROUSH PS 793

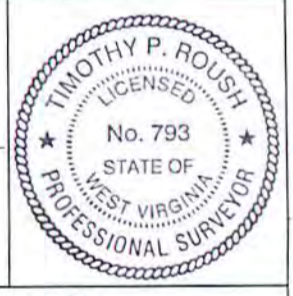

WEST VIRGINIA
 Division of Environmental Protection
 Office of Oil and Gas
 601 57th Street
 Charleston, West Virginia 25304



DATE February 19, 2015
 FARM Hiram Lynch No.112
 API WELL NO. 47-033-4934

WELL TYPE: OIL GAS LIQUID INJECTION WASTE DISPOSAL CORE
 (IF "GAS") PRODUCTION STORAGE DEEP SHALLOW
 LOCATION: ELEVATION 1,298' WATERSHED Wizardism Run
 DISTRICT Ten Mile COUNTY Harrison
 QUADRANGLE Wolf Summit 7.5'

Received
 MAR 18 2015

SURFACE OWNER David & Sandra Turner ACREAGE 52.17 Ac.
 OIL & GAS ROYALTY OWNER Anne Farr et al. LEASE ACREAGE 568 Ac.
 LEASE NO. 31378-50

PROPOSED WORK: DRILL CONVERT DRILL DEEPER REDRILL FRACTURE OR STIMULATE PLUG OFF OLD FORMATION PERFORATE NEW FORMATION OTHER PHYSICAL CHANGE IN WELL (SPECIFY) _____


PLUG AND ABANDON CLEAN OUT AND REPLUG
 TARGET FORMATION Fifth Sand ESTIMATED DEPTH 3,050'

WELL OPERATOR HG Energy LLC. DESIGNATED AGENT Diane White
 ADDRESS 5260 DuPont Road Parkersburg, WV 26101 ADDRESS 5260 DuPont Road Parkersburg, WV 26101

05/08/2015

SUBJECT WELL Hiram Lynch No.112

47-033-4934

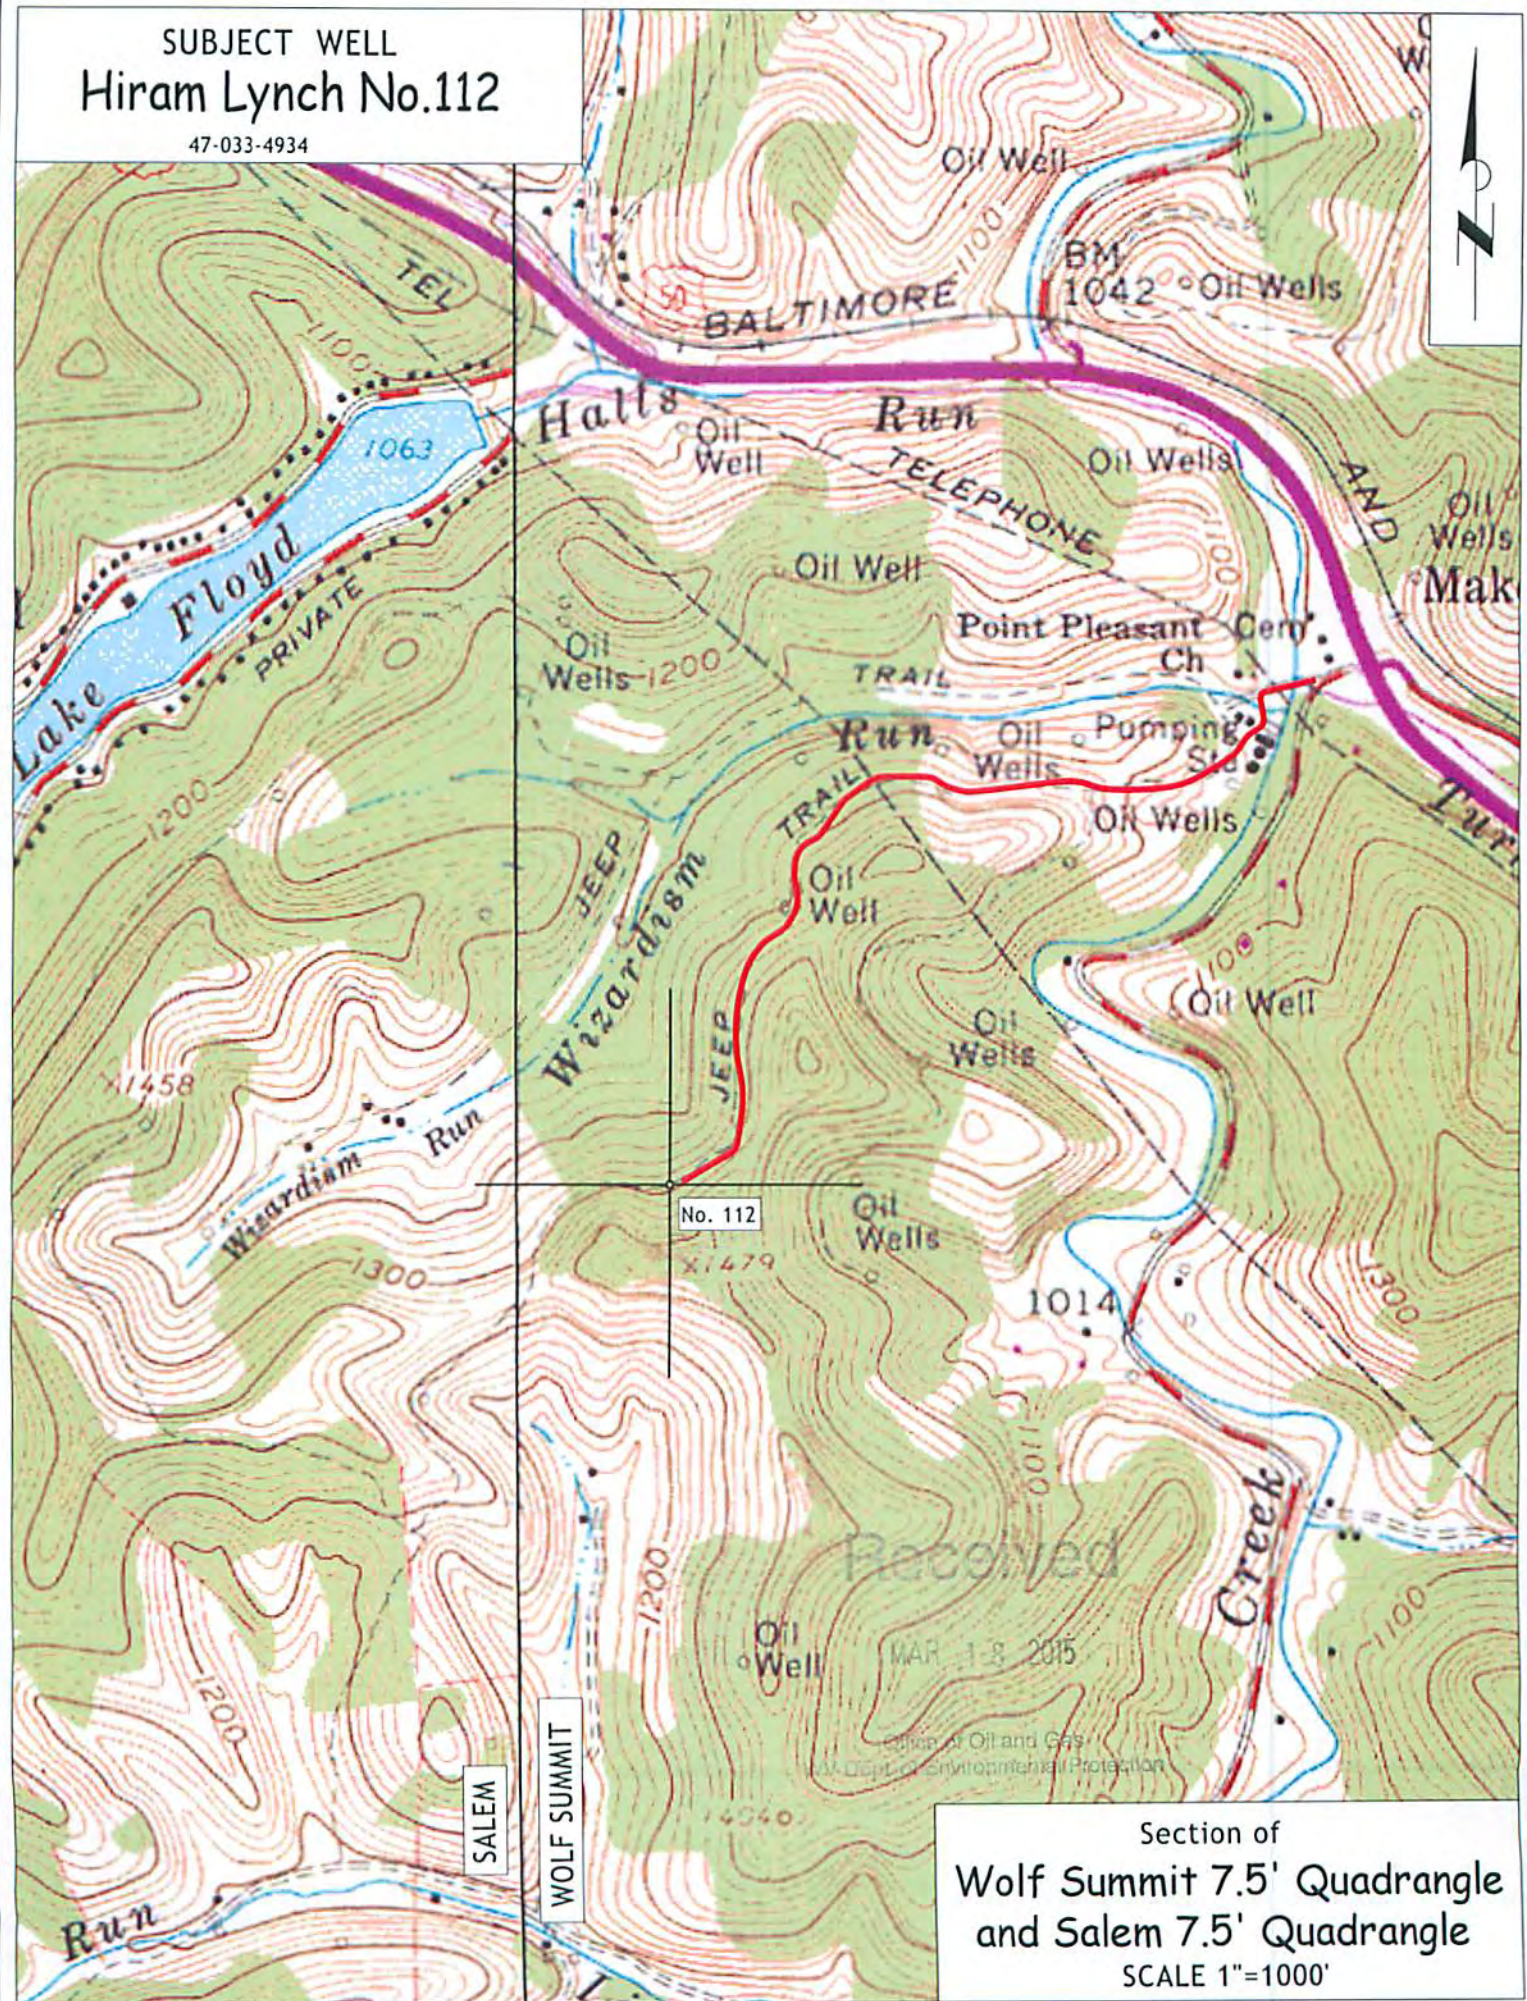

SALEM

WOLF SUMMIT

No. 112

X1479

1014

MAR 18 2015

Office of Oil and Gas
NY Dept. of Environmental Protection

Section of
Wolf Summit 7.5' Quadrangle
and Salem 7.5' Quadrangle
 SCALE 1"=1000'