

3305223 P

WW-7
8-30-06



West Virginia Department of Environmental Protection
Office of Oil and Gas

WELL LOCATION FORM: GPS

API: 47-033-05223-00 WELL NO.: Morrison Unit 3H

FARM NAME: Male, Kimberly A.

RESPONSIBLE PARTY NAME: Antero Resources Corporation

COUNTY: Harrison DISTRICT: Coal

QUADRANGLE: Wolf Summit

SURFACE OWNER: Kimberly A. Male

ROYALTY OWNER: Michael J. Francis

UTM GPS NORTHING: 4350085.34

UTM GPS EASTING: 550899.41 GPS ELEVATION: 1219'

The Responsible Party named above has chosen to submit GPS coordinates in lieu of preparing a new well location plat for a plugging permit or assigned API number on the above well. The Office of Oil and Gas will not accept GPS coordinates that do not meet the following requirements:

1. Datum: NAD 1983, Zone: 17 North, Coordinate Units: meters, Altitude: height above mean sea level (MSL) – meters.
2. Accuracy to Datum – 3.05 meters
3. Data Collection Method:
Survey grade GPS : Post Processed Differential

Real-Time Differential

Mapping Grade GPS : Post Processed Differential

Real-Time Differential

4. Letter size copy of the topography map showing the well location.

I the undersigned, hereby certify this data is correct to the best of my knowledge and belief and shows all the information required by law and the regulations issued and prescribed by the Office of Oil and Gas.

Ashli Steele
Signature


Permitting Supervisor
Title

12/30/2014
Date

RECEIVED
Office of Oil and Gas

FEB 6 2015

WV Department of
Environmental Protection

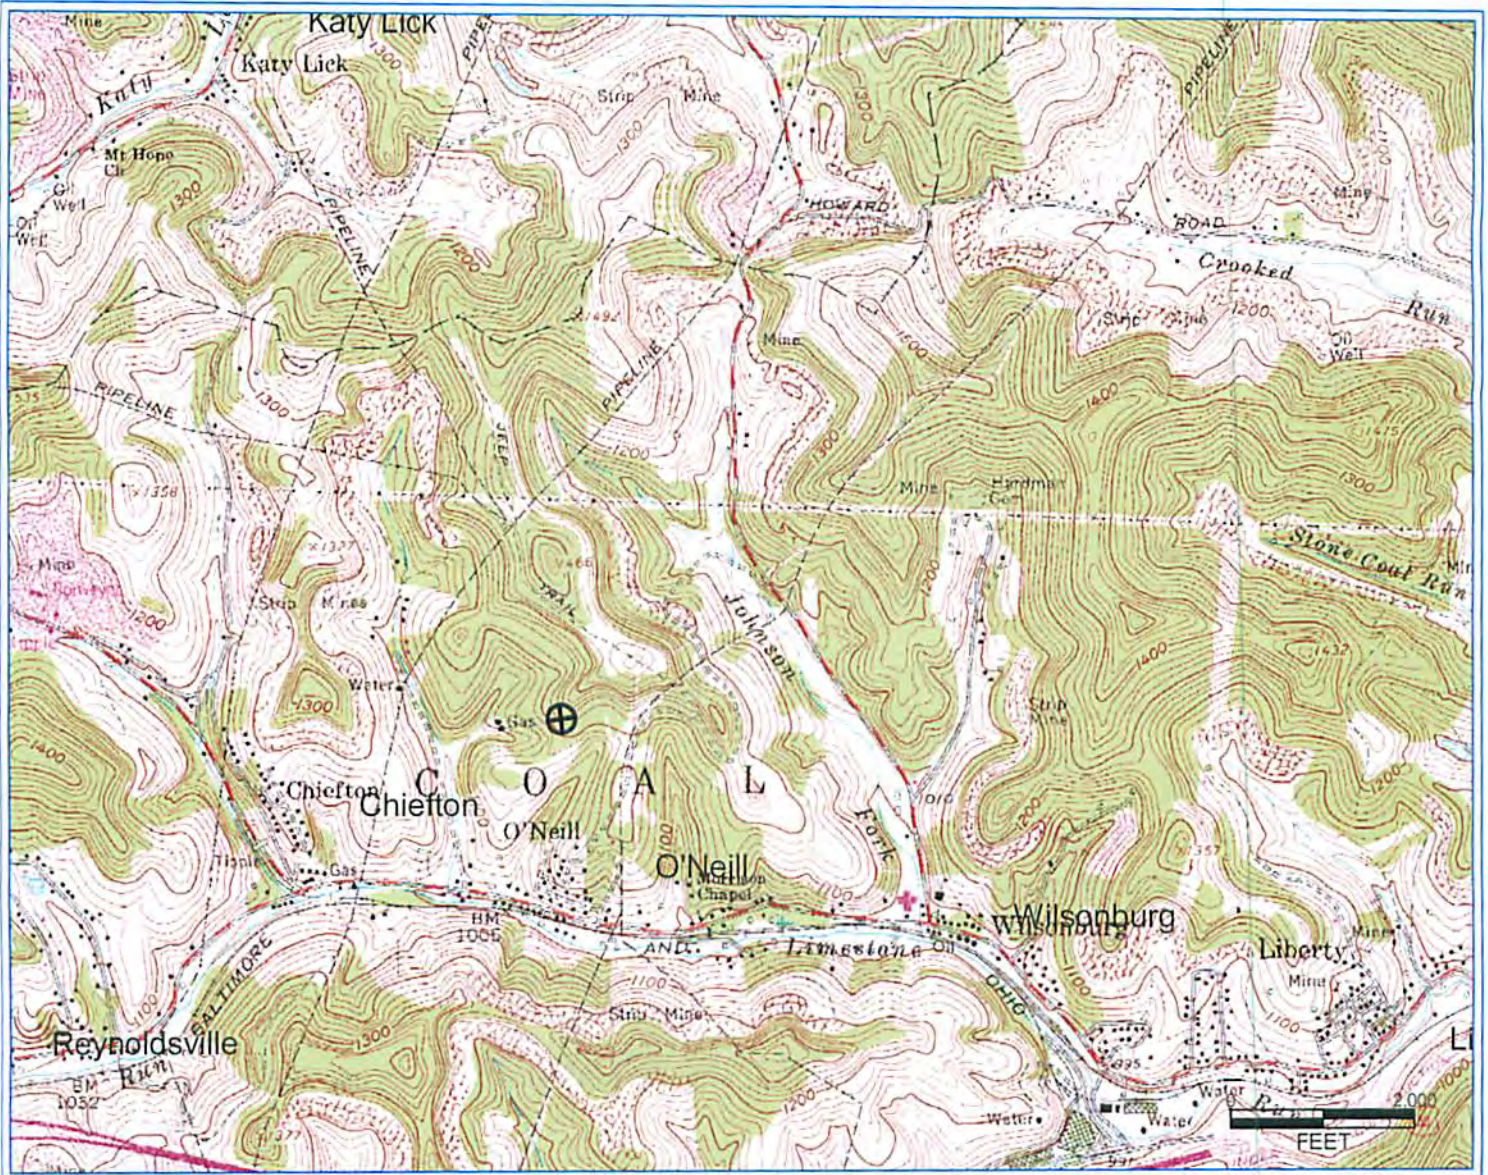

PETRA 2/18/2009 10:24:28 AM

RECEIVED
 Office of Oil and Gas
 NOV 17 2014
 WV Department of
 Environmental Protection

Antero Resources Corporation
APPALACHIAN BASIN
Morrison Unit 3H
Harrison County
REMARKS QUADRANGLE: WOLF SUMMIT WATERSHED: WEST FORK DISTRICT: COAL
January 9, 2009