

JK

WR-35
Rev (9-11)

State of West Virginia
Department of Environmental Protection
Office of Oil and Gas
Well Operator's Report of Well Work

DATE: 9/26/2013
API #: 47-033-05623

Farm name: Myer, Everette M. Jr. Operator Well No.: Thaddeus Unit 1H

LOCATION: Elevation: 1358' Quadrangle: Big Isaac

District: Union County: Harrison
Latitude: 3.435' Feet South of 39 Deg. 12 Min. 30 Sec.
Longitude 6.954' Feet West of 80 Deg. 30 Min. 00 Sec.

Company: Antero Resources Corporation

Address:	Casing & Tubing	Used in drilling	Left in well	Cement fill up Cu. Ft.
1625 17th Street Denver, CO 80202	20" 94#	42'	42'	40 Cu. Ft. Class A
Agent: CT Corporation System	13 3/8" 48#	333'	333'	462 Cu. Ft. Class A
Inspector: Sam Ward	9 5/8" 36#	2,540'	2,540'	1034 Cu. Ft. Class A
Date Permit Issued: 7/9/2012	5 1/2" 20#	13,105'	13,105'	3184 Cu. Ft. Class H
Date Well Work Commenced: 9/30/2012				
Date Well Work Completed: 5/23/2013	2 3/8" 4.7#	7,394'		
Verbal Plugging: N/A				
Date Permission granted on: N/A				
Rotary <input checked="" type="checkbox"/> Cable <input type="checkbox"/> Rig <input type="checkbox"/>				
Total Vertical Depth (ft): 7327' TVD (Deepest Point Drilled)				
Total Measured Depth (ft): 13,105' MD, 7281' TVD (BHL)				
Fresh Water Depth (ft.): 70'				
Salt Water Depth (ft.): 500'				
Is coal being mined in area (N/Y)? No				
Coal Depths (ft.): 263', 490', 554, 1329'				
Void(s) encountered (N/Y) Depth(s) None				

OPEN FLOW DATA (If more than two producing formations please include additional data on separate sheet)

Producing formation Marcellus Pay zone depth (ft) 7284' (TOP)

Gas: Initial open flow ---- MCF/d Oil: Initial open flow ---- Bbl/d

Final open flow 6197 MCF/d Final open flow ---- Bbl/d

Time of open flow between initial and final tests ---- Hours

Static rock Pressure 3600 psig (surface pressure) after ---- Hours

Second producing formation _____ Pay zone depth (ft) _____

Gas: Initial open flow _____ MCF/d Oil: Initial open flow _____ Bbl/d

Final open flow _____ MCF/d Final open flow _____ Bbl/d

Time of open flow between initial and final tests _____ Hours

Static rock Pressure _____ psig (surface pressure) after _____ Hours

RECEIVED
Office of Oil and Gas

DEC 09 2013

WV Department of
Environmental Protection

I certify under penalty of law that I have personally examined and am familiar with the information submitted on this document and all the attachments and that, based on my inquiry of those individuals immediately responsible for obtaining the information I believe that the information is true, accurate, and complete.

Kallen Buck
Signature

12/6/13
Date

04/04/2014

Were core samples taken? Yes _____ No Were cuttings caught during drilling? Yes _____ No Were Electrical, Mechanical or Geophysical logs recorded on this well? If yes, please list Yes- CBLThis is a subsequent well. Antero only runs wireline logs on the first well on a multi-well pad (Thaddeus Unit 2H API#47-033-05622). Please reference the wireline logs submitted with Form WR-35 for Thaddeus Unit 2H.

NOTE: IN THE AREA BELOW PUT THE FOLLOWING: 1). DETAILS OF PERFORATED INTERVALS, FRACTURING OR STIMULATING, PHYSICAL CHANGE, ETC. 2). THE WELL LOG WHICH IS A SYSTEMATIC DETAILED GEOLOGICAL RECORD OF THE TOPS AND BOTTOMS OF ALL FORMATIONS, INCLUDING COAL ENCOUNTERED BY THE WELLBORE FROM SURFACE TO TOTAL DEPTH.

Perforated Intervals, Fracturing, or Stimulating:

Perforations: 7,486- 13, 048' MD (1,152 Holes)

Frac'd w/ 8,500 gals 15% HCL Acid, 121,184 Slick Water carrying 496,700# 100 mesh,
1,972,600# 40/70 sand and 1,061,900# 20/40 sand.

Plug Back Details Including Plug Type and Depth(s): N/A

Formations Encountered: _____ Top Depth _____ / _____ Bottom Depth
Surface:

Big Lime	est 1960'	2065'
Big Injun	est 2066'	2314'
Gantz Sand	est 2315'	2429'
Fifty Foot Sandstone	est 2430'	2522'
Gordon	est 2523'	2831'
Fifth Sandstone	est 2832'	2871'
Bayard	est 2872'	3530'
Speechley	est 3531'	3774'
Balltown	est 3775'	4289'
Bradford	est 4290'	4842'
Benson	est 4843'	5041'
Alexander	est 5042'	5190'
Elk	est 5191'	5851'
Rhinestreet	est 5852'	6627'
Sycamore	est 6628'	6881'
Middlesex	6882'	7069'
Burkett	7070'	7093'
Tully	7094'	7209'
Hamilton	7210'	7283'
Marcellus	7284'	7327' TVD

33-05623



Antero Resources
Thaddeus Unit 1H
Harrison County West Virginia
Northing: 14231174.64
Easting: 1778731.85
Original Wellpath

WELL DETAILS: Thaddeus Unit 1H						
+N/-S	+E/-W	Northing	Ground Level: 1358.0	Latitude	Longitude	Slot
0.0	0.0	14231174.64		1778731.8539° 11' 20.891 N80° 30' 42.645 W		

DESIGN TARGET DETAILS								
Name	TVD	+N/-S	+E/-W	Northing	Easting	Latitude	Longitude	Shape
SHL Thaddeus Unit 1H	0.0	0.0	0.0	14231174.64	1778731.8539° 11' 20.891 N80° 30' 42.645 W			Point
Actual BHL Thaddeus Unit 1H	7328.0	-5828.4		1678.6 14225346.28	1780410.4539° 10' 23.173 N80° 30' 21.722 W			Point
PBHL TGT Thaddeus 1H	7333.0	-5828.4		1678.6 14225346.28	1780410.4539° 10' 23.173 N80° 30' 21.722 W			Point



REFERENCE INFORMATION
 Coordinate (N/E) Reference: Well Thaddeus Unit 1H, Grid North
 Vertical (TVD) Reference: Thaddeus 1H 1358 GL + 28 KB @ 1386.0ufft
 Section (VS) Reference: Slot - (0.0N, 0.0E)
 Measured Depth Reference: Thaddeus 1H 1358 GL + 28 KB @ 1386.0ufft
 Calculation Method: Minimum Curvature

PROJECT DETAILS: Harrison County West Virginia
 Geodetic System: Universal Transverse Mercator (US Survey Feet)
 Datum: NAD 1927 (NADCON CONUS)
 Ellipsoid: Clarke 1866
 Zone: Zone 17N (84 W to 78 W)
 System Datum: Mean Sea Level

LEGEND

- Thaddeus Unit 1H, Original Wellpath, Plan 2 Post Gyro V0
- Thaddeus Unit 2H, Original Wellpath, Original Wellpath V0
- Original Wellpath

DESIGN TARGET DETAILS							
Name	TVD	+N/-S	+E/-W	Northing	Easting	Latitude	Longitude
SHL Thaddeus Unit 1H	0.0	0.0	0.0	14231174.64	1778731.8539° 11' 20.891 N80° 30' 42.645 W		
Actual BHL Thaddeus Unit 1H	7328.0	-5828.4		1678.614225346.28	1780410.4539° 10' 23.173 N80° 30' 21.722 W		
SHL (UTM meters)				4,337,889m	542,173m		
BHL (UTM meters)				4,335,113m	542,582m		

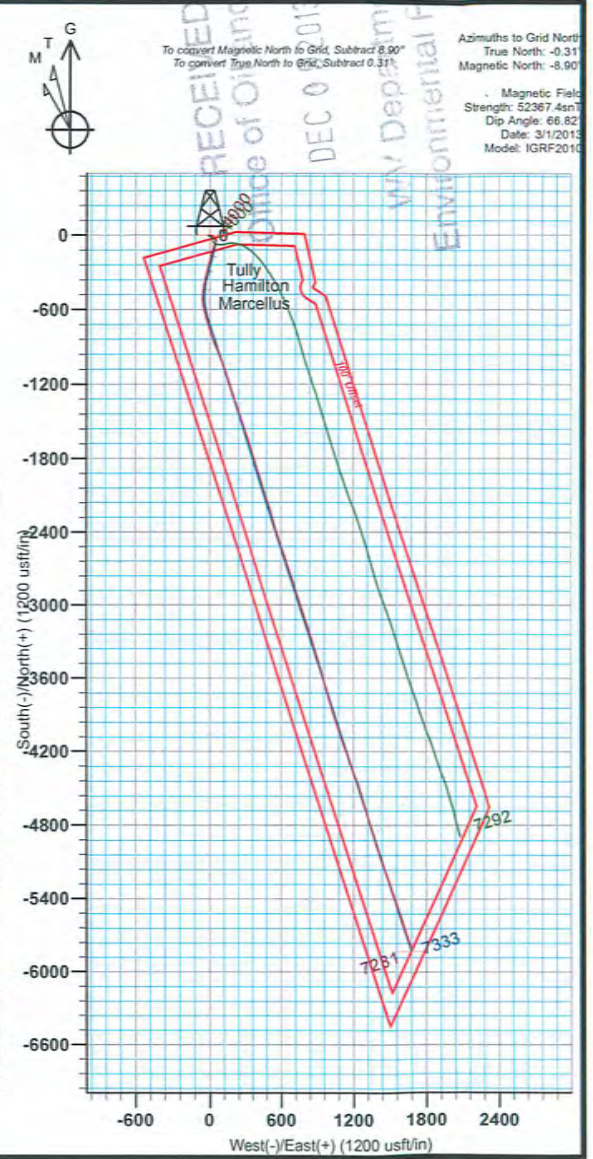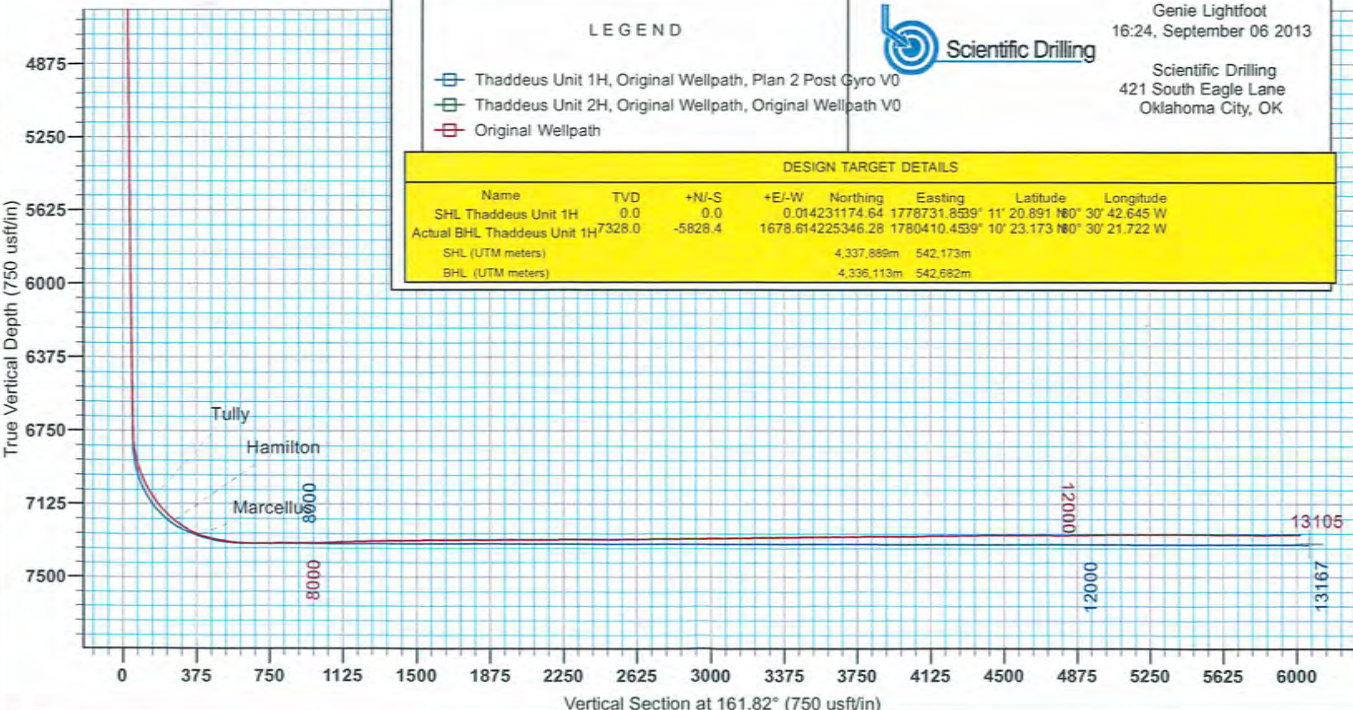

RECEIVED
 Office of Oil and Gas
 DEC 0 2013
 Environmental Protection
 Department of

Azimuths to Grid North
 True North: -0.31
 Magnetic North: -8.90
 Magnetic Field
 Strength: 52367.4nT
 Dip Angle: 66.82
 Date: 3/1/2013
 Model: IGRF2010

33-05623

Hydraulic Fracturing Fluid Product Component Information Disclosure

Job Start Date:	5/18/2013
Job End Date:	5/23/2013
State:	West Virginia
County:	Harrison
API Number:	47-033-05623-00-00
Operator Name:	Antero Resources Corporation
Well Name and Number:	Thaddeus Unit 1H
Longitude:	-80.51184440
Latitude:	39.18913610
Datum:	NAD27
Federal/Tribal Well:	NO
True Vertical Depth:	7,281
Total Base Water Volume (gal):	5,089,728
Total Base Non Water Volume:	



RECEIVED
Office of Oil and Gas
DEC 09 2013
WV Department of
Environmental Protection

Hydraulic Fracturing Fluid Composition:

Trade Name	Supplier	Purpose	Ingredients	Chemical Abstract Service Number (CAS #)	Maximum Ingredient Concentration in Additive (% by mass)**	Maximum Ingredient Concentration in HF Fluid (% by mass)**	Comments
Water	ANTERO RESOURCES	Water					
			Water	7732-18-5	100.00000	91.24647	
WV Specific 40/70 mesh Sand	Nabors Completion and Production Services	Sand - Bulk - West Virginia					
			Crystalline Silica, quartz	14808-60-7	99.90000	4.75400	
			Aluminum Oxide	1344-28-1	1.10000	0.05235	
			Iron Oxide	1309-37-1	0.10000	0.00476	
			Titanium Oxide	13463-67-7	0.10000	0.00476	
WV Specific 20/40 mesh Sand	Nabors Completion and Production Services	Sand - Bulk - West Virginia					
			Crystalline Silica, quartz	14808-60-7	99.90000	2.50864	
			Aluminum Oxide	1344-28-1	1.10000	0.02762	
			Titanium Oxide	13463-67-7	0.10000	0.00251	
			Iron Oxide	1309-37-1	0.10000	0.00251	
WV Specific 100 mesh Sand	Nabors Completion and Production Services	Sand - Bulk - West Virginia					
			Crystalline Silica, quartz	14808-60-7	99.90000	1.10550	
			Aluminum Oxide	1344-28-1	1.10000	0.01217	

33-05623

			Iron Oxide	1309-37-1	0.10000	0.00111	
			Titanium Oxide	13463-67-7	0.10000	0.00111	
WFR-3B	Nabors Completion and Production Services	Friction Reducer					
			Hydrotreated light distillates, non-aromatic, BTEX free	64742-47-8	50.00000	0.02942	
			Ethoxylated alcohols	68551-12-2	15.00000	0.00883	
			Ethoxylated oleylamine	26635-93-8	5.00000	0.00294	
HCl Acid (12.5%-18.0%)	Nabors Completion and Production Services	Bulk Acid					
			Hydrogen Chloride	7647-01-0	18.00000	0.04032	
LSG-100L	Nabors Completion and Production Services	Gelling Agents					
			Petroleum Distillates	64742-47-8	70.00000	0.03379	
Super GREEN SOLV	Nabors Completion and Production Services	Paraffin & Scale Additives					
			BTEX Free Aliphatic Hydrocarbon	64742-96-7	100.00000	0.00966	
OB-2	Nabors Completion and Production Services	Gel Breakers					
			Ammonium Persulfate	7727-54-0	100.00000	0.00741	
			Sillica, crystalline quartz	7631-86-9	10.00000	0.00074	
KR-153SL	Nabors Completion and Production Services	Biocides					
			Polyethylene-Glycol	25322-68-3	50.00000	0.00542	
			2,2-dibromo-3-nitripropionamide	10222-01-2	20.00000	0.00217	
EB-4L	Nabors Completion and Production Services	Gel Breakers					
			Water	7732-18-5	100.00000	0.00059	
			Breaker Component	Proprietary	100.00000	0.00059	
			Cellulase enzyme	Proprietary	100.00000	0.00059	
			Demulsifier Base	Proprietary	100.00000	0.00059	
			Sugar	57-50-1	100.00000	0.00059	
			Ethylene Glycol	107-21-1	40.00000	0.00024	
Acid Inhibitor 2 (AI-2)	Nabors Completion and Production Services	Acid Corrosion Inhibitors					
			Glycol Ethers	111-46-6	40.00000	0.00016	
			Propargyl Alcohol	107-19-7	40.00000	0.00016	
			Isopropyl Alcohol	67-63-0	40.00000	0.00016	
			Ethoxylated Nonylphenol	68412-54-4	13.00000	0.00005	
			Tar bases, quinoline derivs, benzyl chloride-quaternized	72480-70-7	10.00000	0.00004	

Ingredients shown above are subject to 29 CFR 1910.1200(i) and appear on Material Safety Data Sheets (MSDS). Ingredients shown below are Non-MSDS.

3305623

Other Ingredients	Nabors Completion and Production Services	Other Ingredients					
		Water	7732-18-5	87.50000	0.19600		
		guar gum	9000-30-0	50.00000	0.02413		
		Polyacrylamide	57-55-6	40.00000	0.02354		
		Water	7732-18-5	40.00000	0.02354		
		Water	7732-18-5	60.00000	0.01020		
		Propylene glycol	57-55-6	15.00000	0.00883		
		Water	7732-18-5	80.00000	0.00868		
		Proprietary	Proprietary	50.00000	0.00850		
		Proprietary	Proprietary	15.00000	0.00255		
		Proprietary	Proprietary	15.00000	0.00255		
		Proprietary	Proprietary	15.00000	0.00255		
		vinylidene chloride-methyl acrylate copolymer	25038-72-6	20.00000	0.00148		
		Surfactant	68439-51-0	2.00000	0.00097		
		Crystalline Silica (in the form of quartz)	14808-60-7	2.00000	0.00097		
		Microparticle	Proprietary	1.00000	0.00059		
		Water	7732-18-5	48.00000	0.00019		
		2-Butoxyethanol	111-76-2	13.00000	0.00005		
		Dioxane	123-91-1	1.00000	0.00000		
		Organophylic Clay	68953-58-2				

* Total Water Volume sources may include fresh water, produced water, and/or recycled water
 ** Information is based on the maximum potential for concentration and thus the total may be over 100%

Note: For Field Development Products (products that begin with FDP), MSDS level only information has been provided. Ingredient information for chemicals subject to 29 CFR 1910.1200(i) and Appendix D are obtained from suppliers Material Safety Data Sheets (MSDS)