

LEGEND

- LEASE LINE: Dashed line
- SURFACE LINE: Solid line
- WELL LATERAL: Dotted line
- OFFSET LINE: Long dashed line
- THE LINE: Solid line
- CREEK: Wavy line
- ROAD: Solid line with double dashes
- COUNTY ROUTE: Solid line with 'R' markers
- PROPOSED WELL: Circle with 'P'
- EXISTING WELL: Circle with 'E'
- PERMITTED WELL: Circle with 'M'
- LEASE TAG: Circle with letter



**ARSENAL RESOURCES
PRITT SOUTH 201**

(S.P.C. NORTH ZONE) (UTM(M) ZONE 17 NORTH)

NAD83 S.P.C.(FT)	N. 272,351.0	E. 1,773,927.0
NAD83 GEO.	LAT-(N) 39.245707	LONG-(W) 80.187032
NAD83 UTM (M)	N. 4,344,358.4	E. 570,152.6

LANDING POINT

NAD83 S.P.C.(FT)	N. 271,430.8	E. 1,772,996.0
NAD83 GEO.	LAT-(N) 39.243161	LONG-(W) 80.190295
NAD83 UTM (M)	N. 4,344,073.3	E. 569,873.7

BOTTOM HOLE

NAD83 S.P.C.(FT)	N. 260,939.9	E. 1,776,614.0
NAD83 GEO.	LAT-(N) 39.214434	LONG-(W) 80.177241
NAD83 UTM (M)	N. 4,340,895.4	E. 571,029.1

PRITT SOUTH 201 WELL TIES

LINE	BEARING	DISTANCE
L1	N 11°33' E	1463.30'
L2	S 51°23' E	3343.70'
L3	S 74°23' W	7182.26'
L4	S 19°02' E	636.74'

TAG	SURFACE OWNER	TAX MAP PARCEL	ACREAGE
HARRISON COUNTY			
A	IRA H & LAURA E. PRITT	351-4	69.09
B	JULIA L. CRIM	351-15.3	4.19
C	JULIA CRIM	351-15.8	31.00
D	GERALD BURNER ET AL.	351-20	40.25
E	ROGER P. II & MELISSA L. SUTER	351-29	54.00
F	ECOSYSTEM INVESTMENT PARTNERS III LLC	351-31	120.73
G	ROGER P. II & MELISSA L. SUTER	371-4.1	27.6611
H	ECOSYSTEM INVESTMENT PARTNERS III LLC	371-4	27.7921
I	ECOSYSTEM INVESTMENT PARTNERS III LLC	371-6	99.83
J	ECOSYSTEM INVESTMENT PARTNERS III LLC	371-3	95.988
K	ECOSYSTEM INVESTMENT PARTNERS III LLC	371-9	105.48
BARBOUR COUNTY			
L	BECKWITH LUMBER CO. INC.	11-1.2	177.5
M	ELEEN MARIE MILLER	11-2	59.3
N	RANDY & KIMBERLY SPEELMAN	11-5.1	23.21

LEGEND

- AS DRILLED: Solid red line
- PROPOSED: Dashed green line

AS-DRILLED B.H.

AS DRILLED COORDINATES FOR WELL NO. 201

(S.P.C. NORTH ZONE) (UTM(M) ZONE 17 NORTH)

NAD83 S.P.C.(FT)	N. 272,351.0	E. 1,773,927.0
NAD83 GEO.	LAT-(N) 39.245707	LONG-(W) 80.187032
NAD83 UTM (M)	N. 4,344,358.4	E. 570,152.6

LANDING POINT

NAD83 S.P.C.(FT)	N. 271,309.9	E. 1,773,040.6
NAD83 GEO.(DD)	LAT-(N) 39.242830	LONG-(W) 80.190134
NAD83 UTM (M)	N. 4,344,006.7	E. 569,987.9


BOTTOM HOLE

NAD83 S.P.C.(FT)	N. 260,885.3	E. 1,776,648.2
NAD83 GEO.(DD)	LAT-(N) 39.214285	LONG-(W) 81.177119
NAD83 UTM (M)	N. 4,340,879.0	E. 571,039.8

SLS
Land & Energy Development
Solutions from the ground up.
P.O. Box 150 • 12 Vanhorn Drive • Glenview, WV 26351 • (304) 482-5634
www.slsd.com

NOTES ON SURVEY

- NO WATER WELLS WERE FOUND WITHIN 250' OF PROPOSED GAS WELL. NO AGRICULTURAL BUILDINGS > 2500 SQ. FT. OR DWELLINGS WERE FOUND WITHIN 625' OF THE CENTER OF PROPOSED WELL PAD.
- WELL SPOT CIRCLE & TOPO MARK SCALE IS 1"=2000'
- AS-DRILLED DATA PROVIDED BY ARSENAL RESOURCES.

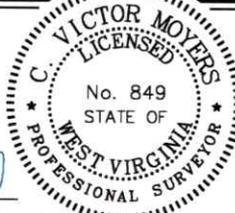

I THE UNDERSIGNED, HEREBY CERTIFY THAT THIS PLAT IS CORRECT TO THE BEST OF MY KNOWLEDGE AND BELIEF AND SHOWS ALL THE INFORMATION REQUIRED BY LAW AND THE REGULATIONS ISSUED AND PRESCRIBED BY THE DIVISION OF ENVIRONMENTAL PROTECTION.

P.S. *C. Victor Moyers*
849

(+) DENOTES LOCATION OF WELL ON UNITED STATES TOPOGRAPHIC MAPS.

DATE AUGUST 16, 20 19

REVISED _____

OPERATORS WELL NO. PRITT SOUTH 201

API WELL NO. 47-033-5900

STATE PA COUNTY CO PERMIT _____

MINIMUM DEGREE OF ACCURACY 1/2500 FILE NO. 8383AD201.dwg

HORIZONTAL & VERTICAL CONTROL DETERMINED BY DGPS (SURVEY GRADE TIE TO CORS NETWORK) SCALE 1" = 2000'

STATE OF WEST VIRGINIA
DIVISION OF ENVIRONMENTAL PROTECTION
OFFICE OF OIL AND GAS

WELL TYPE: OIL _____ GAS X LIQUID INJECTION _____ WASTE DISPOSAL _____ IF "GAS" PRODUCTION X STORAGE _____ DEEP _____ SHALLOW X

LOCATION: ELEVATION EXISTING 1,343.80' / PROPOSED 1,345.90' WATERSHED BEARDS RUN & PIGTAIL RUN

DISTRICT SIMPSON COUNTY HARRISON QUADRANGLE BROWNTON 7.5'

SURFACE OWNER IRA & LAURA PRITT ACREAGE 69.096±

ROYALTY OWNER IRA & LAURA PRITT ET AL ACREAGE 69.096±

PROPOSED WORK: DRILL X CONVERT _____ DRILL DEEPER _____ REDRILL _____ FRACTURE OR STIMULATE X PLUG OFF OLD FORMATION _____ PERFORATE NEW FORMATION _____ PLUG AND ABANDON _____ CLEAN OUT AND REPLUG _____ OTHER _____

PHYSICAL CHANGE IN WELL (SPECIFY) _____ TARGET FORMATION MARCELLUS

ESTIMATED DEPTH 19,271.9' TMD / 7,690' TVD

WELL OPERATOR ARSENAL RESOURCES DESIGNATED AGENT WILLIAM VEIGEL

ADDRESS 6031 WALLACE RD. EXT. SUITE 300 ADDRESS 65 PROFESSIONAL PLACE

WEXFORD, PA 15090 BRIDGEPORT, WV 26330

02/13/2026

5,768' T.H. 2,996' B.H. 2,962' B.H.

ARSENAL RESOURCES PRITT SOUTH 201

(S.P.C. NORTH ZONE) (UTM(M) ZONE 17 NORTH)

NAD'83 S.P.C.(FT) N. 272,351.0 E. 1,773,927.0
 NAD'83 GEO. LAT-(N) 39.245707 LONG-(W) 80.187032
 NAD'83 UTM (M) N. 4,344,358.4 E. 570,152.6

LANDING POINT

NAD'83 S.P.C.(FT) N. 271,430.8 E. 1,772,996.0
 NAD'83 GEO. LAT-(N) 39.243161 LONG-(W) 80.190295
 NAD'83 UTM (M) N. 4,344,073.3 E. 569,873.7


BOTTOM HOLE

NAD'83 S.P.C.(FT) N. 260,939.9 E. 1,776,614.0
 NAD'83 GEO. LAT-(N) 39.214434 LONG-(W) 80.177241
 NAD'83 UTM (M) N. 4,340,895.4 E. 571,029.1

PRITT SOUTH 201 WELL TIES

LINE	BEARING	DISTANCE
L1	N 11°33' E	1463.30'
L2	S 51°23' E	3343.70'
L3	S 74°23' W	1182.26'
L4	S 19°02' E	636.74'

TAG	SURFACE OWNER	TAX MAP/ PARCEL	ACREAGE
HARRISON COUNTY			
A	IRA H. & LAURA E. PRITT	351-4	69.09±
B	JULIA L. CRIM	351-15.3	4.19±
C	JULIA CRIM	351-15.8	31.00±
D	GERALD BURNER, ET AL	351-20	40.25±
E	ROGER P. II & MELISSA L. SUTER	351-29	54.00±
F	ECOSYSTEM INVESTMENT PARTNERS III LLC	351-31	120.73±
G	ROGER P. II & MELISSA L. SUTER	371-4.1	27.661±
H	ECOSYSTEM INVESTMENT PARTNERS III LLC	371-4	27.792±
I	ECOSYSTEM INVESTMENT PARTNERS III LLC	371-6	99.83±
J	ECOSYSTEM INVESTMENT PARTNERS III LLC	371-3	95.988±
K	ECOSYSTEM INVESTMENT PARTNERS III LLC	371-9	105.48±
BARBOUR COUNTY			
L	BECKWITH LUMBER CO. INC.	11-1.2	177.5±
M	ELEN MARIE MILLER	11-2	59.3±
N	RANDY & KIMBERLY SPELLMAN	11-5.1	23.21±

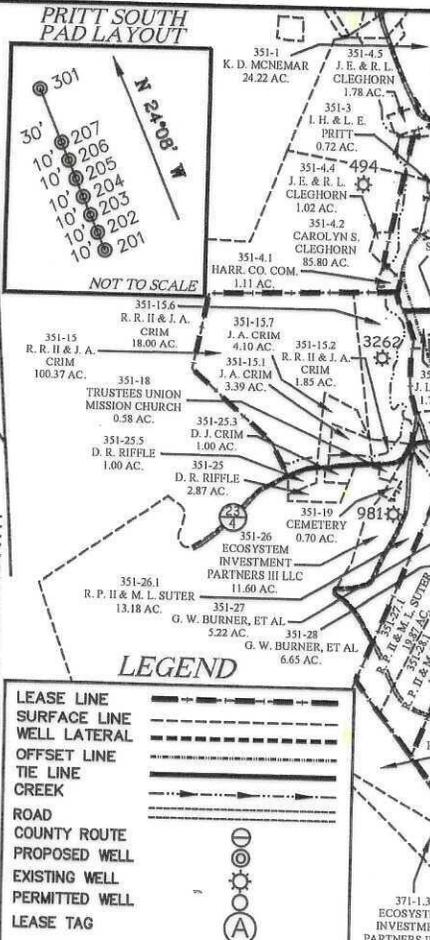

SLS
Land & Energy Development
Solutions from the ground up.
P.O. Box 150 ♦ 12 Vanhorn Drive ♦ Glenville, WV 26351 ♦ (304) 462-5634
www.sls-wv.com

NOTES ON SURVEY

- NO WATER WELLS WERE FOUND WITHIN 250' OF PROPOSED GAS WELL. NO AGRICULTURAL BUILDINGS > 2500 SQ. FT. OR DWELLINGS WERE FOUND WITHIN 625' OF THE CENTER OF PROPOSED WELL PAD.
- WELL SPOT CIRCLE & TOPO MARK SCALE IS 1"=2000'
- AS-DRILLED DATA PROVIDED BY ARSENAL RESOURCES.

B.H. AS-DRILLED B.H.

AS-DRILLED COORDINATES FOR WELL NO. 201

(S.P.C. NORTH ZONE) (UTM(M) ZONE 17 NORTH)


NAD'83 S.P.C.(FT) N. 272,351.0 E. 1,773,927.0
 NAD'83 GEO. LAT-(N) 39.245707 LONG-(W) 80.187032
 NAD'83 UTM (M) N. 4,344,358.4 E. 570,152.6

LANDING POINT

NAD'83 S.P.C.(FT) N. 271,309.9 E. 1,773,040.6
 NAD'83 GEO.(DD) LAT-(N) 39.242830 LONG-(W) 80.190134
 NAD'83 UTM (M) N. 4,344,036.7 E. 569,887.8

BOTTOM HOLE

NAD'83 S.P.C.(FT) N. 260,885.3 E. 1,776,648.2
 NAD'83 GEO.(DD) LAT-(N) 39.214285 LONG-(W) 81.177119
 NAD'83 UTM (M) N. 4,340,879.0 E. 571,039.8

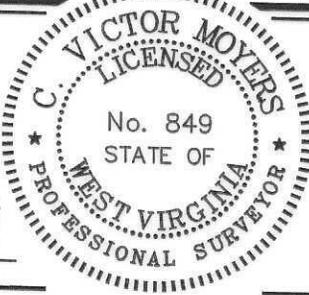

I THE UNDERSIGNED, HEREBY CERTIFY THAT THIS PLAT IS CORRECT TO THE BEST OF MY KNOWLEDGE AND BELIEF AND SHOWS ALL THE INFORMATION REQUIRED BY LAW AND THE REGULATIONS ISSUED AND PRESCRIBED BY THE DIVISION OF ENVIRONMENTAL PROTECTION.

P.S. 849 *C. Victor Moyers*

(+) DENOTES LOCATION OF WELL ON UNITED STATES TOPOGRAPHIC MAPS.

DATE AUGUST 16, 20 19

REVISED _____

OPERATORS WELL NO. PRITT SOUTH 201

API WELL NO. 47 - 033 - 5900

STATE COUNTY PERMIT

MINIMUM DEGREE OF ACCURACY 1 / 2500 FILE NO. 8383AD201.dwg

HORIZONTAL & VERTICAL CONTROL DETERMINED BY DGPS (SURVEY GRADE TIE TO CORS NETWORK) SCALE 1" = 2000'

STATE OF WEST VIRGINIA
DIVISION OF ENVIRONMENTAL PROTECTION
OFFICE OF OIL AND GAS

WELL TYPE: OIL GAS LIQUID WASTE IF INJECTION DISPOSAL "GAS" PRODUCTION STORAGE DEEP SHALLOW

LOCATION: ELEVATION EXISTING: 1,343.80' / PROPOSED: 1,345.90' WATERSHED BEARDS RUN & PIGTAIL RUN

DISTRICT SIMPSON COUNTY HARRISON QUADRANGLE BROWNTON 7.5'

SURFACE OWNER IRA & LAURA PRITT ACREAGE 69.09±

ROYALTY OWNER IRA & LAURA PRITT ET AL ACREAGE 69.09±

PROPOSED WORK: DRILL CONVERT DRILL DEEPER REDRILL FRACTURE OR STIMULATE PLUG OFF OLD FORMATION PERFORATE NEW FORMATION PLUG AND ABANDON CLEAN OUT AND REPLUG OTHER

PHYSICAL CHANGE IN WELL (SPECIFY) _____ TARGET FORMATION MARCELLUS

ESTIMATED DEPTH 19,271.9' TMD / 7,690' TVD

WELL OPERATOR ARSENAL RESOURCES DESIGNATED AGENT WILLIAM VEIGEL

ADDRESS 6031 WALLACE RD. EXT. SUITE 300 ADDRESS 65 PROFESSIONAL PLACE

WEXFORD, PA 15090 BRIDGEPORT, WV 26330

COUNTY NAME _____ PERMIT _____

02/13/2026