


Notes: Well No.
Schoen 1205 S-8H
WVCS 1927, North Zone
Top Hole Coordinates
Lat: 39°09'05.00"
Lon: 80°21'08.15"
Landing Point Coordinates
Lat: 39°09'03.87"
Lon: 80°21'04.66"
Bottom Hole Coordinates
Lat: 39°05'15.43"
Lon: 80°19'16.93"

Notes: Well No.
Schoen 1205 S-8H
UTM NAD 1983 (USSF)
Top Hole Coordinates
N: 14,218,431.91'
E: 1,824,095.14'
Landing Point Coordinates
N: 14,218,319.92'
E: 1,824,371.05'
Bottom Hole Coordinates
N: 14,195,279.07'
E: 1,833,027.97'

Notes: Well No.
Schoen 1205 S-8H
UTM NAD 1983 (Meters)
Top Hole Coordinates
N: 4,333,786.714m
E: 555,985.311m
Landing Point Coordinates
N: 4,333,752.579m
E: 556,069.408m
Bottom Hole Coordinates
N: 4,326,729.714m
E: 558,708.043m

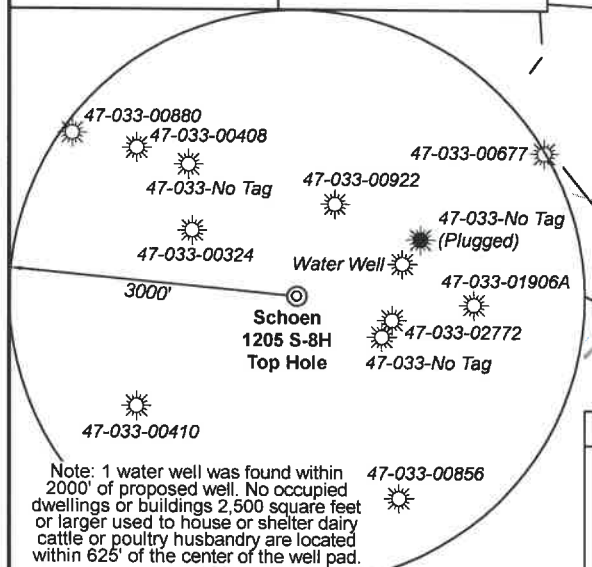


Tag	Bearing	Dist.
L1	S 70°59' E	1,526.3'
L2	S 56°31' E	1,300.3'
L3	N 87°54' W	1,224.8'
L4	N 71°53' W	992.8'

5,367' to Top Hole

TOP LATITUDE 39 - 10 - 00 00 30
BTM LATITUDE 39 - 07 - 30 - -



TOP HOLE LONGITUDE 80
BTM HOLE LONGITUDE 80
——5,563' to Top Hole—

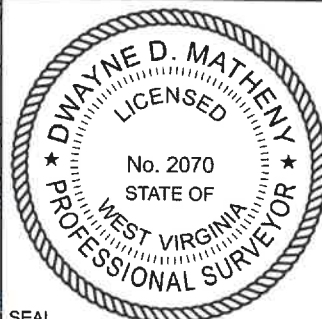

I, the undersigned, hereby certify that this plat is correct to the best of my knowledge and belief and shows all the information required by law and the rules issued and prescribed by the Department of Environmental Protection.

Dwayne D. Matheny, P.S. 2070

FILE NO: 32-36-G-19

DRAWING NO: Schoen 1205 S-8H Well Plat

SCALE: 1" = 2000'

MINIMUM DEGREE OF ACCURACY:
Submeter

PROVEN SOURCE OF ELEVATION:
CORS, Bridgeport, WV

STATE OF WEST VIRGINIA
DEPARTMENT OF ENVIRONMENTAL PROTECTION
OIL AND GAS DIVISION

DATE: May 2 20 25

OPERATOR'S WELL NO. Schoen 1205 S-8H

API WELL NO

47 — 033 — 06002
STATE COUNTY PERMIT

WELL TYPE: ☐ OIL ☒ GAS ☐ LIQUID INJECTION ☐ WASTE DISPOSAL
(IF GAS) PRODUCTION: ☐ STORAGE ☐ DEEP ☒ SHALLOW

LOCATION: ELEVATION: 1,407.3' WATERSHED: Middle West Fork Creek

DISTRICT: Grant / Hackers Creek

SURFACE OWNER: George & Rosanne Schoen

ROYALTY OWNER: Willa Post Robey, et al

LEASE NO: _____ ACREAGE: 78.20

PROPOSED WORK: ☒ DRILL ☐ CONVERT ☐ DRILL DEEPER ☐ FRACTURE OR STIMULATE ☐ PLUG OFF OLD FORMATION
☐ PERFORATE NEW FORMATION ☒ OTHER PHYSICAL CHANGE IN WELL (SPECIFY) As-Drilled

☐ PLUG AND ABANDON ☐ CLEAN OUT AND REPLUG TARGET FORMATION: Marcellus Shale ESTIMATED DEPTH: 7,553' TVD
32,582' MD

WELL OPERATOR: HG Energy II Appalachia, LLC


ADDRESS: 5260 Dupont Road

Parkersburg, WV 26101

DESIGNATED AGENT: Diane C. White

ADDRESS: 5260 Dupont Road

Parkersburg, WV 26101

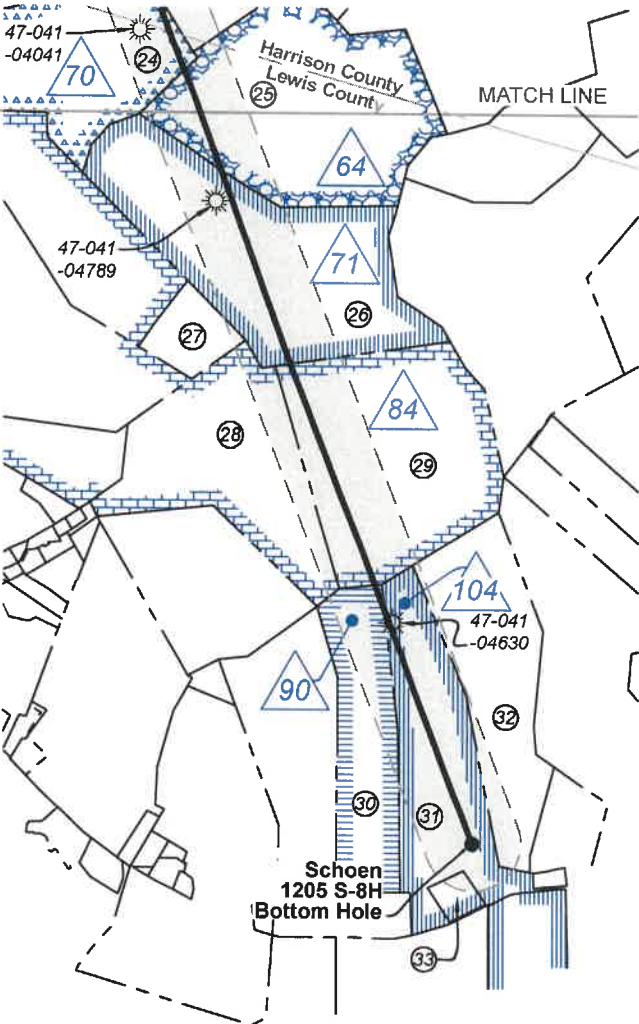


Legend

- Proposed gas well
- Well Reference, as noted
- Monument, as noted
- Existing Well, as noted
- Existing Plugged Well, as noted
- Digitized Well, as noted
- Creek or Drain
- Existing Road
- Surface boundary (approx.)


ID	Lease
1	A.B. Post, et al
4	John H. & Charlotte C. Gerlach
6	Susan V. Curry, et al
9	L.D. & Addie Swisher
11	P.T. Allman
12	French S. & Anna J. Young
14	M.M.F. & S.F. Randolph
19	Sidney & Virginia Haymond
20	Alcinda B. & M.E. Jackson
21	Patricia B. Smith, et al
64	Melvina E. Cookman
70	Mary Alkire
71	Allie B. & M.E. Jackson, et al
84	George & Ella Cummings
90	Claudia P. & Charles C. Blake
104	Walter J. Neely Trust

Harrison County				
No.	TM / Par	Owner	Bk / Pg	Ac.
1	447 / 2	George & Rosanne Schoen	1148 / 1059	65.00
2	447 / 3	George & Rosanne Schoen	1253 / 302	10.06
3	446 / 29	John F. McCuskey II, et al	1121 / 25	75.00
4	447 / 20	Richard & Janet Stout	1175 / 320	51.00
5	447 / 4.13	Richard & Janet Sprout	1389 / 669	5.04
6	447 / 21	Richard & Rebecca Sprout	1600 / 849	6.09
7	447 / 22	Daniel & Stacie Cooley	1310 / 1072	18.59
8	447 / 33	Joseph C. Queen	1349 / 508	20.00
9	447 / 34	Sharon K. Patsy J. Salate	1360 / 84	43.00
10	447 / 35	Kenneth Maxwell & Patricia Myers	1311 / 423	11.67
11	447 / 43	Betty J. & Isaac H. Maxwell III	1543 / 141	123.95
12	467 / 1	Margaret L. Gyimesi	1306 / 775	78.79
13	467 / 2	Jackson L. Smith	1378 / 976	95.16
14	467 / 1.1	Margaret Gyimesi	1306 / 775	1.45
15	467 / 30	William L. Randolph, et ux	1518 / 19	73.73
16	467 / 33.1	Eugene W. Hanby	1428 / 1	4.76
17	467 / 33.2	Charles R. Sutton	1472 / 181	1.03
18	467 / 33	Charles R. & Franklin L. Sutton	1472 / 181	39.20
19	467 / 34	Joseph M. Richards	1439 / 1234	9.15
20	467 / 36	Joseph M. Richards	1439 / 1234	73.93
21	467 / 52	David L. & Lisle C. Hinkle	1282 / 389	175.50
22	487 / 4.1	Catherine A. Mauro	1244 / 135	95.45
23	487 / 5	Kimberly & Terri Glaze Wriston	W 83 / 97	129.62
Lewis County				
24	10C / 11	Thomas C. Kennedy Testamentary Trust	W34 / 428	92.50
25	10C / 16	Thomas C. Kennedy Testamentary Trust	W34 / 428	105.00
26	10C / 15	Thomas C. Kennedy Testamentary Trust	W34 / 428	107.00
27	10D / 38	George W. Dawson	542 / 376	9.00
28	10D / 10	George W. & Amy J. Dawson	505 / 549	80.00
29	10D / 23	George W. & Amy J. Dawson	505 / 549	96.00
30	10D / 21	George W. & Amy J. Dawson	494 / 115	48.40
31	10D / 20	Jeremy H. Linger, et al	W51 / 755	57.14
32	10D / 32.6	Jeremy H. Linger, et al	W51 / 755	62.33
33	10D / 20.2	Linda Linger	592 / 612	4.00

Wellhead Layout (NTS)

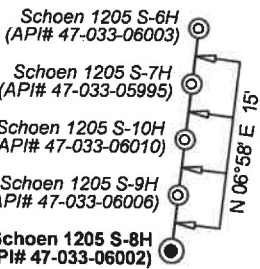

Well Location References
Not to Scale

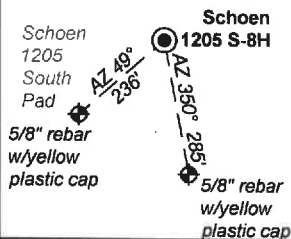

FILE NO: 32-36-G-19

DRAWING NO: Schoen 1205 S-8H Well Plat

SCALE: 1" = 2000'

MINIMUM DEGREE OF ACCURACY:
Submeter

PROVEN SOURCE OF ELEVATION:
CORS, Bridgeport, WV

STATE OF WEST VIRGINIA
DEPARTMENT OF ENVIRONMENTAL PROTECTION
OIL AND GAS DIVISION

DATE: May 2 20 25

OPERATOR'S WELL NO. Schoen 1205 S-8H

API WELL NO

47 — 033 — 06002
STATE COUNTY PERMIT

WELL TYPE: ☐ OIL ☒ GAS ☐ LIQUID INJECTION ☐ WASTE DISPOSAL
(IF GAS) PRODUCTION: ☐ STORAGE ☐ DEEP ☒ SHALLOW

LOCATION: ELEVATION: 1,407.3' WATERSHED: Middle West Fork Creek

DISTRICT: Grant / Hackers Creek

SURFACE OWNER: George & Rosanne Schoen

ROYALTY OWNER: Willa Post Robey, et al

LEASE NO: ACREAGE: 78.20

PROPOSED WORK: ☒ DRILL ☐ CONVERT ☐ DRILL DEEPER ☐ FRACTURE OR STIMULATE ☐ PLUG OFF OLD FORMATION
☐ PERFORATE NEW FORMATION ☒ OTHER PHYSICAL CHANGE IN WELL (SPECIFY) As-Drilled

☐ PLUG AND ABANDON ☐ CLEAN OUT AND REPLUG TARGET FORMATION: Marcellus Shale ESTIMATED DEPTH: 7,553' TVD 32,582' MD

WELL OPERATOR: HG Energy II Appalachia, LLC

DESIGNATED AGENT: Diane C. White

ADDRESS: 5260 Dupont Road

ADDRESS: 5260 Dupont Road


Parkersburg, WV 26101

Parkersburg, WV 26101

Top: Mount Clare
QUADRANGLE: Btm: Berlin

COUNTY: Harrison

ACREAGE: 65.00

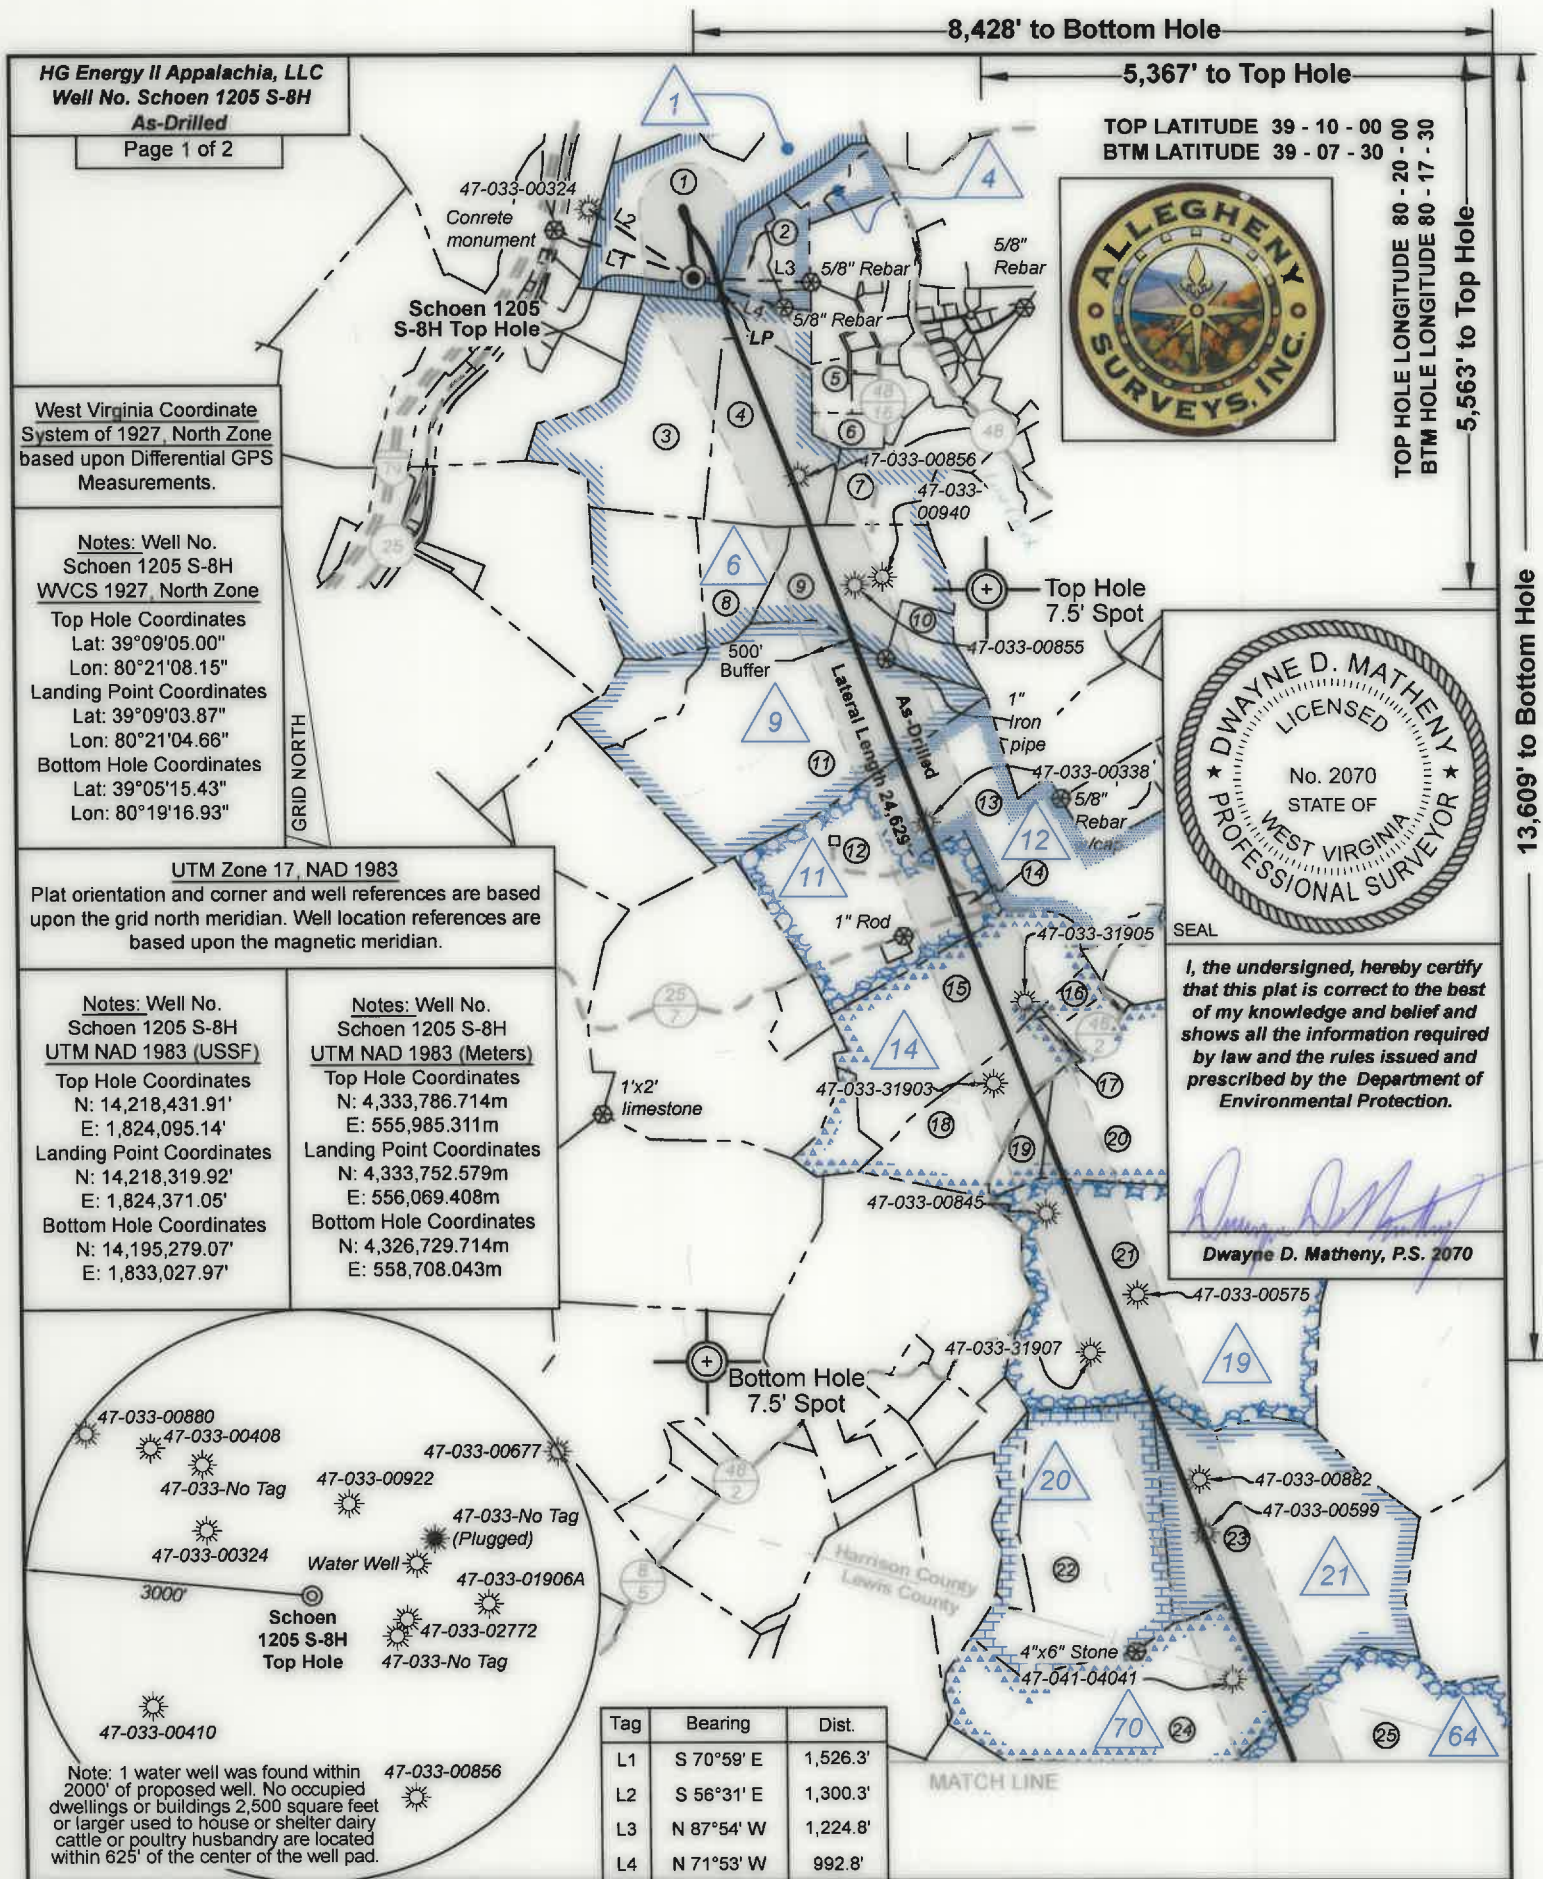

I, the undersigned, hereby certify that this plat is correct to the best of my knowledge and belief and shows all the information required by law and the rules issued and prescribed by the Department of Environmental Protection.

Dwayne D. Matheny, P.S. 2070

FILE NO: 32-36-G-19
DRAWING NO: Schoen 1205 S-8H Well Plat
SCALE: 1" = 2000'
MINIMUM DEGREE OF ACCURACY: Submeter
PROVEN SOURCE OF ELEVATION: CORS, Bridgeport, WV

STATE OF WEST VIRGINIA
DEPARTMENT OF ENVIRONMENTAL PROTECTION
OIL AND GAS DIVISION

DATE: May 2 20 25
OPERATOR'S WELL NO. Schoen 1205 S-8H
API WELL NO
47 - 033 - 06002
STATE COUNTY PERMIT


WELL TYPE: ☐ OIL ☒ GAS ☐ LIQUID INJECTION ☐ WASTE DISPOSAL
(IF GAS) PRODUCTION: ☐ STORAGE ☐ DEEP ☒ SHALLOW

LOCATION: ELEVATION: 1,407.3' WATERSHED: Middle West Fork Creek
DISTRICT: Grant / Hackers Creek

Top: Mount Clare
QUADRANGLE: Btm: Berlin
COUNTY: Harrison / Lewis
ACREAGE: 65.00

SURFACE OWNER: George & Rosanne Schoen
ROYALTY OWNER: Willa Post Robey, et al LEASE NO: ACREAGE: 78.20
PROPOSED WORK: ☒ DRILL ☐ CONVERT ☐ DRILL DEEPER ☐ FRACTURE OR STIMULATE ☐ PLUG OFF OLD FORMATION
☐ PERFORATE NEW FORMATION ☒ OTHER PHYSICAL CHANGE IN WELL (SPECIFY) As-Drilled
☐ PLUG AND ABANDON ☐ CLEAN OUT AND REPLUG TARGET FORMATION: Marcellus Shale ESTIMATED DEPTH: 32,582' MD

WELL OPERATOR: HG Energy II Appalachia, LLC DESIGNATED AGENT: Diane C. White
ADDRESS: 5260 Dupont Road ADDRESS: 5260 Dupont Road
Parkersburg, WV 26101 Parkersburg, WV 26101

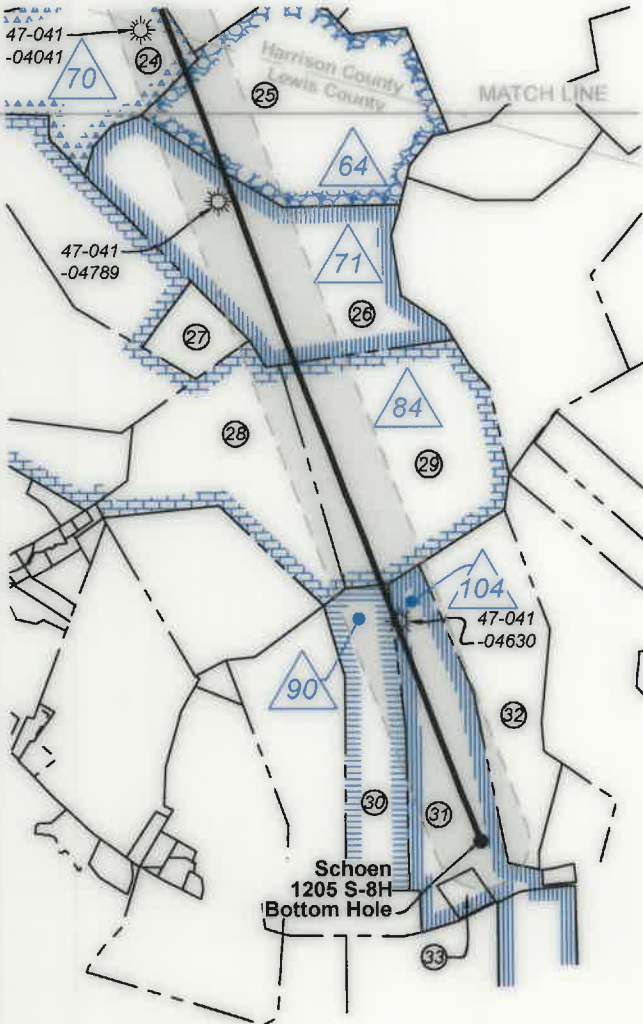


Legend

- Proposed gas well
- Well Reference, as noted
- Monument, as noted
- Existing Well, as noted
- Existing Plugged Well, as noted
- Digitized Well, as noted
- Creek or Drain
- Existing Road
- Surface boundary (approx.)


ID	Lease
1	A B Post, et al
4	John H. & Charlotte C. Gerlach
6	Susan V. Curry, et al
9	L D. & Addie Swisher
11	P T. Allman
12	French S. & Anna J. Young
14	M M F. & S F. Randolph
19	Sidney & Virginia Haymond
20	Alcinda B. & M E. Jackson
21	Patricia B. Smith, et al
64	Melvina E. Cookman
70	Mary Alkire
71	Allie B. & M E. Jackson, et al
84	George & Ella Cummings
90	Claudia P. & Charles C. Blake
104	Walter J. Neely Trust

Harrison County			
No.	TM / Par	Owner	Bk / Pg Ac.
1	447 / 2	George & Rosanne Schoen	1148 / 1059 65.00
2	447 / 3	George & Rosanne Schoen	1253 / 302 10.06
3	446 / 29	John F. McCuskey II, et al	1121 / 25 75.00
4	447 / 20	Richard & Janet Stout	1175 / 320 51.00
5	447 / 4.13	Richard & Janet Sprout	1389 / 669 5.04
6	447 / 21	Richard & Rebecca Sprout	1600 / 849 6.09
7	447 / 22	Daniel & Stacie Cooley	1310 / 1072 16.59
8	447 / 33	Joseph C. Queen	1349 / 508 20.00
9	447 / 34	Sharon K. Patsy J. Salate	1360 / 84 43.00
10	447 / 35	Kenneth Maxwell & Patricia Myers	1311 / 423 11.67
11	447 / 43	Betty J. & Isaac H. Maxwell III	1543 / 141 123.95
12	467 / 1	Margaret L. Gyimesi	1306 / 775 78.79
13	467 / 2	Jackson L. Smith	1378 / 976 95.16
14	467 / 1.1	Margaret Gyimesi	1306 / 775 1.45
15	467 / 30	William L. Randolph, et ux	1518 / 19 73.73
16	467 / 33.1	Eugene W. Hanby	1428 / 1 4.76
17	467 / 33.2	Charles R. Sutton	1472 / 181 1.03
18	467 / 33	Charles R. & Franklin L. Sutton	1472 / 181 39.20
19	467 / 34	Joseph M. Richards	1439 / 1234 9.15
20	467 / 36	Joseph M. Richards	1439 / 1234 73.93
21	467 / 52	David L. & Lisle C. Hinkle	1282 / 389 175.50
22	487 / 4.1	Catherine A. Mauro	1244 / 135 95.45
23	487 / 5	Kimberly & Terri Glaze Wriston	W 83 / 97 129.62
Lewis County			
24	10C / 11	Thomas C. Kennedy Testamentary Trust	W34 / 428 92.50
25	10C / 16	Thomas C. Kennedy Testamentary Trust	W34 / 428 105.00
26	10C / 15	Thomas C. Kennedy Testamentary Trust	W34 / 428 107.00
27	10D / 38	George W. Dawson	542 / 376 9.00
28	10D / 10	George W. & Amy J. Dawson	505 / 549 80.00
29	10D / 23	George W. & Amy J. Dawson	505 / 549 96.00
30	10D / 21	George W. & Amy J. Dawson	494 / 115 48.40
31	10D / 20	Jeremy H. Linger, et al	W51 / 755 57.14
32	10D / 32.6	Jeremy H. Linger, et al	W51 / 755 62.33
33	10D / 20.2	Linda Linger	592 / 612 4.00

Wellhead Layout (NTS)

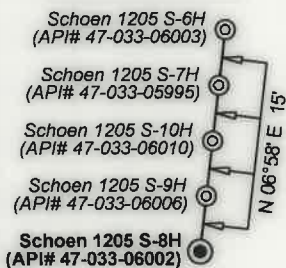

Well Location References
Not to Scale

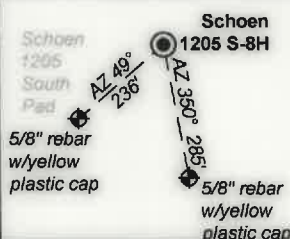

FILE NO: 32-36-G-19

DRAWING NO: Schoen 1205 S-8H Well Plat

SCALE: 1" = 2000'

MINIMUM DEGREE OF ACCURACY:
Submeter

PROVEN SOURCE OF ELEVATION:
CORS, Bridgeport, WV

STATE OF WEST VIRGINIA
 DEPARTMENT OF ENVIRONMENTAL PROTECTION
 OIL AND GAS DIVISION

DATE: May 2 20 25

OPERATOR'S WELL NO. Schoen 1205 S-8H

API WELL NO

47 - 033 - 06002
 STATE COUNTY PERMIT

WELL TYPE: ☐ OIL ☒ GAS ☐ LIQUID INJECTION ☐ WASTE DISPOSAL
 (IF GAS) PRODUCTION: ☐ STORAGE ☐ DEEP ☒ SHALLOW

LOCATION: ELEVATION: 1,407.3' WATERSHED: Middle West Fork Creek

DISTRICT: Grant / Hackers Creek

SURFACE OWNER: George & Rosanne Schoen

ROYALTY OWNER: Willa Post Robey, et al

LEASE NO: ACREAGE: 78.20

PROPOSED WORK: ☒ DRILL ☐ CONVERT ☐ DRILL DEEPER ☐ FRACTURE OR STIMULATE ☐ PLUG OFF OLD FORMATION
☐ PERFORATE NEW FORMATION ☒ OTHER PHYSICAL CHANGE IN WELL (SPECIFY) As-Drilled

☐ PLUG AND ABANDON ☐ CLEAN OUT AND REPLUG TARGET FORMATION: Marcellus Shale ESTIMATED DEPTH: 32,582' MD

WELL OPERATOR: HG Energy II Appalachia, LLC

DESIGNATED AGENT: Diane C. White

ADDRESS: 5260 Dupont Road

ADDRESS: 5260 Dupont Road

Parkersburg, WV 26101

Parkersburg, WV 26101

Top: Mount Clare
 Btm: Berlin
 QUADRANGLE: Harrison / Lewis
 ACREAGE: 65.00

09/19/2025