

COUNTRY SOUTH WELL 2MH - AS-DRILLED			
ID	LEASE NUMBER	LESSOR	LEASE ACREAGE
A	BP049602	A B WILLIS & ET AL	33.00
B	BP053946	MELVILLE WATKINS & ET AL	108.00
C	BP054123	E B CORE ET AL	163.00
D	BP047272	MARY C. ROBINSON ET AL	62.00
E	BP054126	CHARLES L CRAIG ET AL	73.00
F	BP009104	AJ WILLIAMS ET AL	72.00
G	BP037529	B T STROTHER ET AL	112.00
H	BP013936	ELIZABETH M ROSS ET AL	309.00
I	BP024394	M O GOFF ET AL	620.00
J	BP002907	BELLE S PAYNE ET AL	800.00
K	BP045460	J C JOHNSON ET AL	292.00
L	BP045459	A T MCDONALD ET AL	118.00
M	BP045458	J.H. MCDONALD ET AL	45.00

COUNTRY SOUTH WELL 2MH - AS-DRILLED		
ID	SURFACE OWNER	DIST-TM-PAR
1	JAMES D. MILLER ET AL	5-230-45
2	DANAL "PETE" MCMILLION	5-230-44
3	WVDOH	5-230-Unknown
4	J B ANGUS RANCH, LLC	5-250-3.4
5	DAVID A. FREED ET AL	5-250-11.7
6	DAVID A. FREED ET AL	5-250-11
7	3 GUYS DEVELOPMENT LLC	15-250-28
8	CO-TRUSTEES OF THE H. WOOD THRASHER DESCENDANTS TRUST, DATED 1/1/2017	5-250-15
9	MARY G. BRADLEY	15-250-29
10	MARY G. BRADLEY	15-270-12
11	LINDA O. MORGAN	3-14-16
12	MARY V. MORGAN ET AL	15-270-61
13	MARY V. MORGAN ET AL	15-270-22
14	BEAU HENDERSON	15-270-23.4
15	JASON UNDERWOOD	3-14-4.3
16	CLAUDE J. RYAN III ET AL	3-14-4
17	CLAUDE J. RYAN III ET AL	3-19-35.1
18	CLAUDE J. RYAN IV	3-19-35
19	BRW DEVELOPMENT LLC	3-19-3
20	JAMES F. & ELIZABETH A. NUZUM	3-19-3.4
21	RONNIE D. CHRIST & CYNTHIA J. JOHNSTON	3-19B-22
22	NORMA L. & MICHAEL J. STEFFICK	3-19B-21
23	CRAIG & REBECCA AUSMUS	3-19B-27
24	DOUGLAS K. MARTIN	3-19B-12

SEE PAGE 2 FOR PLAT DUE TO LENGTH OF LATERAL

THRASHER

THE THRASHER GROUP, INC.
600 WHITE OAKS BLVD.
BRIDGEPORT, WV 26330
PHONE 304-624-4108


AS-DRILLED PLAT



Diversified
Production LLC

FILE #: T70-11330 COUNTRY WELL PAD
DRAWING #: COUNTRY 2MH AS-DRILLED
SCALE: 1" = 2,000'
DATE: JUNE 17, 2025

I, THE UNDERSIGNED, HEREBY CERTIFY THAT THIS PLAT IS CORRECT TO THE BEST OF MY KNOWLEDGE AND BELIEF AND SHOWS ALL THE INFORMATION REQUIRED BY LAW AND THE REGULATIONS ISSUED AND PRESCRIBED BY THE DEPARTMENT OF ENVIRONMENTAL PROTECTION.

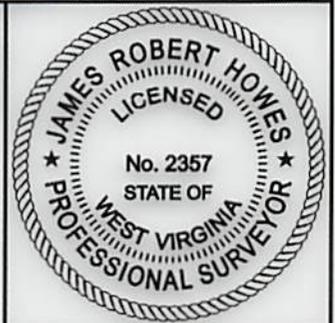

MINIMUM DEGREE OF ACCURACY: 1/2500
PROVEN SOURCE SURVEY GRADE GPS OF ELEVATION: (NAVD 88, US FT)

SIGNED: *James R Howes*
R.P.E.: _____ L.L.S.: P.S. No. 2357



(+) DENOTES LOCATION OF WELL ON UNITED STATES TOPOGRAPHIC MAPS
WVDEP
OFFICE OF OIL & GAS 601
57TH STREET
CHARLESTON, WV 25304

OPERATOR'S WELL #: COUNTRY 2MH AS-DRILLED

API WELL #: 47 33 06024
STATE COUNTY PERMIT

WELL TYPE: OIL WASTE DISPOSAL PRODUCTION DEEP GAS LIQUID INJECTION STORAGE SHALLOW

WATERSHED: THOMAS FORK TO BOOTH'S CREEK ELEVATION: 1,134.30'±

COUNTY/DISTRICT: HARRISON / CLAY-OUTSIDE QUADRANGLE: ROSEMONT, WV 7.5'

SURFACE OWNER: JAMES D. MILLER ET AL ACREAGE: 24.14±

OIL & GAS ROYALTY OWNER: A B WILLIS & ET AL ACREAGE: 33.00±

DRILL DRILL DEEPER REDRILL FRACTURE OR STIMULATE PLUG OFF OLD FORMATION

CONVERT PLUG & ABANDON CLEAN OUT & REPLUG PERFORATE NEW FORMATION

OTHER CHANGE (SPECIFY): _____

TARGET FORMATION: MARCELLUS ESTIMATED DEPTH: (LATERAL)TVD: 7,433'± TMD: 2,439'±

WELL OPERATOR: DIVERSIFIED PRODUCTION, LLC

DESIGNATED AGENT: CHRIS VEASEY

ADDRESS: 101 MCQUISTON DRIVE

ADDRESS: 400 SUMMER STREET

CITY: JACKSON CENTER STATE: PA ZIP CODE: 16133

CITY: CHARLESTON STATE: WV ZIP CODE: 25301


02/06/2026

BHL is located on topo map 8,906 feet south of Latitude: 39° 20' 00"
 SHL is located on topo map 7,850 feet south of Latitude: 39° 22' 30"

COUNTRY 2MH

PAGE 2 OF 2

WELL PAD
 ORIENTATION DETAIL
 NTS

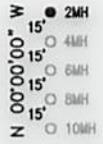

WELL RESTRICTIONS

1. OCCUPIED DWELLING WITHIN 625 FEET OF CENTER OF PAD.
2. NO AGRICULTURE BUILDINGS > 2500 SQ FT. WITHIN 625 FEET OF CENTER OF PAD.
3. NO WATER WELLS OR DEVELOPED SPRINGS ARE WITHIN 250 FEET OF PROPOSED WELL.
4. NO NATURALLY PRODUCING TROUT STREAM WITHIN 300 FEET OF LIMITS OF DISTURBANCE.
5. NO GROUND INTAKE OR PUBLIC WATER SUPPLY WITHIN 1000 FEET OF WELL PAD, LIMITS OF DISTURBANCE, E & S CONTROLS.


NOTES ON SURVEY

1. SURFACE AND ROYALTY OWNER INFORMATION AND THEIR BOUNDARIES SHOWN HEREON WERE PLOTTED FROM DEEDS AND/OR TAX PARCEL MAPS PROVIDED BY CLIENT AND/OR FIELD LOCATIONS.
2. THIS PLAT DOES NOT REPRESENT A BOUNDARY SURVEY OF THE PARCELS SHOWN HEREON.
3. ALL INSETS ARE GRID NORTH UNLESS OTHERWISE DEPICTED.


LINE	BEARING	DISTANCE
L1	N 64°04'15" W	1081.13'
L2	N 46°02'08" W	1107.21'
L3	N 27°27'59" W	647.08'

SURFACE HOLE LOCATION (SHL) - AS-DRILLED	
UTM 17-NAD83 (M):	NAD83, WV NORTH (FT)
NORTHING: 4356298.202	NORTHING: 311650.979
EASTING: 567932.228	EASTING: 1767292.863
LANDING POINT LOCATION (LPL) - AS-DRILLED	
UTM 17-NAD83 (M):	NAD83, WV NORTH (FT)
NORTHING: 4355967.469	NORTHING: 310596.800
EASTING: 567363.406	EASTING: 1765408.290
BOTTOM HOLE LOCATION (BHL) AS-DRILLED	
UTM 17-NAD83 (M):	NAD83, WV NORTH (FT)
NORTHING: 4351361.656	NORTHING: 295391.550
EASTING: 569047.144	EASTING: 1770681.690

**AS-DRILLED
 PLAT**

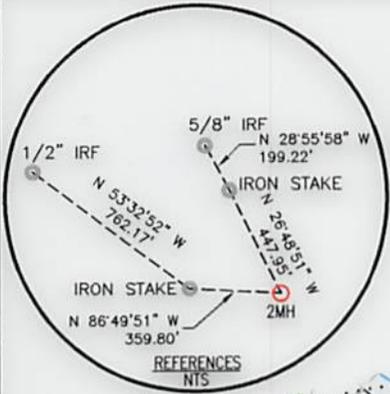


GRID NORTH
 WV STATE PLANE
 NORTH ZONE NAD83 (2011)

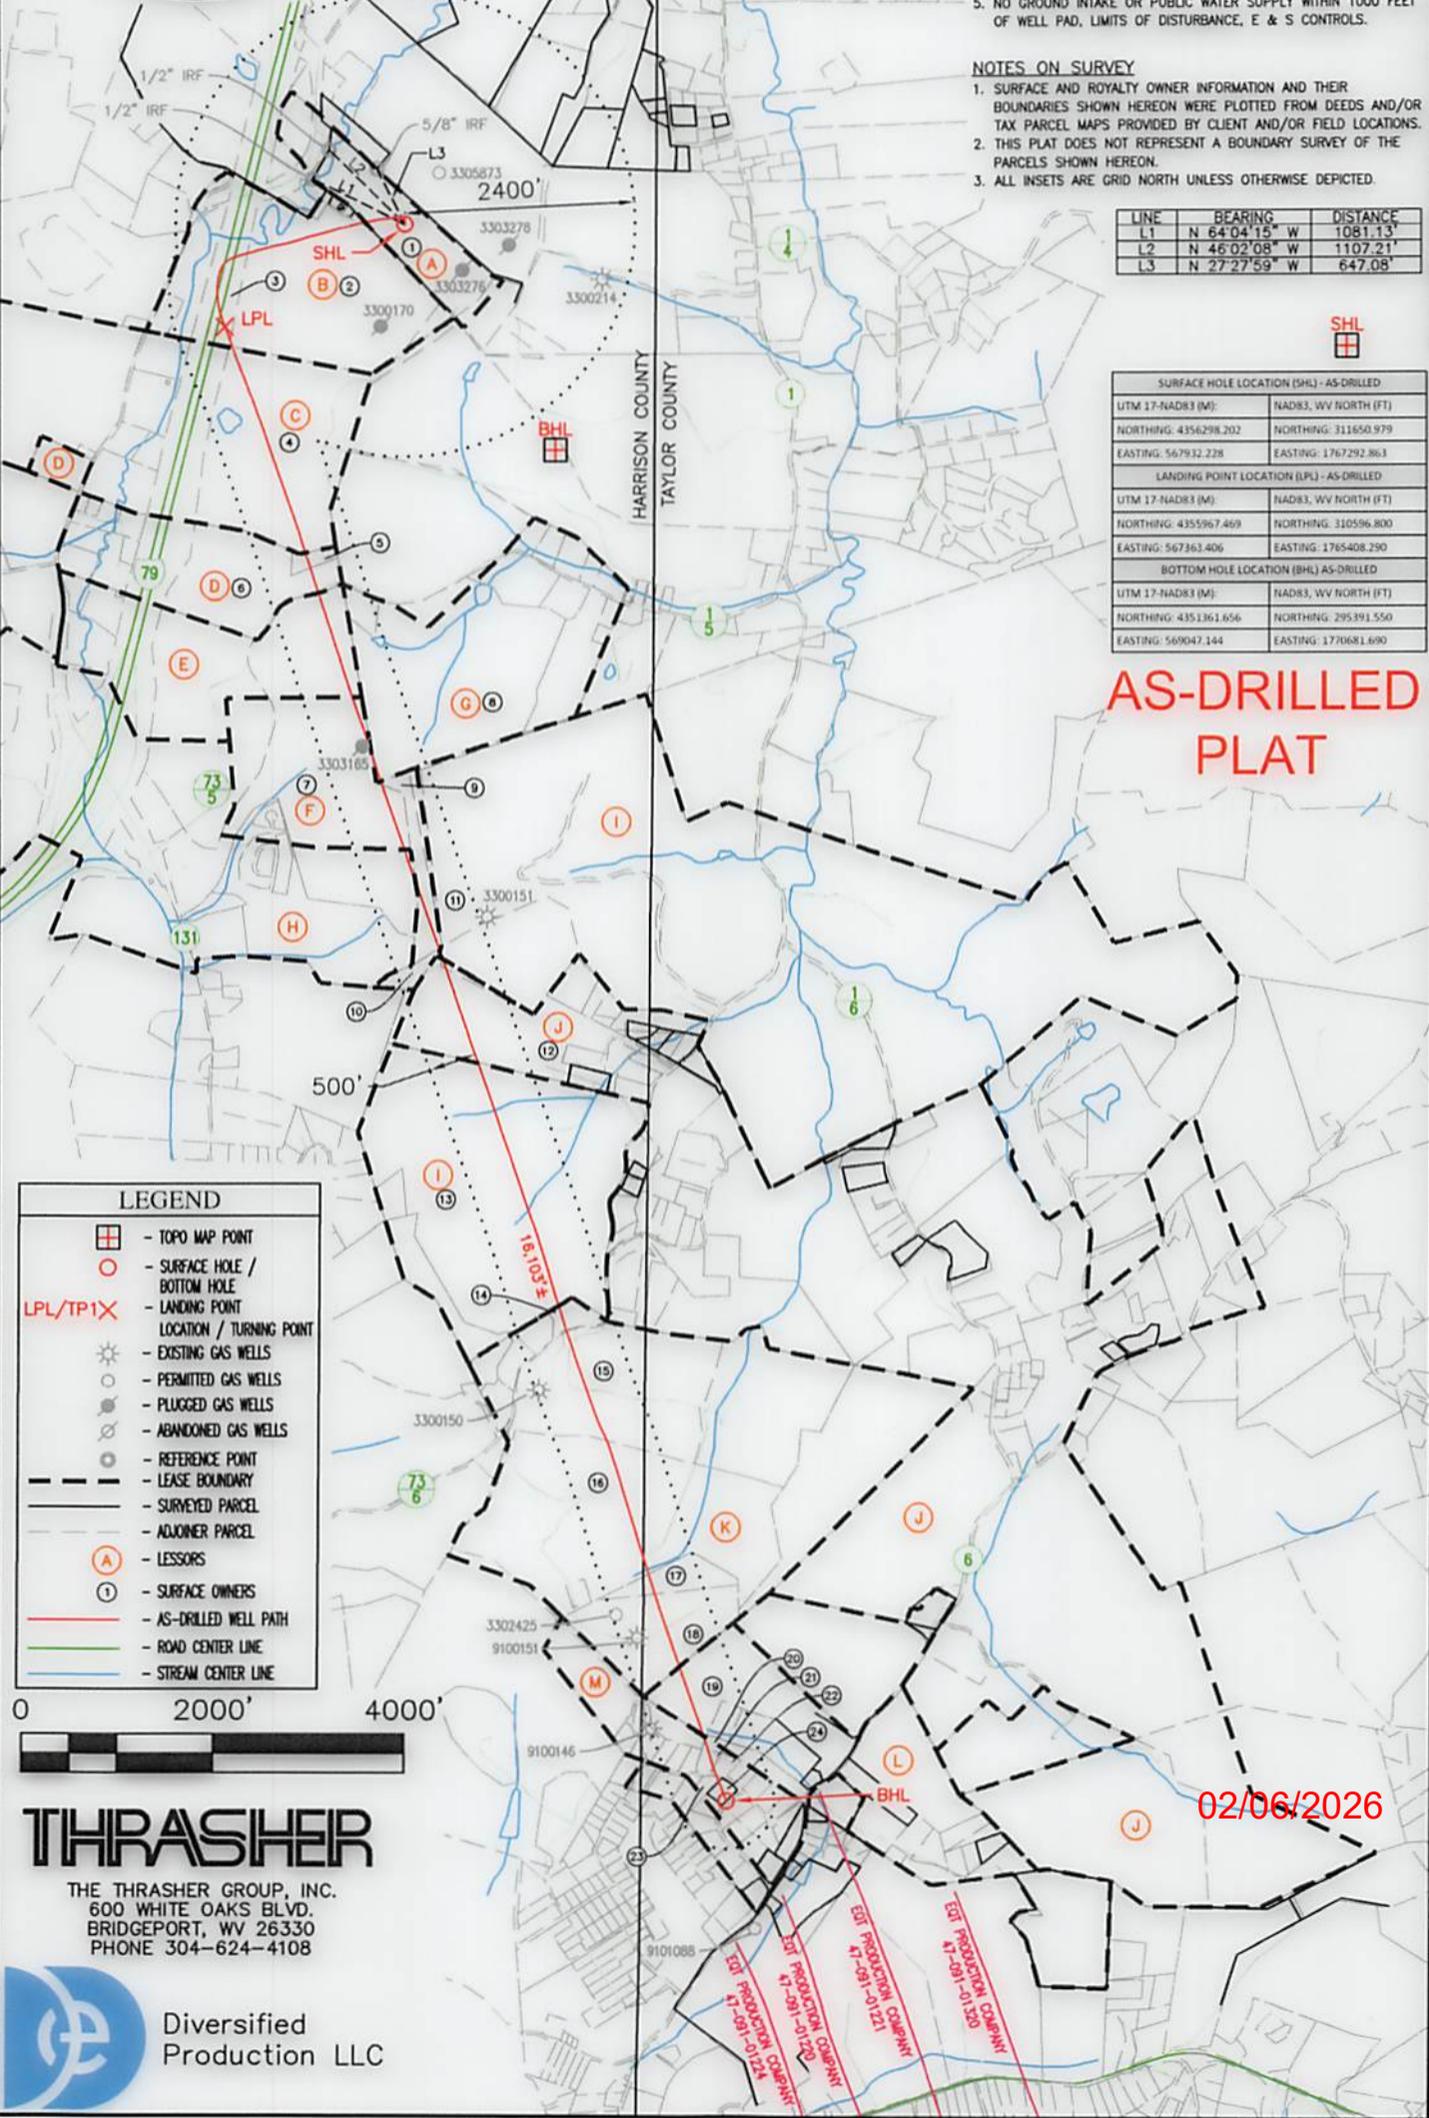

LEGEND

- TOPO MAP POINT
- SURFACE HOLE / BOTTOM HOLE
- LPL/TP1X
- LOCATION / TURNING POINT
- EXISTING GAS WELLS
- PERMITTED GAS WELLS
- PLUGGED GAS WELLS
- ABANDONED GAS WELLS
- REFERENCE POINT
- LEASE BOUNDARY
- SURVEYED PARCEL
- ADJOINER PARCEL
- LESSORS
- SURFACE OWNERS
- AS-DRILLED WELL PATH
- ROAD CENTER LINE
- STREAM CENTER LINE

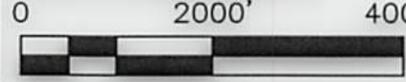

THRASHER
 THE THRASHER GROUP, INC.
 600 WHITE OAKS BLVD.
 BRIDGEPORT, WV 26330
 PHONE 304-624-4108

Diversified
 Production LLC

02/06/2026

BHL is located on topo map 9,184 feet west of Longitude: 80° 10' 00"
 SHL is located on topo map 911 feet west of Longitude: 80° 12' 30"