

COUNTRY SOUTH WELL 10MH - AS-DRILLED			
ID	LEASE NUMBER	LESSOR	LEASE ACREAGE
A	BP049602	A B WILLIS & ET AL	33.00
B	BP048589	J E CORE ET AL	140.00
C	BP044909	C C WILSON ET AL	209.00
D	BP049633	O E CORDER ET AL	10.00
E	BP044943	O E CORDER ET AL	208.00
F	BP037526	MARTHA O. GOFF	36.00
G	BP024534	A. Y. MCELROY ET AL	252.00
H	BP024394	M O GOFF ET AL	620.00
I	BP066927	ELSIE MAY CURRY ET AL	46.00
J	BP002907	BELLE S PAYNE ET AL	800.00
K	BP066886, BP066940	W.E. & C. MORRIS ET AL	6.00
L	BP024359	MARY MCBEE ET AL	114.00

COUNTRY SOUTH WELL 10MH - AS-DRILLED		
ID	SURFACE OWNER	DIST-TM-PAR
1	JAMES D. MILLER ET AL	5-230-45
2	JANICE M. BRENNAN TRUST A	5-230-35
3	JB ANGUS RANCH LLC	3-13-11
4	JB ANGUS RANCH LLC	3-13-11.11
5	JB ANGUS RANCH LLC	3-13-11.1
6	LILA LEE ANDERSON ET AL	3-13-11.3
7	JB ANGUS RANCH LLC	3-13-11.5
8	JB ANGUS RANCH LLC	3-13-10
9	RYAN TIMOTHY & JILL G. MOATS	3-13-21.5
10	DONALD E. NUZUM ET AL	3-13-21.2
11	KRISTIN N. WRIGHT	3-13-21.3
12	KRISTIN N. WRIGHT	3-13-21.4
13	ANTHONY T. & TAMMY L. ROVELLO	3-13-21.1
14	REBECCA A. WARE	3-13-13
15	PATRICIA M. ASHCRAFT	3-13-13.1
16	MARY SUSAN MASON	3-13-16.6
17	EVAN M. KLIETHERMES	3-13-16
18	LINDA O. MORGAN	3-14-16
19	STEVEN R. MORRIS ET AL	3-14-13.1
20	MICHAEL S. BROWN ET AL	3-14-2.7
21	PAUL J. GOBEL JR ET AL	3-14-7.5
22	PAT L. & MIKE A. LUCAS	3-14-7.6
23	PAT L. & MIKE A. LUCAS	3-14-7.7
24	MICHAEL A. LUCAS	3-14-7.4
25	WILLIAM K. & KATHRYN G. WATKINS	3-14-26.2
26	PAMELA R. & ALAN C. SCHROCK	3-14-9.2
27	JAMES C. & DONNA H. GARRETT	3-14-9
28	JAMES C. & DONNA H. GARRETT	3-14-26.5
29	JOSEPH R. GARRETT II ET AL	3-19-6
30	JOSEPH R. GARRETT II ET AL	3-19-8

SEE PAGE 2 FOR PLAT DUE TO LENGTH OF LATERAL

THRASHER


THE THRASHER GROUP, INC.
600 WHITE OAKS BLVD.
BRIDGEPORT, WV 26330
PHONE 304-624-4108



Diversified
Production LLC

FILE #: T70-11330 COUNTRY WELL PAD
DRAWING #: COUNTRY 10MH AS-DRILLED
SCALE: 1" = 2,000'
DATE: JUNE 17, 2025

I, THE UNDERSIGNED, HEREBY CERTIFY THAT THIS PLAT IS CORRECT TO THE BEST OF MY KNOWLEDGE AND BELIEF AND SHOWS ALL THE INFORMATION REQUIRED BY LAW AND THE REGULATIONS ISSUED AND PRESCRIBED BY THE DEPARTMENT OF ENVIRONMENTAL PROTECTION.

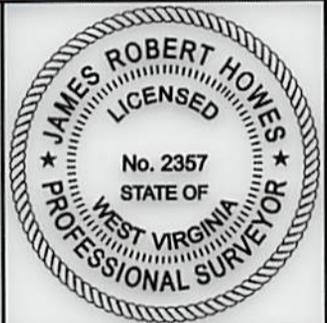

MINIMUM DEGREE OF ACCURACY: 1/2500
PROVEN SOURCE SURVEY GRADE GPS OF ELEVATION: (NAVD 88, US FT)

SIGNED: [Signature]
R.P.E.: _____ L.L.S.: P.S. No. 2357



(+) DENOTES LOCATION OF WELL ON UNITED STATES TOPOGRAPHIC MAPS
WVDEP
OFFICE OF OIL & GAS 601
57TH STREET
CHARLESTON, WV 25304

OPERATOR'S WELL #: COUNTRY 10MH AS-DRILLED

API WELL #: 47 33 06026
STATE COUNTY PERMIT


WELL TYPE: OIL WASTE DISPOSAL PRODUCTION DEEP GAS LIQUID INJECTION STORAGE SHALLOW
WATERSHED: THOMAS FORK TO BOOTH'S CREEK ELEVATION: 1,134.30'±
COUNTY/DISTRICT: HARRISON / CLAY-OUTSIDE QUADRANGLE: ROSEMONT, WV 7.5'
SURFACE OWNER: JAMES D. MILLER ET AL ACREAGE: 24.14±
OIL & GAS ROYALTY OWNER: A B WILLIS & ET AL ACREAGE: 33.00± **02/06/2026**
DRILL DRILL DEEPER REDRILL FRACTURE OR STIMULATE PLUG OFF OLD FORMATION
CONVERT PLUG & ABANDON CLEAN OUT & REPLUG PERFORATE NEW FORMATION
OTHER CHANGE (SPECIFY): _____
TARGET FORMATION: MARCELLUS ESTIMATED DEPTH: (LATERAL)TVD: 7,383'± TMD: 27,172'±

WELL OPERATOR: DIVERSIFIED PRODUCTION, LLC DESIGNATED AGENT: CHRIS VEASEY
ADDRESS: 101 MCQUISTON DRIVE ADDRESS: 400 SUMMER STREET
CITY: JACKSON CENTER STATE: PA ZIP CODE: 16133 CITY: CHARLESTON STATE: WV ZIP CODE: 25301

COUNTRY 10MH

PAGE 2 OF 2

WELL PAD
 ORIENTATION DETAIL
 NTS

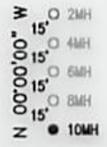


WELL RESTRICTIONS

1. OCCUPIED DWELLING WITHIN 625 FEET OF CENTER OF PAD.
2. NO AGRICULTURE BUILDINGS > 2500 SQ FT. WITHIN 625 FEET OF CENTER OF PAD.
3. NO WATER WELLS OR DEVELOPED SPRINGS ARE WITHIN 250 FEET OF PROPOSED WELL.
4. NO NATURALLY PRODUCING TROUT STREAM WITHIN 300 FEET OF LIMITS OF DISTURBANCE.
5. NO GROUND INTAKE OR PUBLIC WATER SUPPLY WITHIN 1000 FEET OF WELL PAD, LIMITS OF DISTURBANCE, E & S CONTROLS.

NOTES ON SURVEY

1. SURFACE AND ROYALTY OWNER INFORMATION AND THEIR BOUNDARIES SHOWN HEREON WERE PLOTTED FROM DEEDS AND/OR TAX PARCEL MAPS PROVIDED BY CLIENT AND/OR FIELD LOCATIONS.
2. THIS PLAT DOES NOT REPRESENT A BOUNDARY SURVEY OF THE PARCELS SHOWN HEREON.
3. ALL INSETS ARE GRID NORTH UNLESS OTHERWISE DEPICTED.


LINE	BEARING	DISTANCE
L1	N 61° 16' 52" W	1108.68'
L2	N 43° 52' 58" W	1149.67'
L3	N 25° 12' 12" W	700.86'

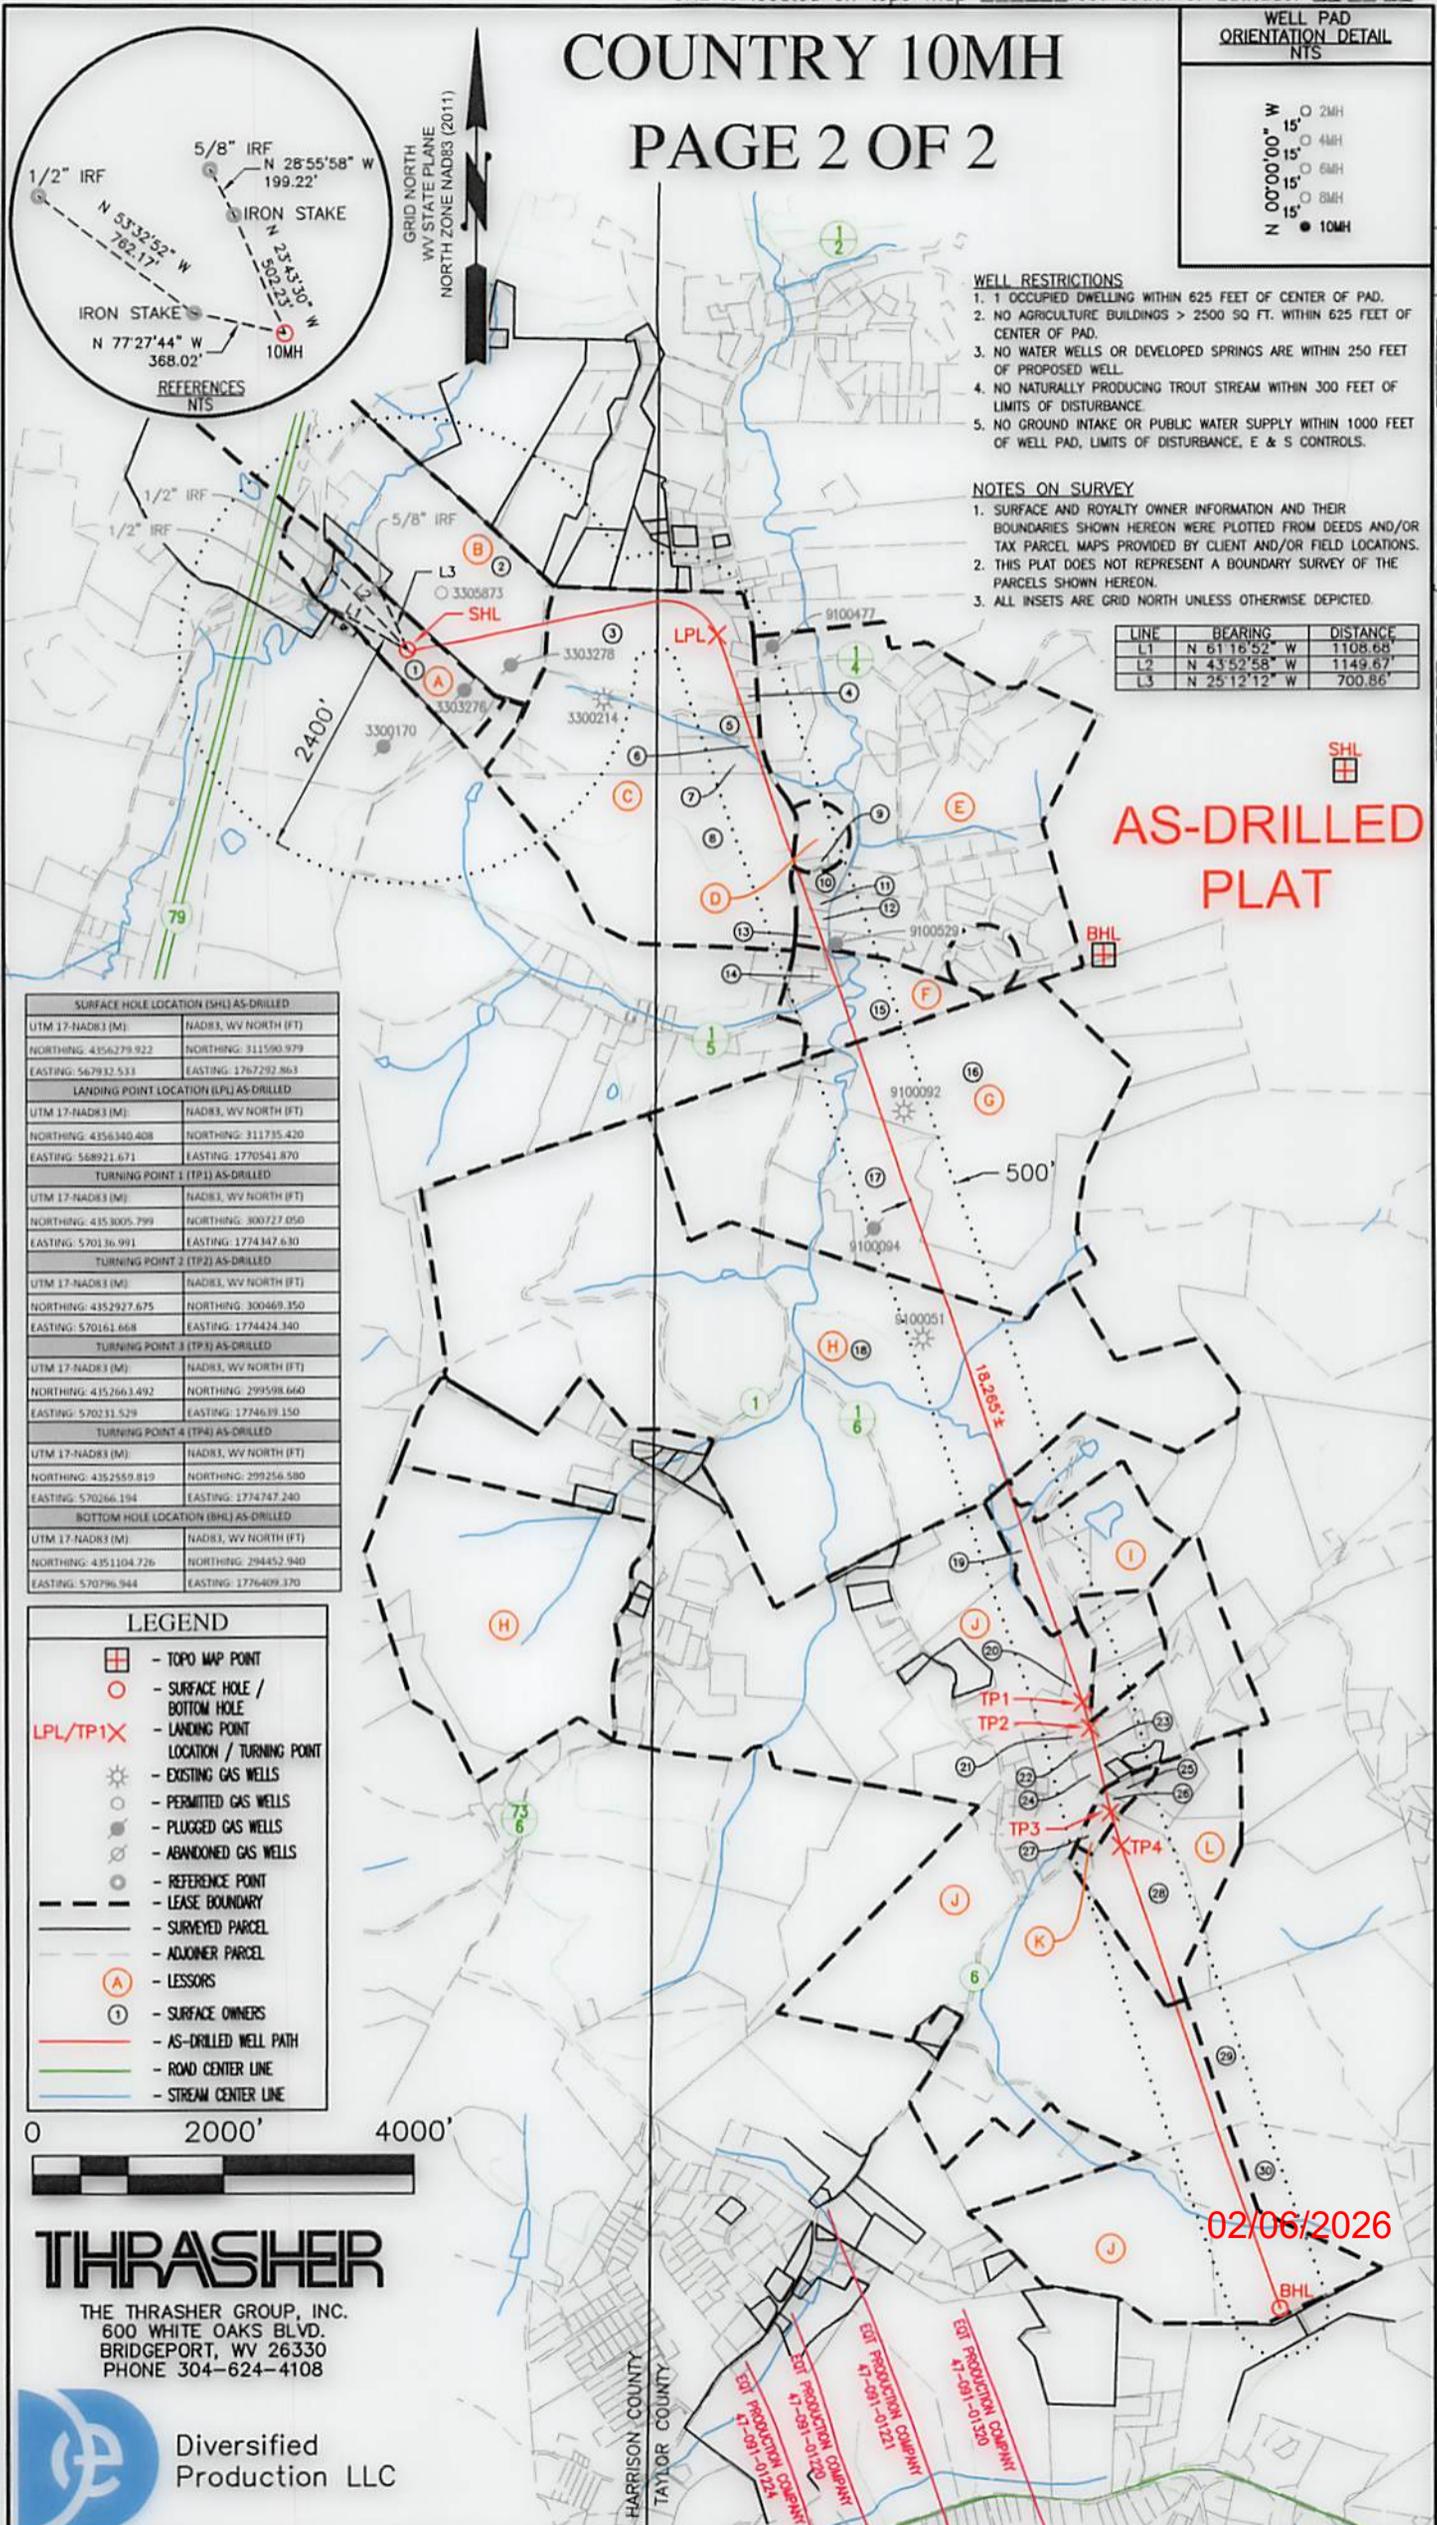

SURFACE HOLE LOCATION (SHL) AS-DRILLED	
UTM 17-NAD83 (M)	NAD83, WV NORTH (FT)
NORTHING: 4356279.922	NORTHING: 311590.979
EASTING: 56792.533	EASTING: 1767292.863
LANDING POINT LOCATION (LPL) AS-DRILLED	
UTM 17-NAD83 (M)	NAD83, WV NORTH (FT)
NORTHING: 4356340.408	NORTHING: 311735.420
EASTING: 568921.671	EASTING: 1770541.870
TURNING POINT 1 (TP1) AS-DRILLED	
UTM 17-NAD83 (M)	NAD83, WV NORTH (FT)
NORTHING: 4353005.799	NORTHING: 300727.050
EASTING: 570136.991	EASTING: 1774347.630
TURNING POINT 2 (TP2) AS-DRILLED	
UTM 17-NAD83 (M)	NAD83, WV NORTH (FT)
NORTHING: 4352927.675	NORTHING: 300469.350
EASTING: 570161.668	EASTING: 1774424.340
TURNING POINT 3 (TP3) AS-DRILLED	
UTM 17-NAD83 (M)	NAD83, WV NORTH (FT)
NORTHING: 4352663.492	NORTHING: 299598.660
EASTING: 570231.529	EASTING: 1774639.150
TURNING POINT 4 (TP4) AS-DRILLED	
UTM 17-NAD83 (M)	NAD83, WV NORTH (FT)
NORTHING: 4352559.819	NORTHING: 299256.580
EASTING: 570266.194	EASTING: 1774747.240
BOTTOM HOLE LOCATION (BHL) AS-DRILLED	
UTM 17-NAD83 (M)	NAD83, WV NORTH (FT)
NORTHING: 4351104.726	NORTHING: 294452.940
EASTING: 570796.944	EASTING: 1776409.370

LEGEND

- TOPO MAP POINT
- SURFACE HOLE / BOTTOM HOLE
- LANDING POINT
- LANDING POINT LOCATION / TURNING POINT
- EXISTING GAS WELLS
- PERMITTED GAS WELLS
- PLUGGED GAS WELLS
- ABANDONED GAS WELLS
- REFERENCE POINT
- LEASE BOUNDARY
- SURVEYED PARCEL
- ADJOINER PARCEL
- LESSORS
- SURFACE OWNERS
- AS-DRILLED WELL PATH
- ROAD CENTER LINE
- STREAM CENTER LINE

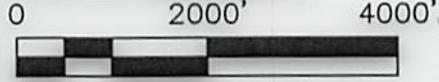

THRASHER
 THE THRASHER GROUP, INC.
 600 WHITE OAKS BLVD.
 BRIDGEPORT, WV 26330
 PHONE 304-624-4108



02/06/2026

BHL is located on topo map 3,450 feet west of Longitude: 80° 10' 00"
 SHL is located on topo map 911 feet west of Longitude: 80° 12' 30"