

COUNTRY SOUTH WELL 8MH - AS-DRILLED			
ID	LEASE NUMBER	LESSOR	LEASE ACREAGE
A	BP049602	A B WILLIS & ET AL	33.00
B	BP048589	J E CORE ET AL	140.00
C	BP044909	C C WILSON ET AL	209.00
D	BP035755	DELIA COLLINS ET AL	106.00
E	BP037527	A. C. MORRIS ET AL	32.00
F	BP024534	A. Y. MCELROY ET AL	252.00
G	BP024394	M O GOFF ET AL	620.00
H	BP002907	BELLE S PAYNE ET AL	800.00
I	DONNA S. FREDERICK ET AL	H/S/A OF SALLIE A. MURRAY	25.00

COUNTRY SOUTH WELL 8MH - AS-DRILLED		
ID	SURFACE OWNER	DIST-TM-PAR
1	JAMES D. MILLER ET AL	5-230-45
2	JANICE M. BRENNAN TRUST A	5-230-35
3	JB ANGUS RANCH LLC	3-13-11
4	JB ANGUS RANCH LLC	3-13-11.2
5	JB ANGUS RANCH LLC	3-13-10
6	JB ANGUS RANCH LLC	3-13-12.5
7	MICHAEL E. CONLEY	3-13-15.5
8	MICHAEL E. & ANN R. CONLEY	3-13-15.4
9	EVAN M. & WHITNEY HELMS KLIETHERMES	3-13-16.2
10	EVAN M. KLIETHERMES	3-13-16
11	LINDA O. MORGAN	3-14-16
12	JUSTIN H. STEVENS	3-14-2.24
13	FREDERICK C. FORSYTH III ET AL	3-14-2.8
14	LYNN W. & MARY JEANINE BURNSIDE	3-14-2.6
15	NICHOLAS A. BUNNELL	3-14-2.32
16	TAMMY J. SHAFFER	3-14-3.3
17	LESLEY E. BUNNELL ET AL	3-14-3.4
18	KATHLEEN H. BOETTCHER TRUST	3-14-3.1
19	KEITH & AMANDA ZEBLEY	3-14-6
20	KEITH & AMANDA ZEBLEY	3-14-5.1
21	CLAYTON W. VIVIAN C. LOUDERMILK	3-14-7.9
22	HUNTER W. REED ET AL	3-14-7.8
23	J. R. GARRETT II ET AL	3-14-5
24	JOSEPH R. GARRETT II ET AL	3-19-6
25	JOSEPH R. GARRETT II	3-19-5
26	JOSEPH R. GARRETT II ET AL	3-19-9

SEE PAGE 2 FOR PLAT DUE TO LENGTH OF LATERAL

THRASHER

THE THRASHER GROUP, INC.
600 WHITE OAKS BLVD.
BRIDGEPORT, WV 26330
PHONE 304-624-4108


AS-DRILLED PLAT



Diversified
Production LLC

FILE #: T70-11330 COUNTRY WELL PAD
DRAWING #: COUNTRY 8MH AS-DRILLED
SCALE: 1" = 2,000'
DATE: JUNE 17, 2025

I, THE UNDERSIGNED, HEREBY CERTIFY THAT THIS PLAT IS CORRECT TO THE BEST OF MY KNOWLEDGE AND BELIEF AND SHOWS ALL THE INFORMATION REQUIRED BY LAW AND THE REGULATIONS ISSUED AND PRESCRIBED BY THE DEPARTMENT OF ENVIRONMENTAL PROTECTION.

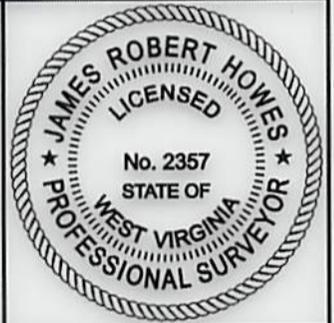

MINIMUM DEGREE OF ACCURACY: 1/2500
PROVEN SOURCE SURVEY GRADE GPS OF ELEVATION: (NAVD 88, US FT)

SIGNED: James R Howes
R.P.E.: _____ L.L.S.: P.S. No. 2357



(+) DENOTES LOCATION OF WELL ON UNITED STATES TOPOGRAPHIC MAPS
WVDEP
OFFICE OF OIL & GAS 601
57TH STREET
CHARLESTON, WV 25304

OPERATOR'S WELL #: COUNTRY 8MH AS-DRILLED

API WELL #: 47 33 06028
STATE COUNTY PERMIT

WELL TYPE: OIL WASTE DISPOSAL PRODUCTION DEEP GAS LIQUID INJECTION STORAGE SHALLOW
WATERSHED: THOMAS FORK TO BOOTH'S CREEK ELEVATION: 1,134.30'±
COUNTY/DISTRICT: HARRISON / CLAY-OUTSIDE QUADRANGLE: ROSEMONT, WV 7.5'
SURFACE OWNER: JAMES D. MILLER ET AL ACREAGE: 24.14±
OIL & GAS ROYALTY OWNER: A B WILLIS & ET AL ACREAGE: 33.00± **02/06/2026**
DRILL DRILL DEEPER REDRILL FRACTURE OR STIMULATE PLUG OFF OLD FORMATION
CONVERT PLUG & ABANDON CLEAN OUT & REPLUG PERFORATE NEW FORMATION
OTHER CHANGE (SPECIFY): _____
TARGET FORMATION: MARCELLUS ESTIMATED DEPTH: (LATERAL)TVD: 7,413'± TMD: 26,417'±


WELL OPERATOR: DIVERSIFIED PRODUCTION, LLC DESIGNATED AGENT: CHRIS VEASEY
ADDRESS: 101 MCQUISTON DRIVE ADDRESS: 400 SUMMER STREET
CITY: JACKSON CENTER STATE: PA ZIP CODE: 16133 CITY: CHARLESTON STATE: WV ZIP CODE: 25301

BHL is located on topo map 9,920 feet south of Latitude: 39° 20' 00"
 SHL is located on topo map 7,895 feet south of Latitude: 39° 22' 30"

COUNTRY 8MH

PAGE 2 OF 2

WELL PAD
 ORIENTATION
 DETAIL
 NTS

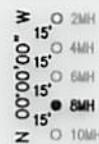


WELL RESTRICTIONS

1. 1 OCCUPIED DWELLING WITHIN 625 FEET OF CENTER OF PAD.
2. NO AGRICULTURE BUILDINGS > 2500 SQ FT. WITHIN 625 FEET OF CENTER OF PAD.
3. NO WATER WELLS OR DEVELOPED SPRINGS ARE WITHIN 250 FEET OF PROPOSED WELL.
4. NO NATURALLY PRODUCING TROUT STREAM WITHIN 300 FEET OF LIMITS OF DISTURBANCE.
5. NO GROUND INTAKE OR PUBLIC WATER SUPPLY WITHIN 1000 FEET OF WELL PAD, LIMITS OF DISTURBANCE, E & S CONTROLS.


NOTES ON SURVEY

1. SURFACE AND ROYALTY OWNER INFORMATION AND THEIR BOUNDARIES SHOWN HEREON WERE PLOTTED FROM DEEDS AND/OR TAX PARCEL MAPS PROVIDED BY CLIENT AND/OR FIELD LOCATIONS.
2. THIS PLAT DOES NOT REPRESENT A BOUNDARY SURVEY OF THE PARCELS SHOWN HEREON.
3. ALL INSETS ARE GRID NORTH UNLESS OTHERWISE DEPICTED.

LINE	BEARING	DISTANCE
L1	N 61°57'55" W	1101.56
L2	N 44°24'21" W	1138.91
L3	N 25°44'09" W	687.32

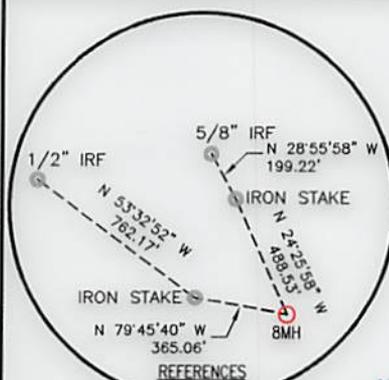

GRID NORTH
 WV STATE PLANE
 NORTH ZONE NAD83 (2011)

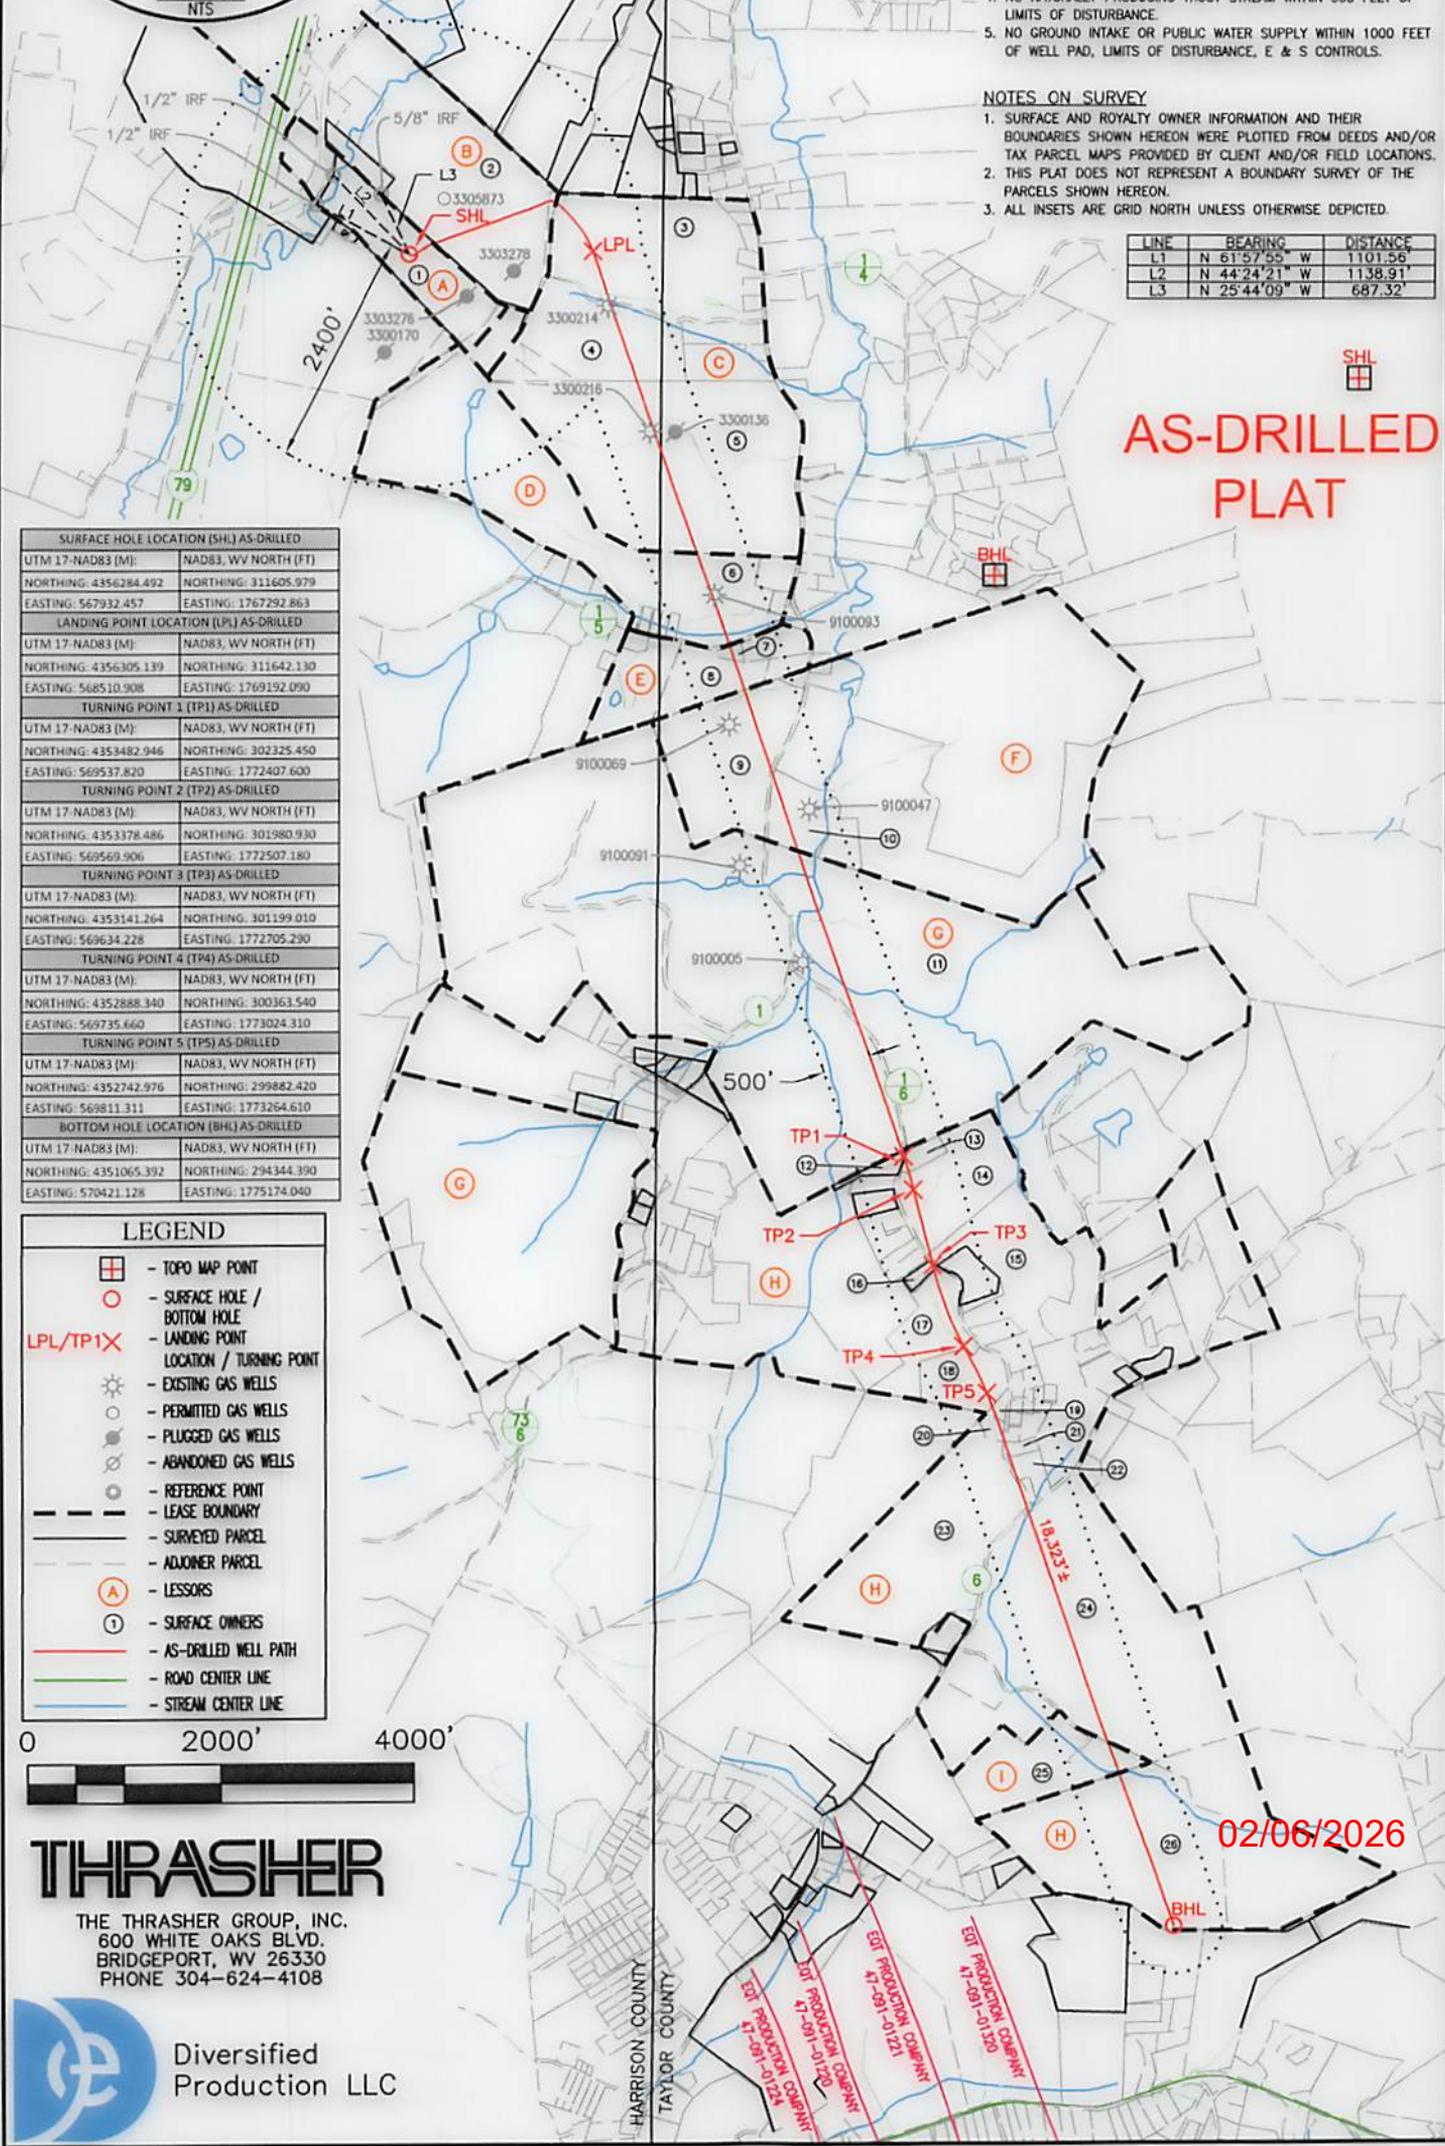

**AS-DRILLED
 PLAT**

SURFACE HOLE LOCATION (SHL) AS-DRILLED	
UTM 17-NAD83 (M):	NAD83, WV NORTH (FT)
NORTHING: 4356284.492	NORTHING: 311605.979
EASTING: 567932.457	EASTING: 1767292.863
LANDING POINT LOCATION (LPL) AS-DRILLED	
UTM 17-NAD83 (M):	NAD83, WV NORTH (FT)
NORTHING: 4356305.139	NORTHING: 311642.130
EASTING: 568510.908	EASTING: 1769192.090
TURNING POINT 1 (TP1) AS-DRILLED	
UTM 17-NAD83 (M):	NAD83, WV NORTH (FT)
NORTHING: 4353482.946	NORTHING: 302325.450
EASTING: 569537.820	EASTING: 1772407.600
TURNING POINT 2 (TP2) AS-DRILLED	
UTM 17-NAD83 (M):	NAD83, WV NORTH (FT)
NORTHING: 4353378.486	NORTHING: 301980.930
EASTING: 569569.906	EASTING: 1772507.180
TURNING POINT 3 (TP3) AS-DRILLED	
UTM 17-NAD83 (M):	NAD83, WV NORTH (FT)
NORTHING: 4353141.264	NORTHING: 301199.010
EASTING: 569634.228	EASTING: 1772705.290
TURNING POINT 4 (TP4) AS-DRILLED	
UTM 17-NAD83 (M):	NAD83, WV NORTH (FT)
NORTHING: 4352888.340	NORTHING: 300363.540
EASTING: 569735.660	EASTING: 1773024.310
TURNING POINT 5 (TP5) AS-DRILLED	
UTM 17-NAD83 (M):	NAD83, WV NORTH (FT)
NORTHING: 4352742.976	NORTHING: 299882.420
EASTING: 569811.311	EASTING: 1773264.610
BOTTOM HOLE LOCATION (BHL) AS-DRILLED	
UTM 17-NAD83 (M):	NAD83, WV NORTH (FT)
NORTHING: 4351065.392	NORTHING: 294344.390
EASTING: 570421.128	EASTING: 1775174.040

LEGEND	
	- TOPO MAP POINT
	- SURFACE HOLE / BOTTOM HOLE
	- LANDING POINT
	- TURNING POINT
	- EXISTING GAS WELLS
	- PERMITTED GAS WELLS
	- PLUGGED GAS WELLS
	- ABANDONED GAS WELLS
	- REFERENCE POINT
	- LEASE BOUNDARY
	- SURVEYED PARCEL
	- ADJOINER PARCEL
	- LESSORS
	- SURFACE OWNERS
	- AS-DRILLED WELL PATH
	- ROAD CENTER LINE
	- STREAM CENTER LINE



THRASHER
 THE THRASHER GROUP, INC.
 600 WHITE OAKS BLVD.
 BRIDGEPORT, WV 26330
 PHONE 304-624-4108



Diversified
 Production LLC

02/06/2026

BHL is located on topo map 4,684 feet west of Longitude: 80° 10' 00"
 SHL is located on topo map 911 feet west of Longitude: 80° 12' 30"