

T.H. LATITUDE 39°17'30"  
B.H. LATITUDE 39°12'30"

**D'ANNUNZIO PAD  
WELL NO. 202  
ARSENAL RESOURCES**

CURVE	RADIUS	ARC LENGTH	CHORD LENGTH	CHORD BEARING
C1	22.64'	20.92'	20.18'	S 33°12' W
C2	227.74'	67.84'	67.59'	S 00°19' W
C3	1356.73'	188.21'	188.06'	S 10°36' E
C4	4970.67'	454.60'	454.44'	S 16°37' E

T.H. LONGITUDE 80°20'00"  
B.H. LONGITUDE 80°17'30"

TAG	PARCEL	SURFACE OWNER/ROAD/RIVER	ACREAGE
A	3-327-17	A & B MANAGEMENT LLC	199.03
B	1-347-8	ROGER & BETTY PHILLIPS	93.36
C	1-347-10	ROBEY SCOTT ROBEY & R MICHAEL ROBEY	52.1
ROAD	N/A	COUNTY ROUTE 20/9	N/A
D	1-347-34	MARY SUSAN NUTTER	53.15
E	1-347-33	KURT G SKASIK & ANDREW SKASIK	93.35
F	1-347-35	W VA DIVISION OF NATURAL RESOURCES	378.32
G	1-347-89	W VA DIVISION OF NATURAL RESOURCES	62.24
H	1-367-37	W VA DIVISION OF NATURAL RESOURCES	160
I	1-367-25	W VA DIVISION OF NATURAL RESOURCES	16.76
J	1-367-90	WILSON THELMA THOMPSON TRUST	0.61
K	1-367-47	FRANK FERNANDEZ (LE)	177.9
L	11-367-58	JARVIS FAMILY LLC	50.74
M	11-367-59.5	PAUL L & RHONDA J CURREY	28.71

RECEIVED  
Office of Oil and Gas  
SEP 19 2025  
Department of Environmental Protection


**LEGEND**

LEASE LINE	-----
SURFACE LINE	-----
WELL LATERAL	-----
500' OFFSET LINE	-----
TIE LINE	-----
CREEK	-----
ROAD	-----
COUNTY ROUTE	-----
PROPOSED WELL	⊙
EXISTING WELL	⊙
PERMITTED WELL	⊙
TAX MAP-PARCEL	00-00
SURFACE OWNER (SEE TABLE)	(A)
LEASE # (SEE WW-6A1)	(A)

**(S.P.C. NORTH ZONE) (UTM(M) ZONE 17)**

NAD'83 S.P.C.(FT)	N. 276,168.07	E. 1,731,845.55
NAD'83 GEO.	LAT-(N) 39.255202	LONG-(W) 80.336445
NAD'83 UTM (M)	N. 4,345,307.06	E. 557,251.69
<b>LANDING POINT</b>		
NAD'83 S.P.C.(FT)	N. 275,320.2	E. 1,731,348.8
NAD'83 GEO.	LAT-(N) 39.252867	LONG-(W) 80.337485
NAD'83 UTM (M)	N. 4,345,047.2	E. 557,165.6
<b>BOTTOM HOLE</b>		
NAD'83 S.P.C.(FT)	N. 261,898.6	E. 1,735,980.7
NAD'83 GEO.	LAT-(N) 39.216136	LONG-(W) 80.320676
NAD'83 UTM (M)	N. 4,340,981.7	E. 558,644.8

**REFERENCES**

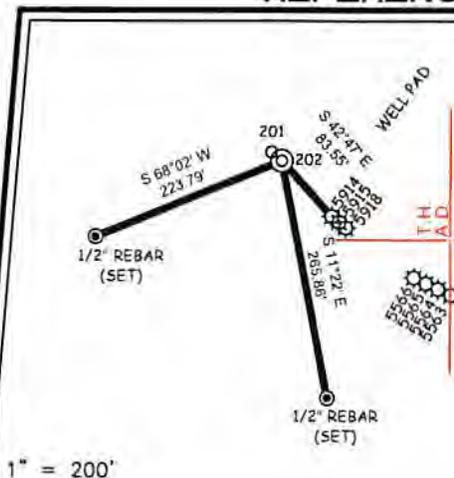

**NOTES ON SURVEY**


- NO WATER WELLS WERE FOUND WITHIN 250' OF PROPOSED GAS WELL. NO AGRICULTURAL BUILDINGS > 2500 SQ. FT. OR DWELLINGS WERE FOUND WITHIN 625' OF THE CENTER OF PROPOSED WELL PAD.
- WELL SPOT CIRCLE & TOPD MARK SCALE ARE 1"=2000'
- PLAT UPDATED TO SHOW AS-DRILLED PATH.
- AS-DRILLED DATA PROVIDED BY ARSENAL RESOURCES.



12 Vardon Drive | P.O. Box 150 | Seneca, WV 26281 | 504-457-6634  
1413 Rimaker Boulevard | Charleston, WV 25301 | 504-546-1892  
234 East Shockley Avenue | Bridgeport, WV 26301 | 504-255-2334  
www.sls.com

I THE UNDERSIGNED, HEREBY CERTIFY THAT THIS PLAT IS CORRECT TO THE BEST OF MY KNOWLEDGE AND BELIEF AND SHOWS ALL THE INFORMATION REQUIRED BY LAW AND THE REGULATIONS ISSUED AND PRESCRIBED BY THE DIVISION OF ENVIRONMENTAL PROTECTION.

P.S. 677 *Gregory A. Smith*

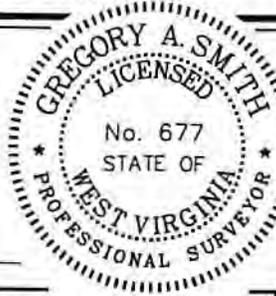

(+) DENOTES LOCATION OF WELL ON UNITED STATES TOPOGRAPHIC MAPS

DATE JANUARY 8, 20 25  
REVISED MAY 20, 20 25  
OPERATORS WELL NO. 202

API WELL NO. 47-033-06045  
STATE COUNTY PERMIT

MINIMUM DEGREE OF ACCURACY 1 / 2500 FILE NO. 9483P202 AD.dwg

HORIZONTAL & VERTICAL CONTROL DETERMINED BY: DGPS (SURVEY GRADE TIE TO CORS NETWORK) SCALE 1" = 2000'

STATE OF WEST VIRGINIA  
DIVISION OF ENVIRONMENTAL PROTECTION  
OFFICE OF OIL AND GAS



WELL TYPE: OIL    GAS X LIQUID INJECTION    WASTE DISPOSAL    IF "GAS" PRODUCTION X STORAGE    DEEP    SHALLOW X

LOCATION: ELEVATION 1118.00' WATERSHED TRIBUTARY TO NUTTER RUN

DISTRICT CLARK-CLARKSBURG CORP. COUNTY HARRISON QUADRANGLE CLARKSBURG

SURFACE OWNER A & B MANAGEMENT LLC ACREAGE 199.03±

ROYALTY OWNER A & B MANAGEMENT LLC ET AL ACREAGE 199.03±

PROPOSED WORK: DRILL X CONVERT    DRILL DEEPER    REDRILL    FRACTURE OR STIMULATE X PLUG OFF OLD FORMATION    PERFORATE NEW FORMATION    PLUG AND ABANDON    CLEAN OUT AND REPLUG    OTHER   

PHYSICAL CHANGE IN WELL (SPECIFY)    TARGET FORMATION MARCELLUS

ESTIMATED DEPTH TMD 21,890.21' / TVD 7,250'

WELL OPERATOR ARSENAL RESOURCES

DESIGNATED AGENT ERIC MORRIS


ADDRESS 6031 WALLACE RD. EXT. SUITE 200  
WEXFORD, PA 15090

ADDRESS 633 WEST MAIN STREET  
BRIDGEPORT, WV 26330

COUNTY NAME PERMIT

02/06/2026

**D'ANNUNZIO PAD  
WELL NO. 202  
ARSENAL RESOURCES**

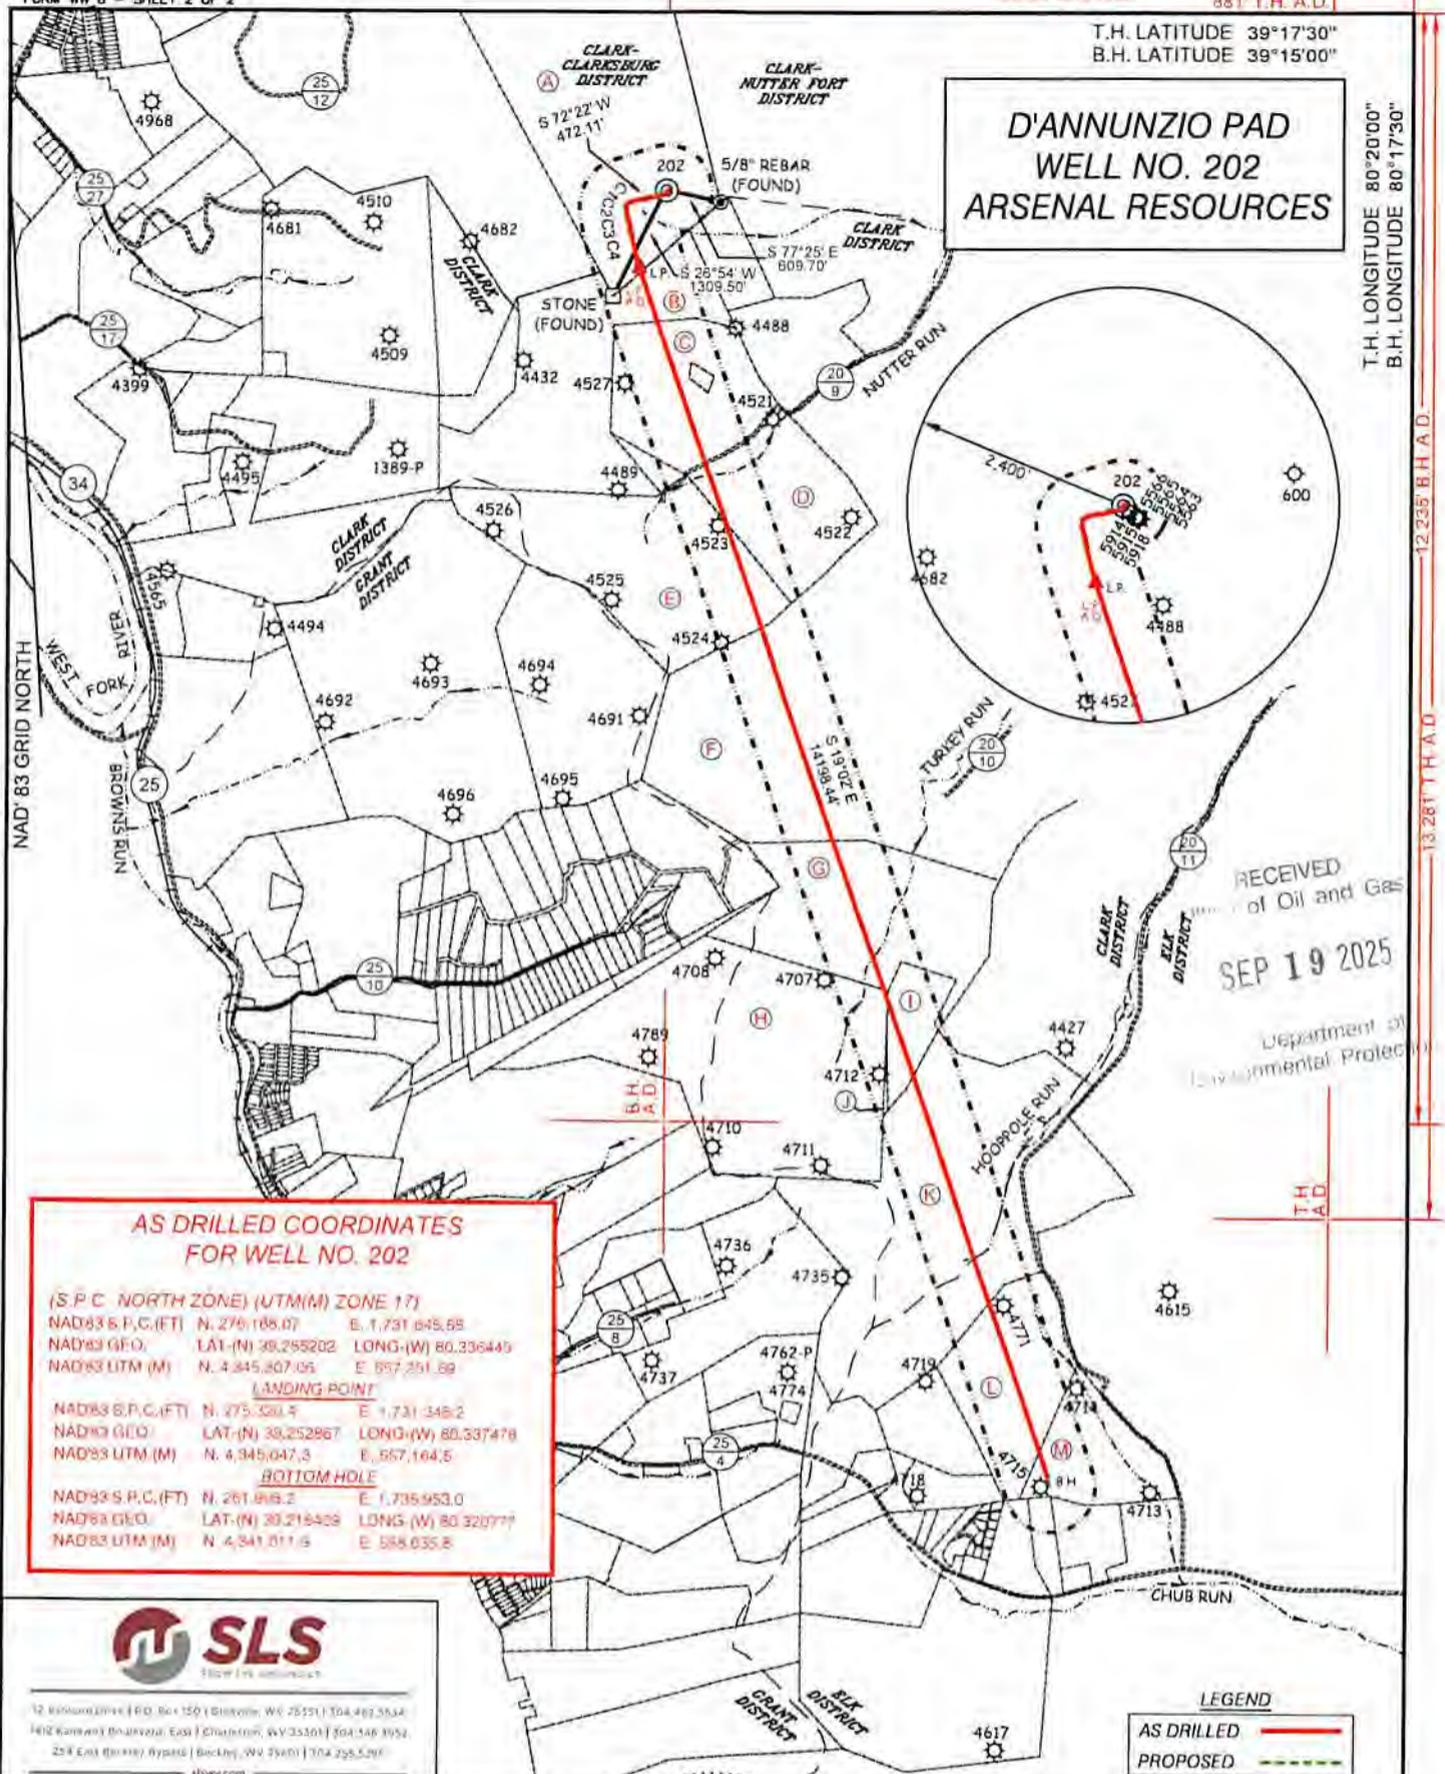

RECEIVED  
of Oil and Gas  
**SEP 19 2025**  
Department of  
Environmental Protection

**AS DRILLED COORDINATES  
FOR WELL NO. 202**

(S.P.C. NORTH ZONE) (UTMM) ZONE 17)

NAD83 S.P.C.(FT) N. 276,108.07 E. 1,731,845.55  
NAD83 GEO. LAT.(N) 39.255202 LONG.(W) 80.336445  
NAD83 UTM (M) N. 4,345,307.05 E. 557,251.89

**LANDING POINT**

NAD83 S.P.C.(FT) N. 275,320.2 E. 1,731,348.2  
NAD83 GEO. LAT.(N) 39.252867 LONG.(W) 80.337478  
NAD83 UTM (M) N. 4,345,047.3 E. 557,164.5

**BOTTOM HOLE**

NAD83 S.P.C.(FT) N. 261,898.2 E. 1,735,953.0  
NAD83 GEO. LAT.(N) 39.216136 LONG.(W) 80.320777  
NAD83 UTM (M) N. 4,341,811.5 E. 558,635.2

**SLS**  
SURVEYING & CONSULTING

12 Wilson Drive | P.O. Box 150 | Glenview, WV 25511 | 304.462.5534  
4612 Kanawha Boulevard East | Charleston, WV 25301 | 804.346.3954  
254 East Brooke Avenue | Beckley, WV 25801 | 304.255.2267  
slsurvey.com

(S.P.C. NORTH ZONE) (UTM(M) ZONE 17)

NAD83 S.P.C.(FT) N. 276,168.07 E. 1,731,845.55  
NAD83 GEO. LAT.(N) 39.255202 LONG.(W) 80.336445  
NAD83 UTM (M) N. 4,345,307.06 E. 557,251.69

**LANDING POINT**

NAD83 S.P.C.(FT) N. 275,320.2 E. 1,731,348.8  
NAD83 GEO. LAT.(N) 39.252867 LONG.(W) 80.337465  
NAD83 UTM (M) N. 4,345,047.2 E. 557,165.6

**BOTTOM HOLE**

NAD83 S.P.C.(FT) N. 261,898.6 E. 1,735,980.7  
NAD83 GEO. LAT.(N) 39.216136 LONG.(W) 80.320676  
NAD83 UTM (M) N. 4,340,981.7 E. 558,644.8



(+) DENOTES LOCATION OF WELL ON UNITED STATES TOPOGRAPHIC MAPS

P.S. 677 *Gregory A. Smith*

SCALE 1" = 2000' FILE NO. 9483P202 AD.dwg

DATE JANUARY 8 20 25  
REVISED MAY 20 20 25

OPERATORS WELL NO. 202  
API WELL NO. 47 - 033 - 06045  
STATE COUNTY PERMIT

STATE OF WEST VIRGINIA  
DIVISION OF  
ENVIRONMENTAL PROTECTION  
OFFICE OF OIL AND GAS

**LEGEND**

- LEASE LINE
- SURFACE LINE
- WELL LATERAL
- OFFSET LINE
- TIE LINE
- CREEK
- ROAD
- COUNTY ROUTE
- PROPOSED WELL
- EXISTING WELL
- PERMITTED WELL
- TAX MAP-PARCEL
- SURFACE OWNER (SEE TABLE)
- LEASE # (SEE WW-6A1)

02/06/2026  
*Gregory A. Smith*  
00-00  
A

WELL OPERATOR ARSENAL RESOURCES DESIGNATED AGENT ERIC MORRIS  
ADDRESS 6031 WALLACE RD. EXT. SUITE 200 WEXFORD, PA 15090 ADDRESS 633 WEST MAIN STREET BRIDGEPORT, WV 26330

COUNTY NAME PERMIT

T.H. LATITUDE 39°17'30"  
B.H. LATITUDE 39°12'30"

**D'ANNUNZIO PAD  
WELL NO. 202  
ARSENAL RESOURCES**

CURVE	RADIUS	ARC LENGTH	CHORD LENGTH	CHORD BEARING
C1	22.64'	20.92'	20.18'	S 33°12' W
C2	227.74'	67.84'	67.59'	S 00°19' W
C3	1356.73'	188.21'	188.06'	S 10°36' E
C4	4970.67'	454.60'	454.44'	S 16°37' E

T.H. LONGITUDE 80°20'00"  
B.H. LONGITUDE 80°17'30"

TAG	PARCEL	SURFACE OWNER/ROAD/RIVER	ACREAGE
A	3-327-17	A & B MANAGEMENT LLC	199.03
B	1-347-8	ROGER & BETTY PHILLIPS	93.36
C	1-347-10	ROBEY SCOTT ROBEY & R MICHAEL ROBEY	52.1
ROAD	N/A	COUNTY ROUTE 20/9	N/A
D	1-347-34	MARY SUSAN NUTTER	53.15
E	1-347-33	KURT G SKASIK & ANDREW SKASIK	93.35
F	1-347-35	W VA DIVISION OF NATURAL RESOURCES	378.32
G	1-347-89	W VA DIVISION OF NATURAL RESOURCES	62.24
H	1-367-37	W VA DIVISION OF NATURAL RESOURCES	160
I	1-367-25	W VA DIVISION OF NATURAL RESOURCES	16.76
J	1-367-90	WILSON THELMA THOMPSON TRUST	0.61
K	1-367-47	FRANK FERNANDEZ (LE)	177.9
L	11-367-58	JARVIS FAMILY LLC	50.74
M	11-367-59.5	PAUL L & RHONDA J CURREY	28.71

**LEGEND**

- LEASE LINE
- SURFACE LINE
- WELL LATERAL
- 500' OFFSET LINE
- TIE LINE
- CREEK
- ROAD
- COUNTY ROUTE
- PROPOSED WELL
- EXISTING WELL
- PERMITTED WELL
- TAX MAP-PARCEL 00-00
- SURFACE OWNER (SEE TABLE) A
- LEASE # (SEE WW-6A1)

(S.P.C. NORTH ZONE) (UTM(M) ZONE 17)

COORDINATE SYSTEM	NORTHING	EASTING
NAD'83 S.P.C.(FT)	N. 276,168.07	E. 1,731,645.55
NAD'83 GEO.	LAT-(N) 39.255202	LONG-(W) 80.336445
NAD'83 UTM (M)	N. 4,345,307.06	E. 557,251.69


**LANDING POINT**

COORDINATE SYSTEM	NORTHING	EASTING
NAD'83 S.P.C.(FT)	N. 275,320.2	E. 1,731,348.8
NAD'83 GEO.	LAT-(N) 39.252867	LONG-(W) 80.337465
NAD'83 UTM (M)	N. 4,345,047.2	E. 557,165.6

**BOTTOM HOLE**

COORDINATE SYSTEM	NORTHING	EASTING
NAD'83 S.P.C.(FT)	N. 261,898.6	E. 1,735,980.7
NAD'83 GEO.	LAT-(N) 39.216136	LONG-(W) 80.320676
NAD'83 UTM (M)	N. 4,340,981.7	E. 558,644.8

**REFERENCES**

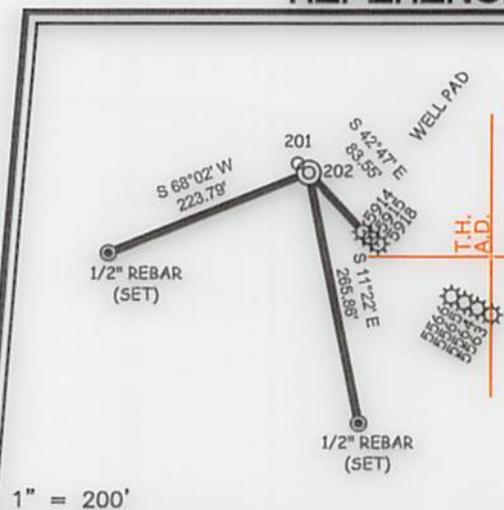

**NOTES ON SURVEY**

- NO WATER WELLS WERE FOUND WITHIN 250' OF PROPOSED GAS WELL. NO AGRICULTURAL BUILDINGS > 2500 SQ. FT. OR DWELLINGS WERE FOUND WITHIN 625' OF THE CENTER OF PROPOSED WELL PAD.
- WELL SPOT CIRCLE & TOPO MARK SCALE ARE 1"=2000'.
- PLAT UPDATED TO SHOW AS-DRILLED PATH.
- AS-DRILLED DATA PROVIDED BY ARSENAL RESOURCES.



12 Vanhorn Drive | P.O. Box 150 | Glenville, WV 26351 | 304.462.5634  
1412 Kanawha Boulevard, East | Charleston, WV 25301 | 304.346.3952  
254 East Beckley Bypass | Beckley, WV 25801 | 304.255.5296  
slsvv.com

I THE UNDERSIGNED, HEREBY CERTIFY THAT THIS PLAT IS CORRECT TO THE BEST OF MY KNOWLEDGE AND BELIEF AND SHOWS ALL THE INFORMATION REQUIRED BY LAW AND THE REGULATIONS ISSUED AND PRESCRIBED BY THE DIVISION OF ENVIRONMENTAL PROTECTION.



P.S. 677 *Gregory A. Smith*

(+) DENOTES LOCATION OF WELL ON UNITED STATES TOPOGRAPHIC MAPS  
DATE JANUARY 8, 2025  
REVISED AUGUST 26, 2025  
OPERATORS WELL NO. 202  
API WELL NO. 47-033-06045  
STATE COUNTY PERMIT

MINIMUM DEGREE OF ACCURACY 1 / 2500 FILE NO. 9483P202 AD R1.dwg  
HORIZONTAL & VERTICAL CONTROL DETERMINED BY: DGPS (SURVEY GRADE TIE TO CORS NETWORK) SCALE 1" = 2000'

STATE OF WEST VIRGINIA  
DIVISION OF ENVIRONMENTAL PROTECTION  
OFFICE OF OIL AND GAS

WELL TYPE: OIL  GAS  LIQUID INJECTION  WASTE DISPOSAL  IF "GAS" PRODUCTION  STORAGE  DEEP  SHALLOW

LOCATION: ELEVATION 1118.00' WATERSHED TRIBUTARY TO NUTTER RUN  
DISTRICT CLARK-CLARKSBURG CORP. COUNTY HARRISON QUADRANGLE CLARKSBURG  
SURFACE OWNER A & B MANAGEMENT LLC ACREAGE 199.03±  
ROYALTY OWNER A & B MANAGEMENT LLC ET AL ACREAGE 02/06/2026  
PROPOSED WORK: DRILL  CONVERT  DRILL DEEPER  REDRILL  FRACTURE OR STIMULATE  PLUG OFF OLD FORMATION  PERFORATE NEW FORMATION  PLUG AND ABANDON  CLEAN OUT AND REPLUG  OTHER   
PHYSICAL CHANGE IN WELL (SPECIFY) \_\_\_\_\_ TARGET FORMATION MARCELLUS  
ESTIMATED DEPTH TMD 21,803' / TVD 7,336'

WELL OPERATOR ARSENAL RESOURCES DESIGNATED AGENT ERIC MORRIS.  
ADDRESS 6031 WALLACE RD. EXT. SUITE 200 WEXFORD, PA 15090 ADDRESS 633 WEST MAIN STREET BRIDGEPORT, WV 26330

COUNTY NAME PERMIT

