

Coal District, Harrison County, W. Va.

238-A

By Hope Cons. & Ref. Co., 445 W. Main St., Clarksburg, W. Va.

On.....acres, surface owned by Boyd Warner, Clarksburg, W. Va.,
and mineral rights by Consolidation Coal Co., Fairmont, W. Va.

No elevation given. *Elevation 1192 from plat on microfilm.*

10" casing, 241'; 8 $\frac{1}{4}$ " 1186'; 6-5/8" 1704'; 6-5/16" 2248';
2" tubing, 2732'; 4" liner, 209'.

Coal was encountered at 169-180'.

Abandonment reported to Dept. of Mines June 16, 1932.

Well was shot at 2650-2662' and 2672-2688'.

Salt water at 1025'.

Producing hole; now exhausted to extent that it is not commercially
productive.

	Top.	Bottom.	Thickness.
Pittsburgh Coal	169	180	11
Little Dunkard Sand	610	650	40
Big Dunkard Sand	725	778	53
First Salt Sand (water, 1025')	1022	1225	203
Big Lime	1640	1702	62
Big Injun Sand	1702	1785	83
Thirty-foot Sand	2227	2288	61
Gordon Stray Sand	2290	2317	27
Gordon Sand	2332	2362	30
Fourth Sand	2500	2517	17
Fifth Sand (oil, 2680'; gas, 2650-55')	2648	2692	44
Total depth		2832	


WELLS No C-239-C-238-240

HOPE CONSTRUCTION & REFINING CO.

H.F. COFFMAN 332 & A.G. GOLDEN 328
COAL

D. COFFMAN 328
DISTRICT HARRISON

of the
Clarksburg, W. Va., on the
Farm consisting of _____ Acres
County, W. Va.

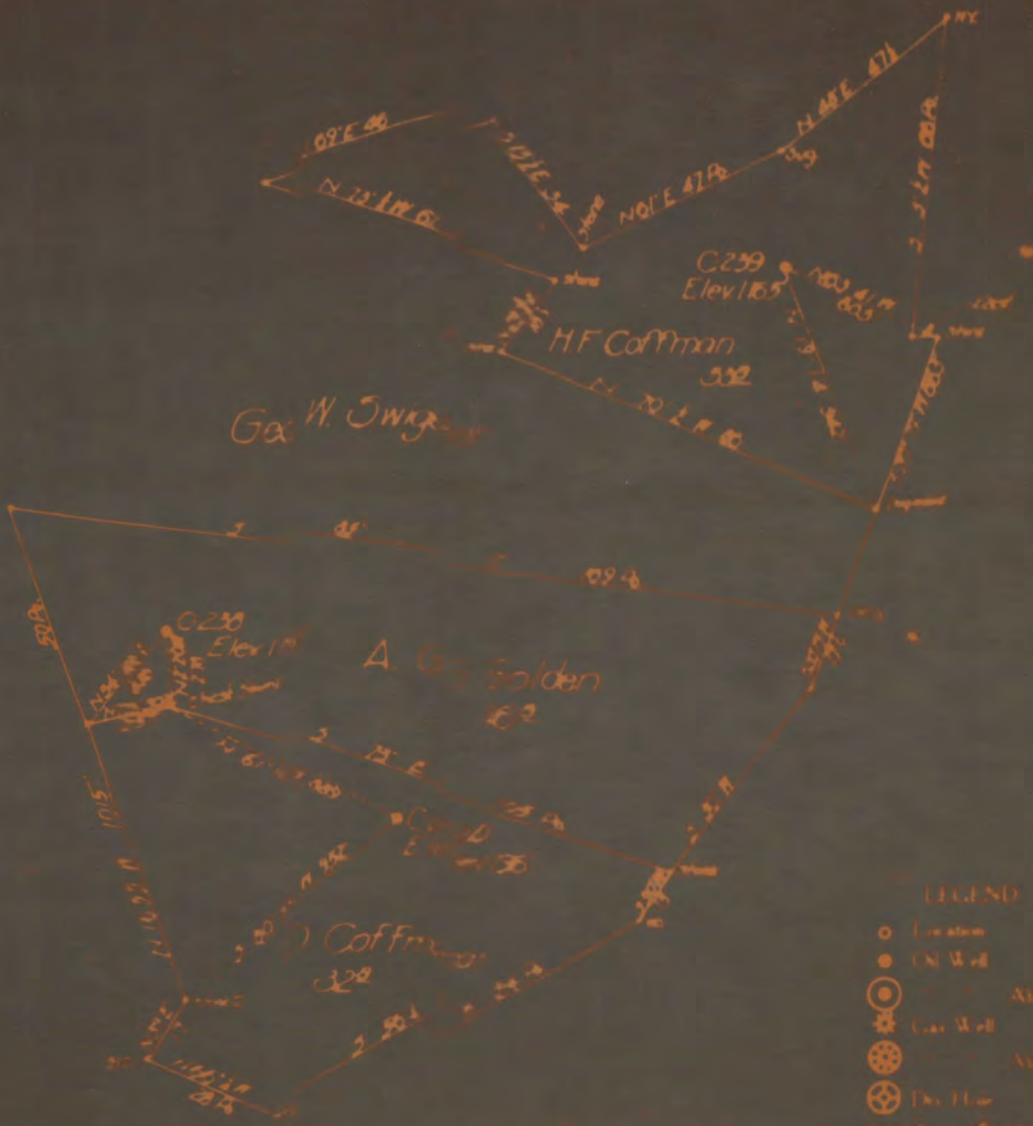

LEGEND

- Location
- Oil Well
- ⊙ Gas Well
- ⊗ Dry Hole

Field Book No 522256

Scale 16,000'

June 14, 1926

4AR-238-A

ENGINEERS CERTIFICATE

I certify that this map is correct and shows all the information to the best of my knowledge.