

271-A

Sardis District, Harrison County, W. Va.

Israel H. Beren, Marietta, Ohio.

On 75 acres, surface owned by G. L. Davisson, Wallace, W. Va.,  
and mineral rights by Harrison-Doddridge Coal Co., Pitts-  
burgh, Pa.

Oil and gas under lease to Philadelphia Oil Co.

Well completed Nov. 5, 1925.

Elevation, 1105'.

13" conductor, 14'; 10" casing, 374'; 8 $\frac{1}{4}$ ", 1185'; 6- $\frac{5}{8}$ ", 2021';  
5-3/16", 2797'; 2" tubing, 2834'.

Coal was encountered at 465-470, 720-723, and 745-749'.

Abandonment reported to Dept. of Mines Sept. 6, 1935.

	Top.	Bottom.
Clay	0	16
Shells	16	25
Slate	25	125
Shells	125	200
Slate	200	315
Sand	315	350
Slate	350	465
Coal	465	470
Lime and slate	470	720
Coal	720	725
Pittsburgh Coal	725	749
Lime and slate	749	856
Shells	856	905
Red rock	905	910
Sand	910	940
Slate and lime	940	1010
Shells	1010	1050
Red rock	1050	1080
Lime and slate	1080	1170
Sand, Little Dunkard	1170	1190
Lime and slate	1190	1310
Big Dunkard Sand	1310	1325
Slate and shells	1325	1400
Sand	1400	1410
Slate	1410	1450
Sand	1450	1500
1st Salt Sand	1500	1575
Slate	1575	1635
2nd Salt Sand	1635	1725
Slate and shells	1725	1815
Maxton Sand	1815	1915
Slate and lime	1915	1990
Big Lime	1990	2037
Big Injun Sand	2037	2130
Shells and slate	2130	2598
50-Ft. Sand (gas, 2610-2615')	2598	2628
Slate and shells	2628	2709
Nineveh 30-Ft. Sand	2709	2724
Slate	2724	2735
Sand	2735	2745
Slate	2745	2751
Sand	2751	2762
Red rock	2762	2766
Gordon Stray Sand	2766	2798


(OVER)

G. L. DAVISSON NO. 4902 WELL (Continued).

	Top.	Bottom.
Slate	2798	- 2810
Gordon Sand	2810	- 2830
Slate	2830	- 2833
4th Sand	2833	- 2844
Slate	2844	- 3111

(Not sure this is the bottom since last line above  
was at bottom of carbon with figures cut in half).

RCT

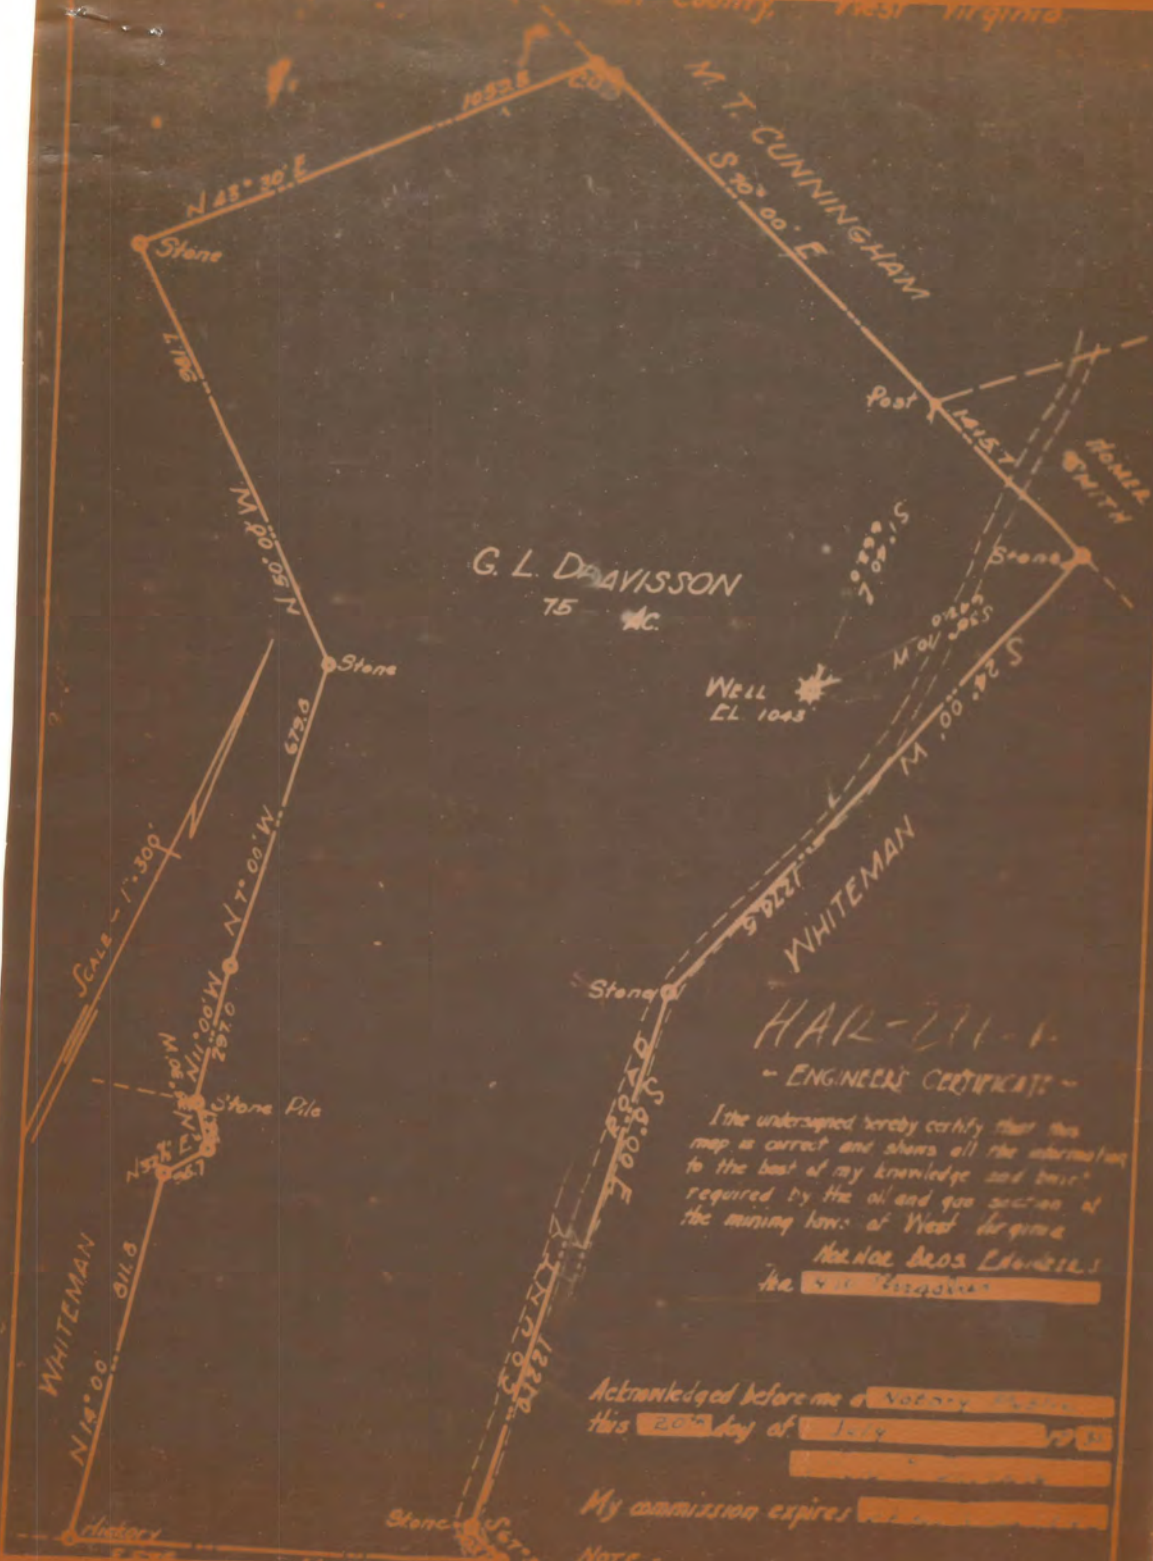

G. L. DRAVISSON  
75 AC.

Well  
EL. 1043

SCALE - 1" = 300'

HAR-271-1  
- ENGINEER'S CERTIFICATE -

I the undersigned hereby certify that this map is correct and shows all the information to the best of my knowledge and belief required by the oil and gas section of the mining laws of West Virginia.

W. H. DAVIS  
The Surveyor

Acknowledged before me a Notary Public  
this 20th day of July 1934

My commission expires

NOTE -