

Coal: Formerly Owned by David Blair Jr.  
Was sold to State for Taxes  
Title now in State of W. Va.

1.625      1.6 S  
2.43W      2.5 W

Well to be abandoned

Company	South Penn Oil Co.	0772
Address	411 Seventh Ave., Pittsburgh, Pa.	
Farm	Loverna Williams	
Tract	Acres 60'	Lease No. 31215
Well ( Farm) No.	1	Serial No.
Quadrangle	Clarksburg	SW.
County	Harrison	
District	Ten Mile	
Engineer	E.C. Tabler	
Engineer 's Registration No.		
File No.	Drawing No.	
Date	May 4, 1938	Scale 1"-400'

STATE OF WEST VIRGINIA  
Department of Mines  
OIL AND GAS DIVISION  
CHARLESTON

WELL LOCATION MAP

File No. Har-432-A

Denotes location of well on United States Topographic Maps, scale 1 to 62,500, latitude and longitude lines being represented by border lines as shown.

Denotes one inch spaces on border line of original tracing.

## LOVERNA WILLIAMS NO. 1 WELL.

No. 349 O.F.-Harrison.

Ten Mile District, Harrison County, W. Va.

By South Penn Oil Co., 411 Seventh Ave., Pittsburgh, Pa.

On 60 acres, on New Creek.

Elevation, 1197.75' L.

Surface owned by Ellis Williams, R. D. No. 1, Bristol, W. Va.,

and minerals by Zeppa William ~~stm~~ al., R. D. No. 1, Bristol, W. Va.

Drilling commenced March 13, 1900; completed, April 24, 1900.

Shot Nov. 1900, with 40 qts.; Jan. 17, 1902, with 40 qts.; and

Feb. 1, 1902, with 40 qts.

Oil, 120 bbls., 1st 24 hrs.

10" casing, 185'; 8 $\frac{1}{2}$ " , 910'; 6 $\frac{3}{4}$ " , 1775'; 5 $\frac{1}{2}$ " , 1797'.

Coal was encountered at 375-379'.

Oil well. Abandonment reported to Dept. of Mines May 9, 1938.

Record to RCT from Mrs. Griffith May 27, 1938.

	Top.	Bottom.
Pittsburgh Coal	375	- 379
Big Dunkard Sand	910	- 1100
Big Lime	1725	- 1760
Big Injun Sand	1775	- 1870
Fifty-foot Sand	2300	- 2360
Gordon Sand	2480	- 2548
Fifth Sand	2737	- 2745
Total depth		2757

WEST VIRGINIA DEPARTMENT OF MINES  
OIL AND GAS DIVISION

349

WELL RECORD

Permit No. HAR-432-A


Oil or Gas Well.....  
(Kind)

Company SOUTH PENN OIL COMPANY  
 Address 411 Seventh Ave., Pittsburgh, Pa.  
 Farm Loverna Williams Acres 60  
 Location (waters) New Creek  
 Well No. 1 Elev. 1197.75'  
 District Ten Mile County Harrison  
 The surface of tract is owned in fee by Ellis Williams  
R. D. No. 1, Address Bristol, W.Va.  
 Mineral rights are owned by Zeppa Williams et al  
R. D. No. 1, Address Bristol, W.Va.  
 Drilling commenced March 13, 1900  
 Drilling completed April 24, 1900  
 Date shot Nov. 17-02 40 qt. Depth of shot -  
Feb. 1-02 40 qt.  
 Open Flow 7 10ths Water in - Inch  
- /10ths Merc. in - Inch  
 Volume - Cu. Ft.  
 Rock Pressure - lbs. - hrs.  
 Oil 110 bbls., 1st 24 hrs.  
 Fresh water - feet - feet  
 Salt water - feet - feet

Casing and Tubing	Used in Drilling	Left in Well	Packers
Size			
16			Kind of Packer <u>-</u>
13			
10	<u>185'</u>		Size of <u>-</u>
8 1/4	<u>910'</u>		
6 5/8	<u>1775'</u>		Depth set <u>-</u>
5 3/16	<u>1797</u>		
3			Perf. top <u>-</u>
2			Perf. bottom <u>-</u>
Liners Used			Perf. top <u>-</u>
			Perf. bottom <u>-</u>

CASING CEMENTED - SIZE - No. FT. - Date -  
 COAL WAS ENCOUNTERED AT 375 FEET 48 INCHES  
- FEET - INCHES - FEET - INCHES  
- FEET - INCHES - FEET - INCHES

Formation	Color	Hard or Soft	Top	Bottom	Oil Gas or Water	Depth Found	Remarks
Pittsburgh Coal			375	379			
Big Dunkard Sand			910	1100			
Big Lime			1725	1760			
Big Injun Sand			1775	1870			
Fifty Foot Sand			2300	2360			
Gordon Sand			2480	2548			
Fifth Sand			2737	2745			
Total Depth				2757			

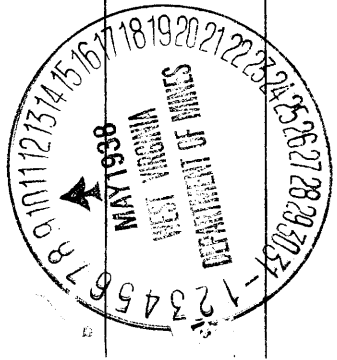

n

Co. or

Hard or  
Soft

Top

Bottom

Oil, Gas  
or Water

D pth  
F and

Remar.

n	Co. or	Hard or Soft	Top	Bottom	Oil, Gas or Water	D pth F and	Remar.

Date **May 9,** 19**38**

APPROVED **SOUTH PENN OIL COMPANY,** Owner

By *Edwin Young* Land Agent.  
(Title)