


LATITUDE 39° 20'

LONGITUDE 80° 20'

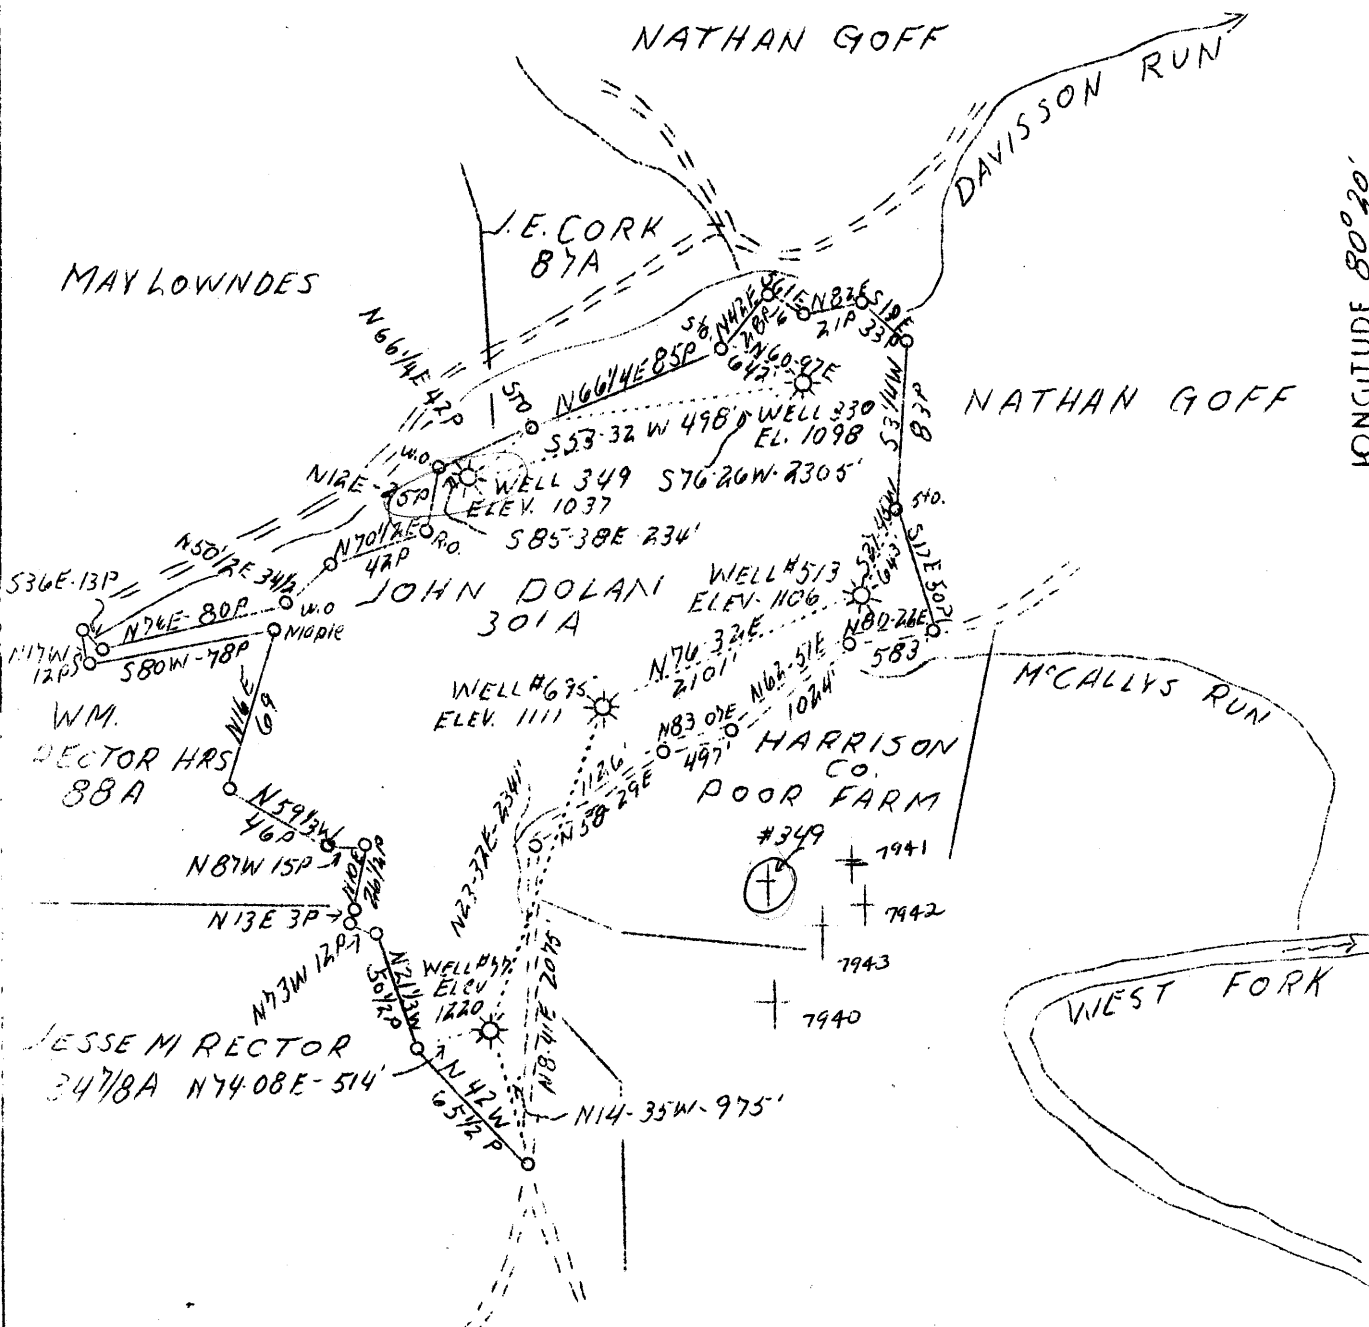

H 835
3.18W

S-9.90
W-3.23

ABD. Well #349

F.B. #678 P23,24,25 SH. 44 514E12

Company Reserve Gas Co.
 Address Clarksburg, W.Va.
 Farm, John Delan
 Acres 300
 Lease No. 604
 Serial No. R - 349 (77, 330, 513, 695)
 Well (Farm) No. 1, 2, 3, 4, 5,
 El. (S.L.) 1037 - Others Shown on Plat
 Quadrangle SC Clarksburg
 County Harrison
 District Clark
 Eng. W.M. Bowers
 Eng. Reg. No. 900
 Date 8/10/39
 Scale 1" = 80 P

STATE OF WEST VIRGINIA
 Department of Mines
 OIL AND GAS DIVISION
 Charleston

WELL LOCATION MAP
 File No. HOF-511-A

x Denotes location of well on U.S. Topographic Maps, scale 1 to 62,500, latitude and longitude lines being represented by border lines as shown.
 - Denotes one inch spaces on border line of original tracing.

STATE OF WEST VIRGINIA
DEPARTMENT OF MINES
OIL AND GAS DIVISION

402

WELL RECORD

Permit No. 511-A
Clarksburg, W. Va.

Oil or Gas Well Gas
(Kind)

Company Reserve Gas Company
Address Clarksburg, W. Va.
Farm John Dolan Acres 300
Location (waters) Davisson's Run
Well No. 349 Elev. 1037
District Clark County Harrison
The surface of tract is owned in fee by John Dolan
Address Clarksburg, W. Va.
Mineral rights are owned by _____
Address _____
Drilling commenced 4-18-1912
Drilling completed 5-25-1912 Deeper in 1919
Date shot 11-17-1919 Depth of shot 2930-2940
Open Flow /10ths Water in _____ Inch _____
/10ths Merc. in _____ Inch _____

Casing and Tubing	Used in Drilling	Left in Well	Packers
Size			Kind of Packer
16			
13			
10	147	Pulled	Size of
8 1/4	980	Pulled	
6 5/8	1340	1340	Depth set
5 3/16	2089	2089	
3			Perf. top
2	2958	2958	Perf. bottom
Liners Used			Perf. top
			Perf. bottom

Volume _____ Cu. Ft. _____
Rock Pressure _____ lbs. _____ hrs. _____
Oil _____ bbls., 1st 24 hrs. _____
Fresh water None recorded feet _____ feet _____
Salt water None recorded feet _____ feet _____

CASING CEMENTED _____ SIZE _____ No. FT. _____ Date _____
Not cemented
COAL WAS ENCOUNTERED AT _____ FEET _____ INCHES
_____ FEET No coal INCHES _____ FEET _____ INCHES
_____ FEET _____ INCHES _____ FEET _____ INCHES

Formation	Color	Hard or Soft	Top	Bottom	Oil Gas or Water	Depth Found	Remarks
Big Dunkard Sand			360	416			
Gas Sand			580	600			
First Salt Sand			630	780			
Second Salt Sand			800	845			
Maxon Sand			1120	1160			
Little Lime			1235	1245			
Pencil Cave			1245	1250			
Big Lime			1250	1330			
Big Injun Sand			1330	1425			
Squaw Sand			1440	1450			
Fifty Foot Sand			1778	1828			
Thirty Foot Sand			1900	1920	Gas	1910	
Gordon Stray Sand			2085	2095			
Fifth Sand			2235	2250	Gas	2237-2245	
Speechley Sand			2929	2939	Gas	2932-2936	
Total Depth				2958			

Formation	Color	Hard or Soft	Top	Bottom	Oil, Gas or Water	Depth Found	Remarks

Date August 9, 19 39

APPROVED Hess Corp, Owner

By [Signature] General Supt.
(Title)