

New Location
 Drill Deeper
 Abandonment X

Company RESERVE GAS CO.
 Address CLARKSBURG, W.VA.
 Farm J. A. GANTHROP
 Tract 1 Acres 235 Lease No. 22
 Well (Farm) No. 2 Serial No. R-239
 Elevation (Spirit Level) 1377 - others Above
 Quadrangle CLARKSBURG S
 County HARRISON District CLARK
 Engineer Wm Bowers
 Engineer's Registration No. 900
 File No. _____ Drawing No. _____
 Date DEC. 2, 1939 Scale 1"=400'

BK683 P-5

STATE OF WEST VIRGINIA
 DEPARTMENT OF MINES
 OIL AND GAS DIVISION
 CHARLESTON

WELL LOCATION MAP
 FILE NO. HAR-546-A

+ Denotes location of well on United States Topographic Maps, scale 1 to 62,500, latitude and longitude lines being represented by border lines as shown

- Denotes one inch spaces on border line of original tracing.

WEST VIRGINIA DEPARTMENT OF MINES

OIL & GAS DIVISION

W E L L R E C O R D

Permit No. Mar-546A (Plumbing)

- Quad.

Gas Well
CASING & TURNING

Company	Reserve Gas Company	10	243	243
Address	Clarksburg, W. Va.	8-1/4	1223	pulled
Farm	J. A. Garthron ACRES 235	6-5/8	1644	1644
Location	Simpson Fork	5-3/16	2360	2360
Well No.	239 ELEV. 1377	2	3221	3221
District	Coal - Harrison County			
Surface	C. S. Garthron, Wolf Summit, W. Va.		10" casing set at 243 and	cemented through coal
Commenced	April 11, 1910			
Completed	May 24, 1910 Deeper in 1921			
Open Flow	-		COAL AT:	
Volume	-		205'	96"
Rock Pressure	-			
Water	None recorded			

Formation TOP Base Result

Pgh. Coal	205	213	
Little Dunkard Sand	600	620	
Big Dunkard Sand	710	735	
Gas Sand	1050	1078	
First Salt Sand	1095	1118	
Second Salt Sand	1215	1257	
Maxon Sand	1500	1554	
Little Lime	1610	1622	
Pencil Cave	1622	1640	
Big Lime	1640	1695	
Big Injun Sand	1695	1812	Gas 1790
Fifty Foot Sand	2110	2155	
Thirty Foot Sand	2210	2240	
Gordon Stray Sand	2360	2394	
Gordon Sand	2402	2438	
Fourth Sand	2445	2485	
Fifth Sand	2623	2656	Gas 2626
Speechley Sand	3316	3323	Gas 3318

1640
100
1800
1377
423

Total Depth 3338

NOW DRY WELL
(Plat Service Data Jan. 1940)

125W
310S
SW Clarksburg

STATE OF WEST VIRGINIA
DEPARTMENT OF MINES
OIL AND GAS DIVISION

448

WELL RECORD

Permit No. Huc-5461 Blugging

Oil or Gas Well Gas
(Kind)

Company Reserve Gas Company
Address Clarksburg, W. Va.
Farm J. A. Gawthrop Acres 235
Location (waters) Simpson Fork
Well No. 239 Elev. 1377
District Coal County Harrison
The surface of tract is owned in fee by C. S. Gawthrop
Address Wolf Summit, W.Va.


Mineral rights are owned by _____
Address _____
Drilling commenced Apr. 11, 1910
Drilling completed May 24, 1910 Deeper in 1921
Date shot _____ Depth of shot _____
Open Flow /10ths Water in _____ Inch
/10ths Merc. in _____ Inch

Volume _____ Cu. Ft.
Rock Pressure _____ lbs. _____ hrs.
Oil _____ bbls., 1st 24 hrs.
Fresh water None recorded feet _____ feet
Salt water None recorded feet _____ feet

Casing and Tubing	Used in Drilling	Left in Well	Packers
Size			Kind of Packer
16			
13			
10	243	243	Size of
8 1/4	1223	Pulled	
6 5/8	1644	1644	Depth set
5 3/16	2368	2368	
3			Perf. top
2	3341	3341	Perf. bottom
Liners Used			Perf. top
			Perf. bottom

CASING CEMENTED _____ SIZE _____ No. Ft. _____ Date
10" casing set at 243 and cemented through coal.
COAL WAS ENCOUNTERED AT 205 FEET 96 INCHES
_____ FEET _____ INCHES FEET _____ INCHES
_____ FEET _____ INCHES FEET _____ INCHES

Formation	Color	Hard or Soft	Top	Bottom	Oil, Gas or Water	Depth Found	Remarks
Pittsburgh Coal			205	213			
Little Dunkard Sand			600	620			
Big Dunkard Sand			710	735			
Gas Sand			1050	1078			
First Salt Sand			1095	1118			
Second Salt Sand			1215	1257			
Maxon Sand			1500	1554			
Little Lime			1610	1622			
Pencil Cave			1622	1640			
Big Lime			1640	1695			
Big Injun Sand			1695	1812	Gas	1790	
Fifty Foot Sand			2110	2155			
Thirty Foot Sand			2210	2240			
Gordon Stray Sand			2360	2394			
Gordon Sand			2402	2438			
Fourth Sand			2445	2485			
Fifth Sand			2623	2656	Gas	2626	
Speechley Sand			3316	3323	Gas	3318	
Total Depth				3338			

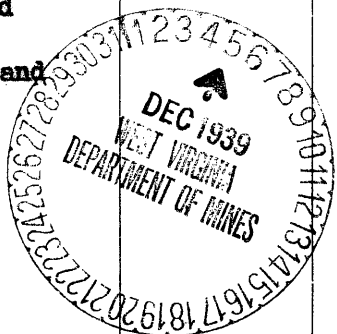

Formation	Color	Hard or Soft	Top	Bottom	Oil, Gas or Water	Depth Found	Remarks

Date December 2, 1939

APPROVED Reserve Gas Company, Owner

By *W. R. Reed* General Supt.
 (Title) *m*