

New Location
 Drill Deeper
 Abandonment

Bk. 525 P. 27 513 E 20 MAP 43

Company HOPE NATURAL GAS CO.
 Address CLARKSBURG W. VA
 Farm Jones & Dunkin
 Tract _____ Acres .387 Lease No. 45523
 Well (Farm) No. 1 Serial No. 7598
 Elevation (Spirit Level) 1011
 Quadrangle CLARKSBURG
 County Harrison District Simpson
 Engineer W M Bowers
 Engineer's Registration No. 900
 File No. _____ Drawing No. _____
 Date Sep-3rd 1942 Scale 1" = 50'

STATE OF WEST VIRGINIA
 DEPARTMENT OF MINES
 OIL AND GAS DIVISION
 CHARLESTON

WELL LOCATION MAP
 FILE NO. ITAR-744-A

+ Denotes location of well on United States Topographic Maps, scale 1 to 62,500, latitude and longitude lines being represented by border lines as shown.
 - Denotes one inch spaces on border line of original tracing.

3.745
 0.32 W

3.815
 0.33 W

STATE OF WEST VIRGINIA
DEPARTMENT OF MINES
OIL AND GAS DIVISION

605

WELL RECORD

Permit No. 744-A Oil or Gas Well Gas
(KIND)


Company Hope Natural Gas Company.
Address 445 West Main St. Clarksburg, W. Va.
Farm Jones-Dunkin Acres Lot (6.387)
Location (waters) 7508
Well No. 7508 Elev. 1011
District Simpson County Harrison
The surface of tract is owned in fee by _____
Address _____
Mineral rights are owned by _____
Address _____
Drilling commenced Feb. 13, 1923
Drilling completed Feb. 13, 1923
Date Shot no record From _____ To _____
With _____
Open Flow /10ths Water in _____ Inch
/10ths Merc. in _____ Inch
Volume _____ Cu. Ft.
Rock Pressure _____ lbs. _____ hrs.
Oil no record bbls., 1st 24 hrs.
Fresh water no record feet _____ feet
Salt water no record feet _____ feet

Casing and Tubing	Used in Drilling	Left in Well	Packers
Size			
16			Kind of Packer
13			
10	160	160	Size of
8 1/4			
6 3/8			Depth set
5 3/16			
3	2298	2298	Perf. top
2			Perf. bottom
Liners Used			Perf. top
			Perf. bottom

No record
CASING CEMENTED _____ SIZE _____ No. Ft. _____ Date _____
Annular space between tubing and 10" casing
None recorded Filled with cement
COAL WAS ENCOUNTERED AT _____ FEET _____ INCHES
_____ FEET _____ INCHES FEET _____ INCHES
_____ FEET _____ INCHES FEET _____ INCHES

Formation	Color	Hard or Soft	Top	Bottom	Oil, Gas or Water	Depth Found	Remarks
	Little Dunkard		250	300			
	Big Dunkard		320	400			
	Gas sand		420	510			
	First Salt sand		530	620			
	Second Salt sand		640	740			
	Maxon sand		1025	1065			
	Little Lime		1140	1180			
	Pencil cave		1150	1155			
	Big Lime		1155	1219			
	Big Injun sand		1219	1325	Gas	1237-1239	
	Fifty Foot		1660	1725	Gas	1710	
	Thirty Foot		1837	1885			
	Gordon sand		1838	1839			
	Fifth Sand		2215	2245	Gas	??	
	Total depth			2298			

Formation	Color	Hard or Soft	Top	Bottom	Oil, Gas or Water	Depth Found	Remarks

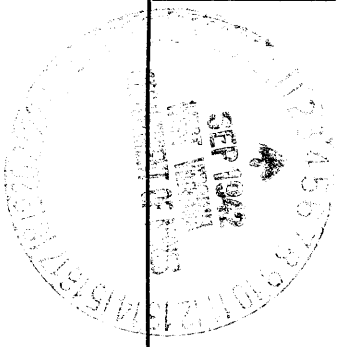

Date September 3, 1942, 194

APPROVED Hope Natural Gas Company, Owner

By [Signature] Gen. Sup't.

(Title)