


TOWN OF BRIDGEPORT

MECHANIC ST.

VIRGINIA AVE.

WATER ST.

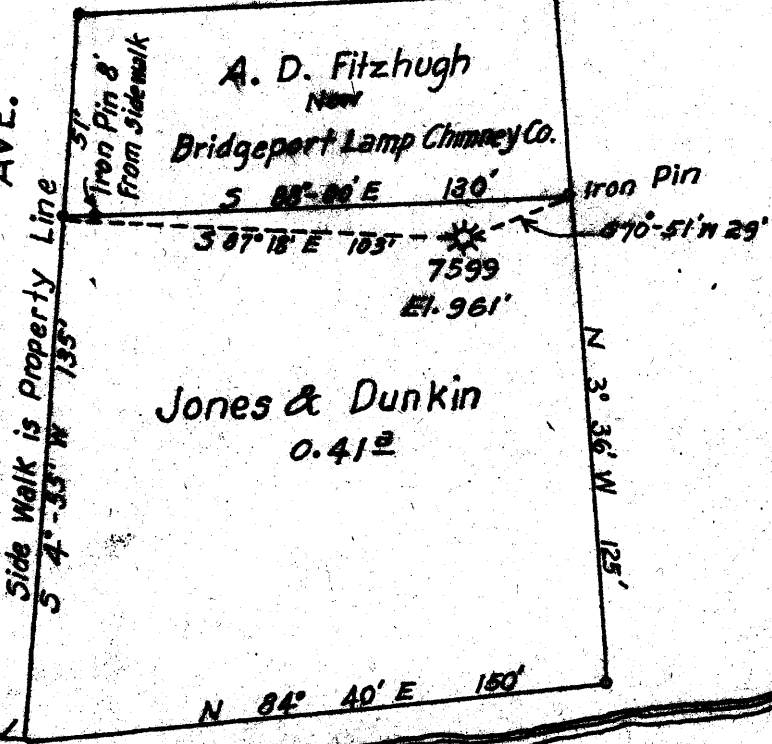

SIMPSON CREEK

3.40 S
0.36 W
3.36 S
0.36 W

- New Location
- Drill Deeper
- Abandonment

Map Sheet 43-Square-512E20-FB 525 P26

Company Hope Natural Gas Co.
 Address Clarksburg, W. Va.
 Farm Jones & Duncan
 Tract Acres 0.41 Lease No. 45822
 Well (Farm) No. 1 Serial No. 7599
 Elevation (Spirit Level) 961
 Quadrangle Clarksburg
 County Harrison District Simpson
 Engineer W. M. Brown
 Engineer's Registration No. 900
 File No. _____ Drawing No. _____

STATE OF WEST VIRGINIA
 DEPARTMENT OF MINES
 OIL AND GAS DIVISION
 CHARLESTON

WELL LOCATION MAP
 FILE NO. HAR-745-A

★ Denotes location of well on United States Topographic Maps, scale 1 to 62,500, latitude and longitude lines being represented by border lines as shown.

— Denotes one inch spaces on border line of original tracing.

Date May 22 1962 Scale 1"=50'