

Coal: State of West Virginia
 Surface: Simon Shriver
 Wallace, W. Va.
 R.F.D. #3.

2.83S
 2.61W
 2.87S
 2.88W

New Location...
 Drill Deeper...
 Abandonment...

N1 E9 M20 N49

Company South Penn Natural Gas Co.
 Address Parkersburg, W. Va.
 Farm S. S. Shriver
 Tract _____ Acres 145 Lease No. 33970
 Well (Farm) No. 2 Serial No. _____
 Elevation (Spirit Level) 1123.14
 Quadrangle Clarksburg
 County Harrison District Eagle
 Engineer Emmon Haines
 Engineer's Registration No. _____
 File No. _____ Drawing No. _____
 Date Feb. 6, 1943 Scale 1" = 800'

STATE OF WEST VIRGINIA
 DEPARTMENT OF MINES
 OIL AND GAS DIVISION
 CHARLESTON

WELL LOCATION MAP
 FILE NO. HAR. 757-A

+ Denotes location of well on United States Topographic Maps, scale 1 to 62,500, latitude and longitude lines being represented by border lines as shown.
 - Denotes old well spoils on border line of original tracing.

STATE OF WEST VIRGINIA
DEPARTMENT OF MINES
OIL AND GAS DIVISION

622

WELL RECORD

Permit No. 757-A

Oil or Gas Well OIL
(KIND)


Company South Penn Natural Gas Company
Address Union Trust Bldg. Parkersburg, W. Va.
Farm S. S. Shriver Acres 145
Location (waters) Bingamon Creek
Well No. 2 Elev. 1123.14
District Eagle County Harrison
The surface of tract is owned in fee by Simon Shriver
R.D. No. 3, Address Wallace, W. Va.
Mineral rights are owned by Ellis Shriver et al
Rte No. 1, Address Worthington, W. Va.
Drilling commenced Aug. 24, 1904
Drilling completed Nov. 15, 1904
Date Shot 11-15-04 - 30 Qts. - Gordon
5-22-16 - From 40 Qts. Gordon
With --

Casing and Tubing	Used in Drilling	Left in Well	Packers
Size			
16			Kind of Packer -
13			-
10	225' (Pulled)		Size of -
8 1/4	1219'		-
6 5/8	2250'		Depth set -
5 3/16			-
3			Perf. top -
2			Perf. bottom -
Liners Used			Perf. top -
Cond. 16'			Perf. bottom -

Open Flow /10ths Water in p-- Inch
/10ths Merc. in --- Inch
Volume --- Cu. Ft.
Rock Pressure -- lbs. -- hrs.
Oil 20 bbls., 1st 24 hrs.
Fresh water --- feet --- feet
Salt water --- feet --- feet

CASING CEMENTED - SIZE - No. Ft. - Date -
COAL WAS ENCOUNTERED AT 860 FEET 60 INCHES
- FEET - INCHES - FEET - INCHES
- FEET - INCHES - FEET - INCHES

Formation	Color	Hard or Soft	Top	Bottom	Oil, Gas or Water	Depth Found	Remarks
Pittsburgh Coal			860	865			
Big Dunkard Sand			1365	1470			
Salt Sand			1800	2000			
Big Lime			2085	2125			
Big Injun Sand			2125	2240			
30 Ft. Sand			2750	2785			
Stray Sand			2875	2945			
Slate			2945	2954			
Gordon Sand			2954	2998			
					Oil	2962	
Total Depth				3026			

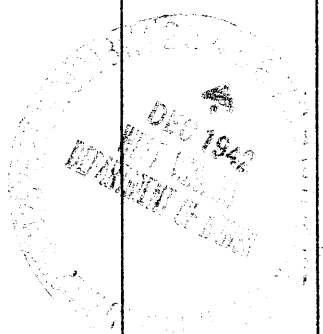

Formation	Color	Hard or Soft	Top	Bottom	Oil, Gas or Water	Depth Found	Remarks

Date December 4, 1942., 194

APPROVED SOUTH PENN NATURAL GAS COMPANY, Owner

By *Edwin Young* Land Agent
(Title)