

New Location
 Drill Deeper
 Abandonment

Map Sheet 43 Square 513 E 19 F.B. 527 P5

Company HOPE NATURAL GAS CO.
 Address CLARKSBURG, W. VA.
 Farm BENJAMIN STOUT
 Tract _____ Acres 6 Lease No. 45506
 Well (Farm) No. 1 Serial No. 7587
 Elevation (Spirit Level) 1108
 Quadrangle CLARKSBURG
 County HARRISON District SIMPSON
 Engineer W. M. Bowers
 Engineer's Registration No. 900
 File No. _____ Drawing No. _____
 Date AUG. 20, 1943 Scale 1" = 200'

STATE OF WEST VIRGINIA
 DEPARTMENT OF MINES
 OIL AND GAS DIVISION
 CHARLESTON

WELL LOCATION MAP
 FILE NO. HAR-781-A

+ Denotes location of well on United States Topographic Maps, scale 1 to 62,500, latitude and longitude lines being represented by border lines as shown.
 - Denotes one inch spaces on border line of original tracing.



STATE OF WEST VIRGINIA
DEPARTMENT OF MINES
OIL AND GAS DIVISION

629

WELL RECORD

Permit No. 781-A


Oil or Gas Well (KIND)

Company Hops Natural Gas Company
 Address 44 West Main St. Clarksburg, W. Va.
 Farm Benjamin Stout Acres 6
 Location (waters) _____
 Well No. 7587 Elev. 1108
 District Simpson County Harrison
 The surface of tract is owned in fee by _____
 Address _____
 Mineral rights are owned by _____
 Address _____
 Drilling commenced purchased no record
 Drilling completed _____
 Date Shot _____ From _____ To _____
 With _____
 Open Flow _____ /10ths Water in _____ Inch
 _____ /10ths Merc. in _____ Inch
 Volume _____ Cu. Ft.
 Rock Pressure _____ lbs _____ hrs.
 Oil _____ bbls., 1st 24 hrs.
 Fresh water no record feet _____ feet
 Salt water no record feet _____ feet

Casing and Tubing	Used in Drilling	Left in Well	Packers
Size			
16.			Kind of Packer
13.			
10.			Size of
8 1/2			
6 5/8	1396	1396	Depth set
5 3/16			
3.			Perf. top
2.	2406	Pulled	Perf. bottom
Liners Used			Perf. top
			Perf. bottom

CASING CEMENTED No record SIZE _____ No. Ft. _____ Date _____
 COAL WAS ENCOUNTERED AT none recorded FEET _____ INCHES _____
 FEET _____ INCHES _____ FEET _____ INCHES _____
 FEET _____ INCHES _____ FEET _____ INCHES _____

Formation	Color	Hard or Soft	Top	Bottom	Oil, Gas or Water	Depth Found	Remarks
Gas sand			422	468 Est.			
1st Salt			528	568 Est.			
2nd Salt			628	673 Est.			
Maxon sand			913	928 Est.			
Big Lime			1213	1277 Est.			
Big Injun			1277	1424 Est.			
Fifty Foot			1755	1815	gas	1765	
Fifth sand			2287	2323	gas	2304	
Total depth				2406			

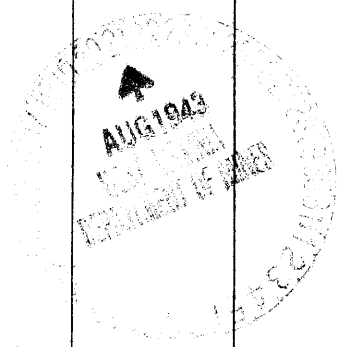

Formation	Color	Hard or Soft	Top	Bottom	Oil, Gas or Water	Depth Found	Remarks

Date August 20, 1943., 194

APPROVED Hope Natural Gas Company., Owner

By  Gen. Sup't.