

2.6S
1.01W

New Location

Drill Deeper

Abandonment

Company CARNEGIE NATURAL GAS

Address PITTSBURGH, PENNA.

Farm S.T. RITTENHOUSE

Tract ONE Acres 1.4 Lease No. E-70-14-29

Well (Farm) No. 1 Serial No. 401

Elevation (Spirit Level) 965'

Quadrangle CLARKSBURG N.W.

County HARRISON District SARDIS

Engineer D.T. BRITTON

Engineer's Registration No. _____

File No. _____ Drawing No. _____

Date 12-2-1944 Scale 1" = 100'

STATE OF WEST VIRGINIA
DEPARTMENT OF MINES
OIL AND GAS DIVISION
CHARLESTON

WELL LOCATION MAP
FILE NO. HAR-836-A

+ Denotes location of well on United States Topographic Maps, scale 1 to 62,500, latitude and longitude lines being represented by border lines as shown.

- Denotes one inch spaces on border line of original tracing.



683

STATE OF WEST VIRGINIA
DEPARTMENT OF MINES
OIL AND GAS DIVISION

WELL RECORD
WELL TO BE ABANDONED

Oil or Gas Well Gas
(KIND)

Permit No. 536 A


Company CARNEGIE NATURAL GAS COMPANY
Address 1015 FRICK BLDG., PITTSBURGH, PA.
Farm S. T. RITTENHOUSE Acres 1 1/2
Location (waters) LITTLE TEN MILE CREEK
Well No. 101 Elev. 965
District SARDIS County HARRISON
The surface of tract is owned in fee by ARTHUR C. STIRES Address DOLA, W. VA.
Mineral rights are owned by SAME Address _____
Drilling commenced 10-15-09
Drilling completed 12-15-09
Date Shot _____ From _____ To _____
With _____

Open Flow /10ths Water in _____ Inch
/10ths Merc. in _____ Inch
Volume _____ Cu. Ft.
Rock Pressure _____ lbs _____ hrs.
Oil _____ bbls., 1st 24 hrs.
Fresh water _____ feet _____ feet
Salt water _____ feet _____ feet

Casing and Tubing	Used in Drilling	Left in Well	Packers
Size			
16			Kind of Packer
18			
10	167'	None	Size of
8 1/4	789'	None	
6 3/4	1313'	1313'	Depth set
5 3/16			
3			Perf. top
2		1400'	Perf. bottom
Liners Used			Perf. top
			Perf. bottom

CASING CEMENTED _____ SIZE _____ No. Ft. _____ Date _____
COAL WAS ENCOUNTERED AT _____ FEET _____ INCHES
_____ FEET _____ INCHES _____ FEET _____ INCHES
_____ FEET _____ INCHES _____ FEET _____ INCHES

Formation	Color	Hard or Soft	Top	Bottom	Oil, Gas or Water	Depth Found	Remarks
(Well started 10 ft. below Pittsburgh Coal)							
Big Injun Sand			1382'	1442'	Gas	1387'	
Gantz Sand			1723'	1738'			
50-Foot Sand			1890'	1935'	Gas	1915'	
Gordon Sand			2175'	2205'	Gas	2190'	
4th sand			2240'	2250'			
TOTAL DEPTH				2455'			

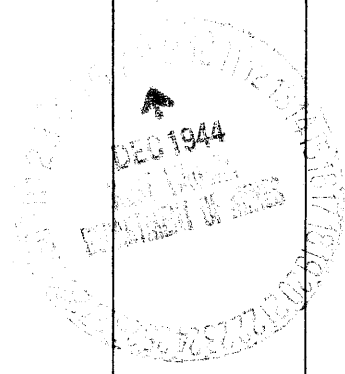

Formation	Color	Hard or Soft	Top	Bottom	Oil, Gas or Water	Depth Found	Remarks

Date DECEMBER 7, 1944

APPROVED CARNEGIE NATURAL GAS COMPANY, Owner

By D. H. Archer
(Title) Land Agent.