

3.41S
1.85W

New Location
Drill Deeper
Abandonment

Map Sheet 43 Square S18E18 FB. 516 P. 9

Company HOPE NATURAL GAS CO.
 Address CLARKSBURG, W.VA.
 Farm IDA L. DAVISSON
 Tract _____ Acres 60 Lease No. 44610
 Well (Farm) No. _____ Serial No. 7373
 Elevation (Spot Level) 1030
 Quadrangle WESTON
 County HARRISON District ELK
 Engineer W.M. Bowen
 Engineer's Registration No. 900
 File No. _____ Drawing No. _____
 Date MAY 14, 1945 Scale 1" = 400'

STATE OF WEST VIRGINIA
DEPARTMENT OF MINES
OIL AND GAS DIVISION
CHARLESTON

WELL LOCATION MAP
FILE NO. HAR-852-A

+ Denotes location of well on United States Topographic Map, scale 1 to 62,500, latitude and longitude lines being represented by border lines as shown.
 - Denotes one inch spaces on border line of original tracing.



STATE OF WEST VIRGINIA
DEPARTMENT OF MINES
OIL AND GAS DIVISION

688

Ab
852-A

WELL RECORD

Oil or Gas Well (KIND)

Permit No. 852-A

Company Hope Natural Gas Company.

Address 445 West Main St. Clarksburg, W. Va.

Farm Ida L. Davisson Acres 60

Location (waters) _____

Well No. 7373 Elev. 1030

District Elk County Harrison

The surface of tract is owned in fee by _____
Address _____

Mineral rights are owned by _____
Address _____

Drilling commenced February 7, 1921

Drilling completed April 10, 1921

Date Shot _____ From _____ To _____

With _____

Open Flow _____ /10ths Water in _____ Inch
_____ /10ths Merc. in _____ Inch

Volume _____ Cu. Ft.

Rock Pressure _____ lbs. _____ hrs.

Oil _____ bbls., 1st 24 hrs.

Fresh water ? feet _____ feet


Salt water none recorded feet _____ feet

Casing and Tubing	Used in Drilling	Left in Well	Packers
Size			
16			Kind of Packer _____
13			
10	156	156	Size of _____
8 1/4	760	760	
6 5/8	1147	1147	Depth set _____
5 3/16			
3			Perf. top _____
2	2090	2090	Perf. bottom _____
Liners Used		<u>Pulled</u>	Perf. top _____
			Perf. bottom _____

Not cemented
CASING CEMENTED _____ SIZE _____ No. Ft. _____ Date _____

None recorded
COAL WAS ENCOUNTERED AT _____ FEET _____ INCHES
_____ FEET _____ INCHES FEET _____ INCHES
_____ FEET _____ INCHES FEET _____ INCHES

Formation	Color	Hard or Soft	Top	Bottom	Oil, Gas or Water	Depth Found	Remarks
Big Dunkard			115	155	water	?	
First Salt			300	375			
Second Salt			400	575			
Maxon			805	830			
Big Lime			1080	1145	gas	1183	
Big Injun			1145	1258			
Gantz			1500	1584	gas	1598	
Fifty foot			1598	1730			
Thirty Foot			1740	1760			
Fifth			2050	2075	gas	2055	
Speechley			2725	2755	gas	2747	
Total depth				2800			
Filled back by original owner to				2090			

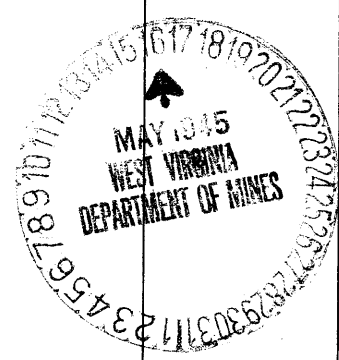

Handwritten initials and scribbles

Formation	Color	Hard or Soft	Top	Bottom	Oil, Gas or Water	Depth Found	Remarks

Date May 14, 1945., 194

APPROVED Hope Natural Gas Company., Owner

By [Signature] Ass't. to Gen. Sup't. (Title)

