

WALTER M. DENNISON

MIKE DOLAN


B. H. BROWN
31.67 S
0.75 W

ELIZABETH FULTZ
60 A

C. L. FULTZ

LLOYD FULTZ

3.52 S
2.70 W

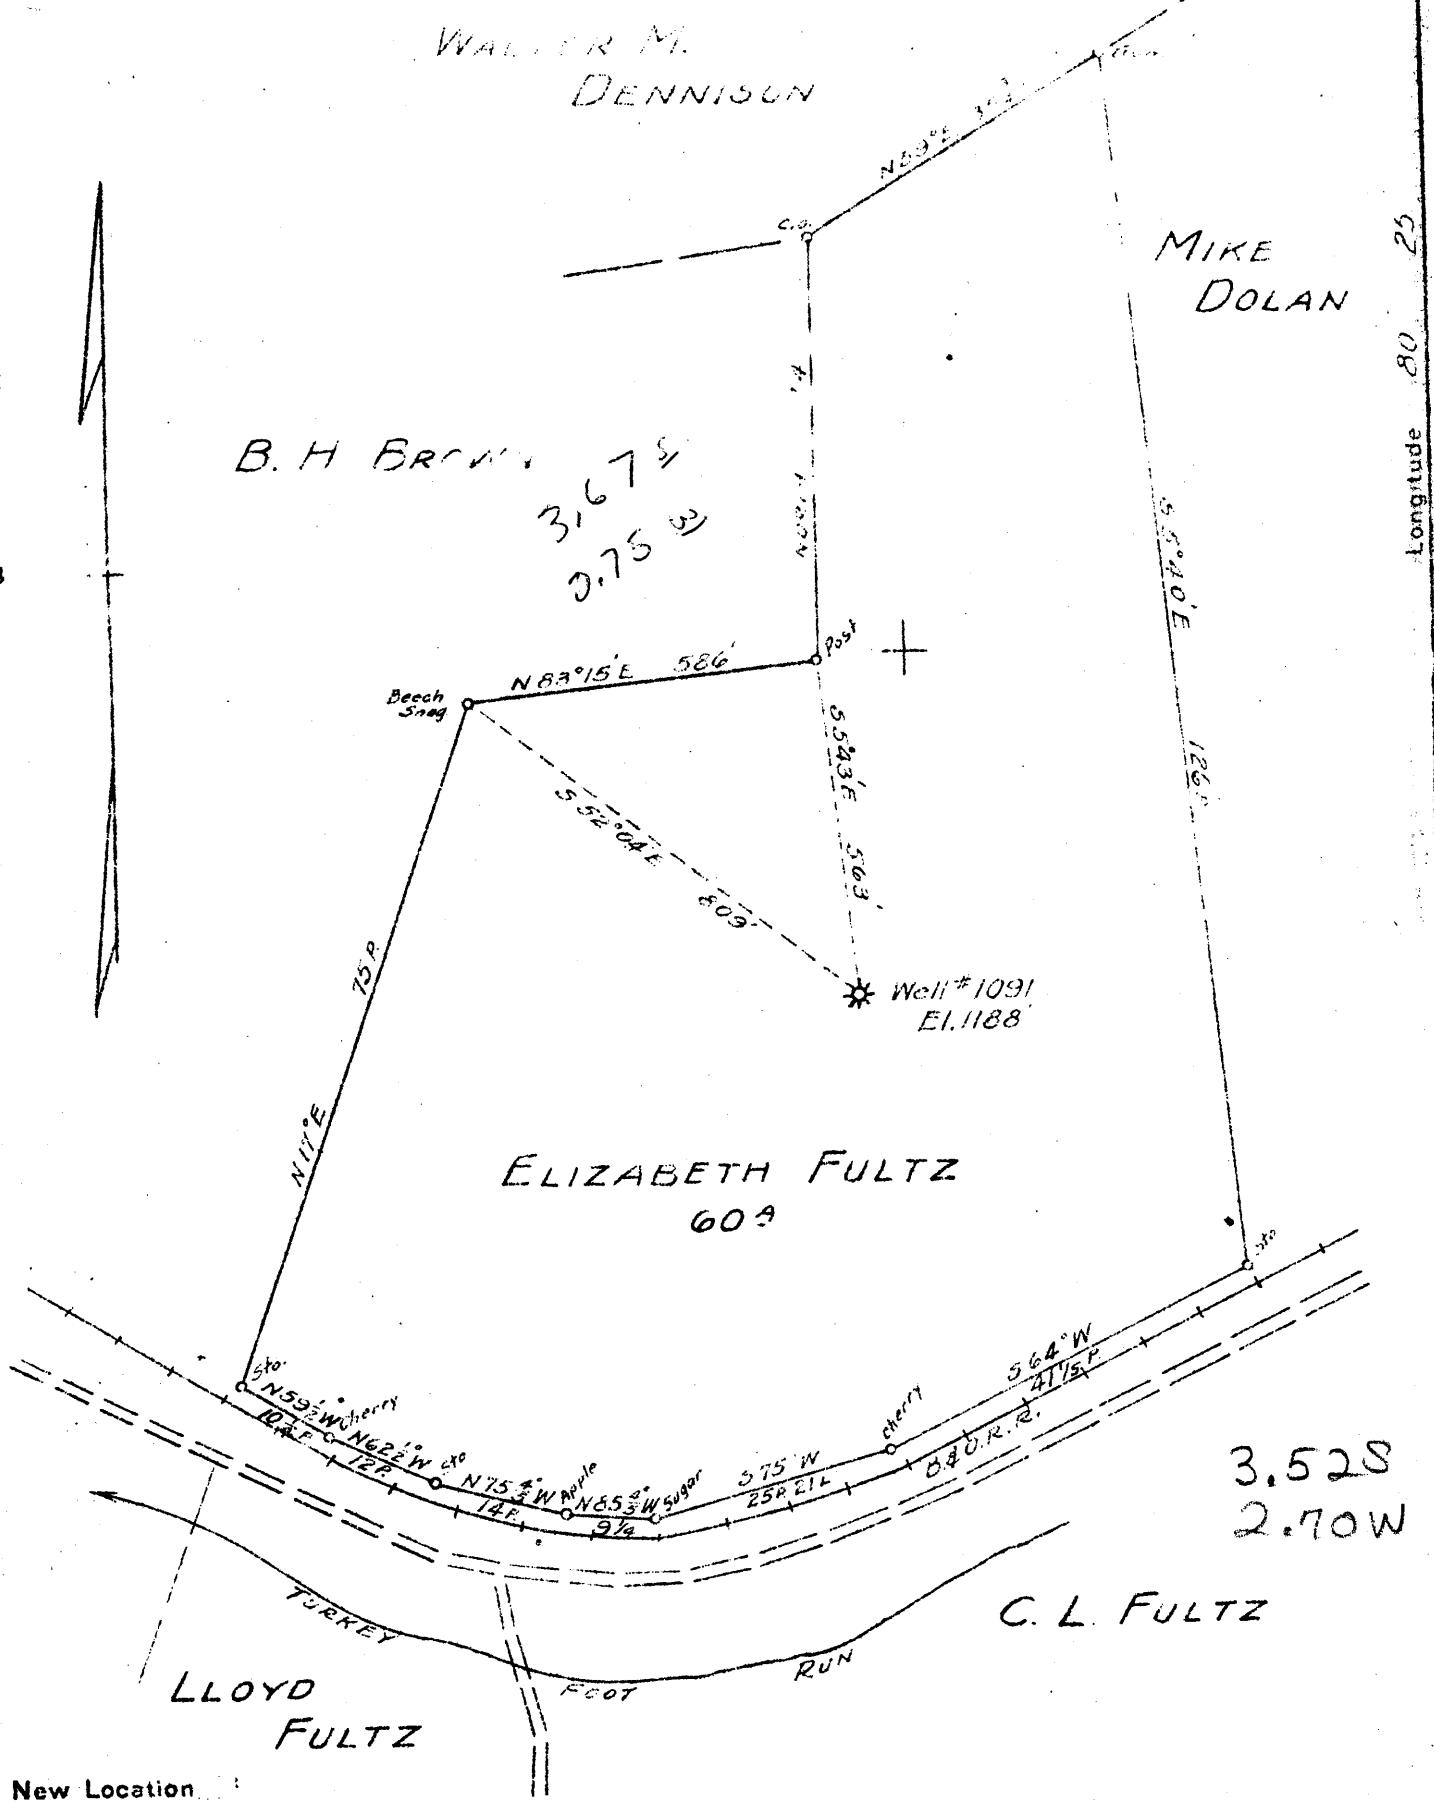

New Location
 Drill Deeper
 Abandonment

Map Sh. 55 Sq. 5-12 E-8 F.B. 773 P. 26

Company HOPE NATURAL GAS CO.
 Address CLARKSBURG, W. VA.
 Farm ELIZABETH FULTZ
 Tract _____ Acres 60 Lease No. 8794
 Well (Farm) No. _____ Serial No. 1091
 Elevation (Spirit Level) 1188'
 Quadrangle CLARKSBURG
 County HARRISON District TEN MILE
 Engineer W. M. Bowen
 Engineer's Registration No. 920
 File No. _____ Drawing No. _____
 Date 5-31-45 Scale 1" = 20 P.

STATE OF WEST VIRGINIA
 DEPARTMENT OF MINES
 OIL AND GAS DIVISION
 CHARLESTON

WELL LOCATION MAP
 FILE NO. HAR-860-A

+ Denotes location of well on United States Topographic Maps, scale 1 to 62,500, latitude and longitude lines being represented by border lines as shown.

- Denotes one inch spaces on border line of original tracing.



698

STATE OF WEST VIRGINIA
DEPARTMENT OF MINES
OIL AND GAS DIVISION

WELL RECORD

Permit No. 860-A


~~Oil~~ Gas Well (KIND)

Company Hope Natural Gas Company
 Address 445 W. Main St. Clarksburg, W. Va.
 Farm Eliz. Fultz Acres 60
 Location (waters) Turkey Foot Run
 Well No. 1091 Elev. 1188
 District Ten Mile County Harrison
 The surface of tract is owned in fee by Carl White
 Address Wolf Summit W. Va.
 Mineral rights are owned by _____
 Address _____
 Drilling commenced August 25, 1908
 Drilling completed October 5, 1908
 Date Shot _____ From _____ To _____
 With _____
 Open Flow _____ /10ths Water in _____ Inch
 _____ /10ths Merc. in _____ Inch
 Volume _____ Cu. Ft.
 Rock Pressure _____ lbs. _____ hrs.
 Oil _____ bbls., 1st 24 hrs.
 Fresh water None recorded feet _____ feet
 Salt water None recorded feet _____ feet

Casing and Tubing	Used in Drilling	Left in Well	Packers
Size			
16			Kind of Packer
13			
10	313	Pulled	Size of
8 1/4	850	Pulled	
6 5/8	1811	1811	Depth set
5 3/16	2416	2416	
3			Perf. top
2	2656	2656	Perf. bottom
Liners Used			Perf. top
			Perf. bottom

CASING CEMENTED _____ SIZE _____ No. Ft. _____ Date _____
None recorded
 COAL WAS ENCOUNTERED AT 205 FEET 48 INCHES
226 FEET 108 INCHES FEET INCHES
 FEET INCHES FEET INCHES

Formation	Color	Hard or Soft	Top	Bottom	Oil, Gas or Water	Depth Found	Remarks
Native Coal			205	209			
Pgh. Coal			226	235			
Little Dunkard			645	685			
Big Dunkard			730	810			
Gas Sand			945	1015			
Salt Sand			1035	1085			
Second Salt			1150	1272			
Maxon			1400	1425			
Little Lime			1600	1616			
Pencil Cave			1616	1689			
Big Lime			1689	1747			
Berea			2045	2070			
Fifty Foot			2140	2170			
Thirty Foot			2280	2334	Gas	2284	
Gordon Stray			2345	2388	Gas	2385	
Gordon			2391	2421			
Fourth			2440	2455			
Fifth			2565	2576	Gas	2565-2576	
Slate			2581	2771			
Bayard			2771	2772			
Slate			2772	2809			
Original total depth				2809			
Lower hole previously abandoned to 2645.				2645			
Present total depth				2645			

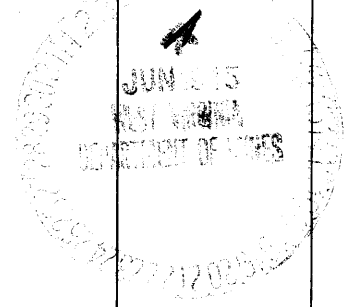

AUG - 8 1945

Formation	Color	Hard or Soft	Top	Bottom	Oil, Gas or Water	Depth Found	Remarks

Date June 5, 1945., 194

APPROVED Hope Natural Gas Company., Owner

By *J. J. Tracy*
 Ass't. to Gen. Supt. (Title)

