

New Location  
 Drill Deeper  
 Abandonment  2835

532 P. 30  
 Map Sh. 41 Sq. 5-4 E-13 F.B. 535 P. 18 & 19

Company HOPE NATURAL GAS CO.  
 Address CLARKSBURG, W. VA.  
 Farm C. F. HARBERT  
 Tract Acres 100 Lease No. 13388  
 Well (Farm) No. \_\_\_\_\_ Serial No. AS SHOWN  
 Elevation (Spirit Level) AS SHOWN  
 Quadrangle CLARKSBURG  
 County HARRISON District EAGLE  
 Engineer W. N. Bowers  
 Engineer's Registration No. 900  
 File No. \_\_\_\_\_ Drawing No. \_\_\_\_\_  
 Date 11-2-45 Scale 1" = 40 P

STATE OF WEST VIRGINIA  
 DEPARTMENT OF MINES  
 OIL AND GAS DIVISION  
 CHARLESTON

**WELL LOCATION MAP**  
 FILE NO. HAR-911-A  
# 2835

+ Denotes location of well on United States Topographic Maps, scale 1 to 62,500, latitude and longitude lines being represented by border lines as shown.

- Denotes one inch spaces on border line of original tracing.



741

STATE OF WEST VIRGINIA  
DEPARTMENT OF MINES  
OIL AND GAS DIVISION

WELL RECORD

Permit No. 911-A


Oil or Gas Well (KIND)

Company Hope Natural Gas Company.  
 Address 445 West Main St. Clarksburg, W.Va.  
 Farm C.F. Harbert Acres 100  
 Location (waters) \_\_\_\_\_  
 Well No. 2835 Elev. 1125  
 District Eagle County Harrison  
 The surface of tract is owned in fee by \_\_\_\_\_  
 Address \_\_\_\_\_  
 Mineral rights are owned by \_\_\_\_\_  
 Address \_\_\_\_\_  
 Drilling commenced April 7, 1913  
 Drilling completed May 14, 1913  
 Date Shot \_\_\_\_\_ From \_\_\_\_\_ To \_\_\_\_\_  
 With \_\_\_\_\_  
 Open Flow \_\_\_\_\_ /10ths Water in \_\_\_\_\_ Inch  
 \_\_\_\_\_ /10ths Merc. in \_\_\_\_\_ Inch  
 Volume \_\_\_\_\_ Cu. Ft.  
 Rock Pressure \_\_\_\_\_ lbs. \_\_\_\_\_ hrs.  
 Oil \_\_\_\_\_ bbls., 1st 24 hrs.  
 Fresh water 370 feet \_\_\_\_\_ feet  
 Salt water 760 feet \_\_\_\_\_ feet


Casing and Tubing	Used in Drilling	Left in Well	Packers
Size			
16			Kind of Packer
13			
10	<u>98</u>	<u>95</u>	Size of
8 1/4	<u>944</u>	<u>Pulled</u>	
6 5/8	<u>1418</u>	<u>1418</u>	Depth set
5 3/16	<u>2177</u>	<u>2177</u>	
5			Perf. top
2			Perf. bottom
Liners Used			Perf. top
			Perf. bottom

CASING CEMENTED Not cemented No. Ft. \_\_\_\_\_ Date \_\_\_\_\_  
 COAL WAS ENCOUNTERED AT none recorded FEET \_\_\_\_\_ INCHES  
 \_\_\_\_\_ FEET \_\_\_\_\_ INCHES FEET \_\_\_\_\_ INCHES  
 \_\_\_\_\_ FEET \_\_\_\_\_ INCHES FEET \_\_\_\_\_ INCHES

Formation	Color	Hard or Soft	Top	Bottom	Oil, Gas or Water	Depth Found	Remarks
Little Dunkard			358	378	Water	370	
Big Dunkard			425	590	show gas	445	
Gas sand			685	755			
First Salt			760	985	water	760	
Second Salt			990	1100			
Maxon			1255	1265			
Little Lime			1295	1309			
Pencil cave			1309	1312			
Big Lime			1312	1406			
Big Injun			1406	1484			
Squaw			1490	1519	gas	1492	
Berea			1630	1655			
Gantz			1845	1868			
Fifty foot			1919	1973			
Thirty Foot			2010	2045			
Gordon stray			2162	2175			
Gorden			2198	2224	gas	2200 2219	
Fourth			2249	2258			
Fifth			2350	2358	gas	2352	
Total depth				2388			

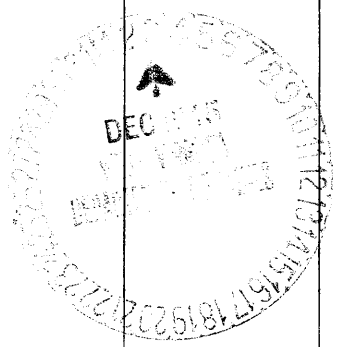

Formation	Color	Hard or Soft	Top	Bottom	Oil, Gas or Water	Depth Found	Remarks

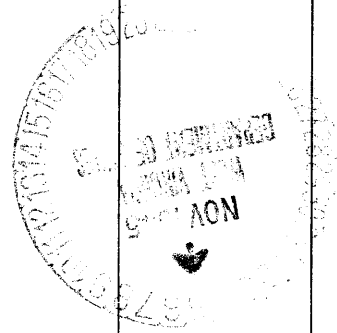

Date \_\_\_\_\_, 194\_\_

APPROVED \_\_\_\_\_, Owner

By *[Signature]*  
(Title)

