

2.06 S
2.20 W

New Location
 Drill Deeper
 Abandonment

Map Sh. 56 Sq. 5-17E-13 F.B. 529 P.13

Company	HOPE NATURAL GAS CO.	
Address	CLARKSBURG, W. VA.	
Farm	JOHN MATHENY	
Tract	Acres 82	Lease No. 21533
Well (Farm) No.	Serial No. 2276	
Elevation (Spirit Level)	989	
Quadrangle	WESTON	
County	HARRISON	District UNION
Engineer	W.M. Bowers	
Engineer's Registration No.	900	
File No.	Drawing No.	
Date Dec 11, 1945	Scale 1" = 40R	

STATE OF WEST VIRGINIA
 DEPARTMENT OF MINES
 OIL AND GAS DIVISION
 CHARLESTON

WELL LOCATION MAP
 FILE NO. HAR-926-A

+ Denotes location of well on United States Topographic Maps, scale 1 to 62,500, latitude and longitude lines being represented by border lines as shown.

- Denotes one inch spaces on border line of original tracing.



773

STATE OF WEST VIRGINIA
DEPARTMENT OF MINES
OIL AND GAS DIVISION

WELL RECORD

Permit No. 9-26-A


Oil or Gas Well _____ (KIND)

Company Hope Natural Gas Company.
 Address 645 West Main St. Clarksburg, W. Va.
 Farm John Matheny Acres 82
 Location (waters) _____
 Well No. 2276 Elev. 989'
 District Union County Harrison
 The surface of tract is owned in fee by _____
 Address _____
 Mineral rights are owned by _____
 Address _____
 Drilling commenced August 9, 1911
 Drilling completed November 11, 1911
 Date Shot _____ From _____ To _____
 With _____
 Open Flow _____ /10ths Water in _____ Inch
 _____ /10ths Merc. in _____ Inch
 Volume _____ Cu. Ft.
 Rock Pressure _____ lbs. _____ hrs.
 Oil _____ bbls., 1st 24 hrs.
 Fresh water 300 feet _____ feet
 Salt water 2159 feet _____ feet

Casing and Tubing	Used in Drilling	Left in Well	Packers
Size			
16			Kind of Packer
13			
10	110	Pulled	Size of
8 1/4			
6% ✓	1402	1402	Depth set
5 3/16	2196	2196	
3			Perf. top
2	2459	2459	Perf. bottom
Liners Used			Perf. top
			Perf. bottom

not cemented
 CASING CEMENTED _____ SIZE _____ No. Ft. _____ Date _____
 none recorded
 COAL WAS ENCOUNTERED AT _____ FEET _____ INCHES
 _____ FEET _____ INCHES FEET _____ INCHES
 _____ FEET _____ INCHES FEET _____ INCHES

Formation	Color	Hard or Soft	Top	Bottom	Oil, Gas or Water	Depth Found	Remarks
Little Dunkard			275	350	water	300	
Big Dunkard			375	460			
Gas sand			550	592	TT-407		
First Salt			635	662	P-615		
Second Salt			685	870			
Third Salt			915	965	TT-700		
Maxon			1050	1067			
Little Lime			1303	1315	P-1374		
Pencil cave			1315	1325	P-1412		
Big Lime			1325	1394			
Big Injun			1394	1507	TT-1537		
Squaw			1517	1620			
Shell			1650	1710			
Gantz			1718	1800			
Fifty foot			1815	1902	P-190 ✓		
Thirty foot			1922	1967	gas	1925	
Red rock			2024	2100			
Gordon Stray			2107	?	P-2087		
Gordon				2188	oil and water	2159 2169	
Fourth			2224	2239	P-2270		
Fifth			2290	2306	gas	2292- 2294	
Bayard			2375	2383			
Total depth				2459			

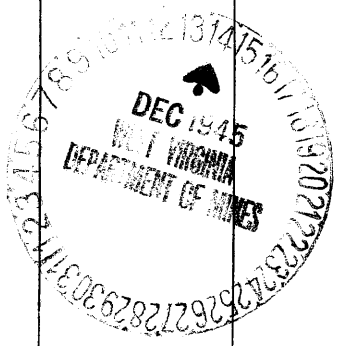

Formation	Color	Hard or Soft	Top	Bottom	Oil, Gas or Water	Depth Found	Remarks

Date December 13, 1945., 194

APPROVED Hope Natural Gas Company., Owner

By *[Signature]* General Superintendent

