


M. J. Holaren

J. B. Williams

M. J. Hickmah

E. D. Shahan

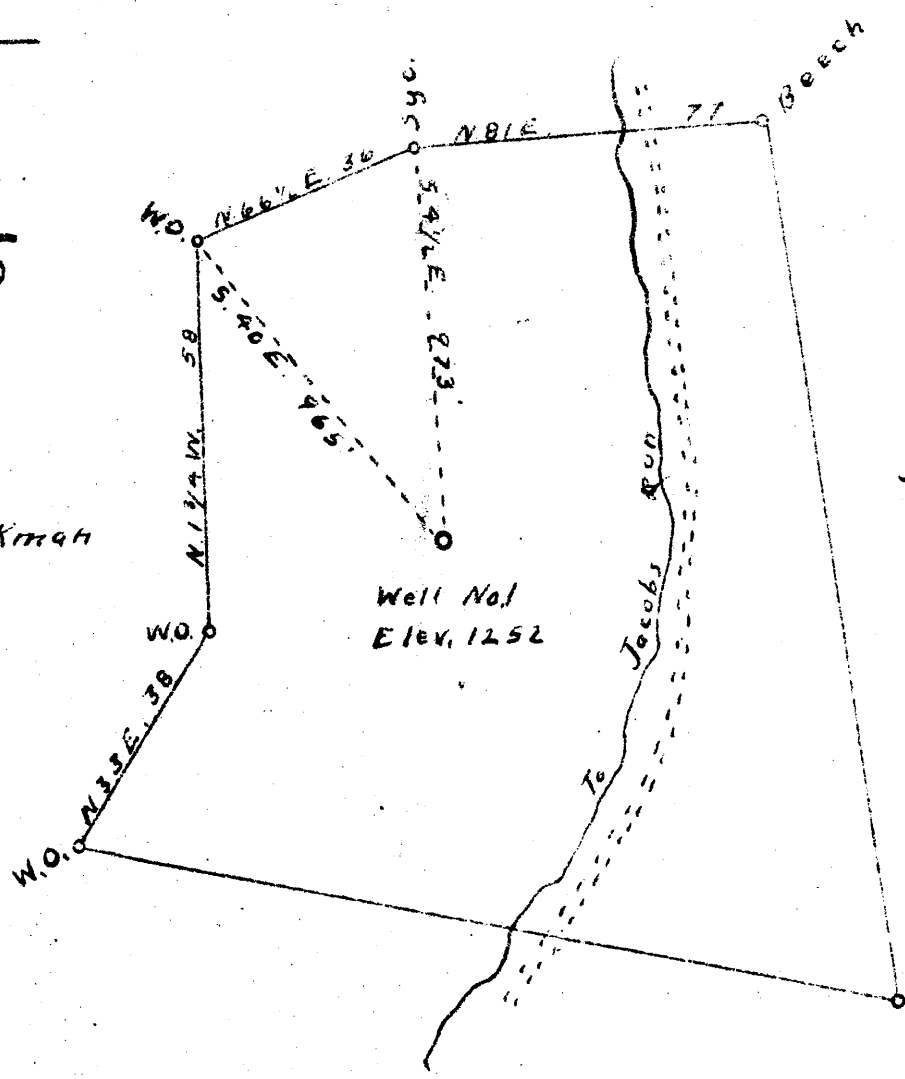

2.12S

4.12W

New Location

Drill Deeper

Abandonment

Company William Moses

Address 189 W. Main St. Salem, W. Va.

Farm W. S. Williams

Tract _____ Acres 87 Lease No. _____

Well (Farm) No. 1 Serial No. _____

Elevation (Spirit Level) 1252

Quadrangle Centerpoint

County Harrison District Ten Mile

Engineer A. K. Westfall

Engineer's Registration No. _____

File No. _____ Drawing No. _____

Date 11/2/45 Scale 1" = 30 Feet

STATE OF WEST VIRGINIA
 DEPARTMENT OF MINES
 OIL AND GAS DIVISION
 CHARLESTON

WELL LOCATION MAP
 FILE NO. HAR-241-A

+ Denotes location of well on United States Topographic Maps, scale 1 to 62,500. Latitude and longitude lines being represented by border lines as shown.

- Denotes one inch spaces on border line of original tracing.



783

STATE OF WEST VIRGINIA
DEPARTMENT OF MINES
OIL AND GAS DIVISION

WELL RECORD

Permit No. 941-A

Oil or Gas Well X
(KIND)

Company William Moses
 Address Salem, W. Va.
 Farm W. S. Williams Acres 87
 Location (waters) _____
 Well No. One Elev. 1252
 District Tennile County Harrison
 The surface of tract is owned in fee by South Penn Nat'. Gas Co.
 Address _____
 Mineral rights are owned by _____
 Address _____
 Drilling commenced _____
 Drilling completed _____
 Date Shot _____ From _____ To _____
 With _____
 Open Flow _____ /10ths Water in _____ Inch
 _____ /10ths Merc. in _____ Inch
 Volume _____ Cu. Ft.
 Rock Pressure _____ lbs. _____ hrs.
 Oil _____ bbls., 1st 24 hrs.
 Fresh water _____ feet _____ feet
 Salt water _____ feet _____ feet

Casing and Tubing	Used in Drilling	Left in Well	Packers
Size			
16			Kind of Packer
13			
8 1/4		1640	Size of
6 5/8		2560	Depth set
5 3/16		2453	
3			Perf. top
2			Perf. bottom
Liners Used			Perf. top
			Perf. bottom

CASING CEMENTED _____ SIZE _____ No. Ft. _____ Date _____
 COAL WAS ENCOUNTERED AT 1125 FEET _____ INCHES
 _____ FEET _____ INCHES FEET _____ INCHES
 _____ FEET _____ INCHES FEET _____ INCHES

Formation	Color	Hard or Soft	Top	Bottom	Oil, Gas or Water	Depth Found	Remarks
Pitts Coal			1125	1131			
Salt Sand			2000	2050			
Dunkard Sand			1640	1680			
Big Lime			2375	2435			
Big Injun			2435	2532			
Fifty Feet			2973	3010			
Stray Sand			3138	3156			
Merden Sand			3183	3193			
Total Depth			3223				

MAR 1946