

New Location
 Drill Deeper
 Abandonment 8053

Map Sh. 55 Sq. 5-16 E-9 F.B. 777 R. 16 1/2 19

Company HOPE NATURAL GAS CO.
 Address CLARKSBURG, W. VA.
 Farm JAS. P. BORING
 Tract _____ Acres 106 Lease No. 52847
 Well (Farm) No. _____ Serial No. As Shown
 Elevation (Spirit Level) As Shown
 Quadrangle WESTON
 County HARRISON District UNION
 Engineer W.M. Bowen
 Engineer's Registration No. 900
 File No. _____ Drawing No. _____
 Date FEB. 1, 1946 Scale 1" = 40'

STATE OF WEST VIRGINIA
 DEPARTMENT OF MINES
 OIL AND GAS DIVISION
 CHARLESTON

WELL LOCATION MAP
 FILE NO. HAR. 942-A

+ Denotes location of well on United States Topographic Maps scale 1 to 62,500. latitude and longitude lines being represented by border lines as shown.

- Denotes one inch spaces on border line of original tracing.



STATE OF WEST VIRGINIA
DEPARTMENT OF MINES
OIL AND GAS DIVISION

799

WELL RECORD


Permit No. 9427A Oil or Gas Well (KIND)

Company Hope Natural Gas Company.
Address 445 West Main St. Clarksburg, W. Va.
Farm Jas. P. Boring. Acres 166
Location (waters) _____
Well No. 8053 Elev. 1028
District Union County Harrison
The surface of tract is owned in fee by _____
Address _____
Mineral rights are owned by _____
Address _____
Drilling commenced May 27, 1916
Drilling completed June 29, 1916
Date Shot _____ From _____ To _____
With _____
Open Flow _____ /10ths Water in _____ Inch
_____ /10ths Merc. in _____ Inch
Volume _____ Cu. Ft.
Rock Pressure _____ lbs. _____ hrs.
Oil 425 bbls., 1st 24 hrs.
Fresh water _____ feet _____ feet
Salt water none feet _____ feet

| Casing and Tubing | Used in Drilling | Left in Well | Packers |
|-------------------|------------------|---------------|----------------|
| Size | | | Kind of Packer |
| 16 | | | |
| 13 | | | |
| 10 | 140 | Pulled | Size of |
| 8 1/4 | 975 | Pulled | |
| 6 3/8 | 1298 | 1298 | Depth set |
| 5 3/16 | | | |
| 3 | | | Perf. top |
| 2 | 2885 | 2885 | Perf. bottom |
| Liners Used | | | Perf. top |
| | | | Perf. bottom |

not cemented
CASING CEMENTED _____ SIZE _____ No. Ft. _____ Date _____
Below coal
COAL WAS ENCOUNTERED AT _____ FEET _____ INCHES
_____ FEET _____ INCHES FEET _____ INCHES
_____ FEET _____ INCHES FEET _____ INCHES

| Formation | Color | Hard or Soft | Top | Bottom | Oil, Gas or Water | Depth Found | Remarks | |
|----------------|-------|--------------|------|--------|-------------------|-------------|---------|------|
| Little Dunkard | | | 330 | 365 | water | 425 | | |
| Big Dunkard | | | 395 | 435 | | | | |
| Gas sand | | | 500 | 595 | | | | |
| First Salt | | | 665 | 710 | ⊙ | Ⓜ | | |
| Second Salt | | | 735 | 895 | | | | |
| Little Lime | | | 1190 | 1215 | | | | |
| Pencil cave | | | 1215 | 1230 | | | | |
| Big Lime | | | 1230 | 1290 | | | | |
| Big Injun | | | 1290 | 1405 | | | | |
| Squaw | | | 1420 | 1430 | | | | |
| Gantz | | | 1630 | 1651 | | | gas | 1741 |
| Fifty foot | | | 1738 | 1765 | | | | |
| Gordon | | | 2008 | 2055 | | | gas | 2152 |
| Fifth | | | 2149 | 2165 | | | | |
| Speechley | | | 2840 | 2865 | | | | |
| Total depth | | | | 2885 | gas | 2842 63 | | |

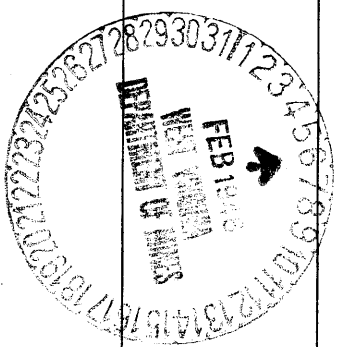

| Formation | Color | Hard or Soft | Top | Bottom | Oil, Gas or Water | Depth Found | Remarks |
|-----------|-------|--------------|-----|--------|-------------------|-------------|---------|
| | | | | | | | |

Date **February 5, 1946**, 194

APPROVED **Hope Natural Gas Company.**, Owner

By *[Signature]* **General Superintendent.**

