

2.24S
4.28W

NEW LOCATION
DRILL DEEPER
ABANDONMENT X

MAP SHEET 56 S23E15F.B. 534 P.11-12

COMPANY	HOPE NATURAL GAS CO
ADDRESS	CLARKSBURG, W. VA.
FARM	MARGARET JETT
TRACT	ACRES 12 LEASE NO 26562
WELL(FARM) NO	SERIAL NO 3603
ELEVATION (SPIRIT LEVEL)	1063
QUADRANGLE	WESTON
COUNTY	HAPLISON DISTRICT GEANT
ENGINEER	W. M. LOWERS
ENGINEER'S REGISTRATION NO	900
FILE NO	DRAWING NO
DATE	3-5-46 SCALE 1" - 200'

STATE OF WEST VIRGINIA
DEPARTMENT OF MINES
OIL AND GAS DIVISION
CHARLESTON

WELL LOCATION MAP

FILE NO, HAR - 959 - A

+ DENOTES LOCATION OF WELL ON UNITED STATES TOPOGRAPHIC MAPS, SCALE 1 TO 62,500, LATITUDE AND LONGITUDE LINES BEING REPRESENTED BY BORDER LINES AS SHOWN.

- DENOTES ONE INCH SPACES ON BORDER LINE OF ORIGINAL TRACING.



STATE OF WEST VIRGINIA
DEPARTMENT OF MINES
OIL AND GAS DIVISION

809

WELL RECORD

Permit No. 959-A


Oil or Gas Well Gas
(KIND)

Company Hope Natural Gas Company
 Address 445 W. Main St. Clarksburg, W. Va.
 Farm Margaret D. Jett Acres 12
 Location (waters) _____
 Well No. 3603 Elev. 1063
 District Grant County Harrison
 The surface of tract is owned in fee by Aubrey Randolph
 Address Lost Creek, W.Va. R2
 Mineral rights are owned by _____
 Address _____
 Drilling commenced Purchased well 7/8/1914
 Drilling completed _____
 Date Shot _____ From _____ To _____
 With _____
 Open Flow _____ /10ths Water in _____ Inch
 _____ /10ths Merc. in _____ Inch
 Volume _____ Cu. Ft.
 Rock Pressure _____ lbs. _____ hrs.
 Oil _____ bbls., 1st 24 hrs.
 Fresh water No record feet _____ feet
 Salt water No record feet _____ feet

Casing and Tubing	Used in Drilling	Left in Well	Packers
Size			
16			Kind of Packer _____
13			
10			Size of _____
8 1/4	<u>String</u>	<u>?</u>	
6 3/4	<u>1209 ?</u>	<u>1209 2</u>	Depth set _____
5 3/16			
3		<u>2083</u>	Perf. top _____
2			Perf. bottom _____
Liners Used			Perf. top _____
			Perf. bottom _____

CASING CEMENTED _____ SIZE _____ No. Ft. _____ Date _____
Not cemented
 COAL WAS ENCOUNTERED AT 105 FEET 60 INCHES
 _____ FEET _____ INCHES FEET _____ INCHES
 _____ FEET _____ INCHES FEET _____ INCHES

Formation	Color	Hard or Soft	Top	Bottom	Oil, Gas or Water	Depth Found	Remarks
<u>ESTIMATED RECORD COMPILED FROM LOG OF ADJACENT WELLS.</u>							
Coal			105	110			
Little Dunkard			110	120			
Big Dunkard			240	285			
Gas Sand			365	395			
First Salt			470	522 575			
Second Salt			630	795			
Little Lime			1052	1095			
Big Lime			1113	1175			
Big Injun			1175	1300			
Squaw			1350	1355			
Berea			1390	1435			
Gantz			1490	1560			
Fifty Foot			1580	1655			
Thirty Foot			1580 1690	1744			
Red Rock			1744	1876			
Gordon			1875	1892			
Fourth			1897	1932			
Fifth			2015	2036	Gas	2017-2033	
Total depth				2067			

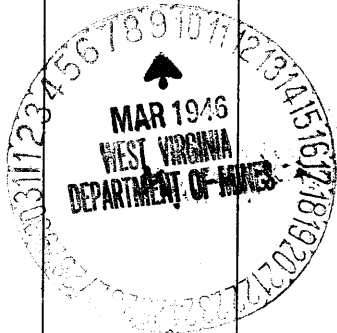

Formation	Color	Hard or Soft	Top	Bottom	Oil, Gas or Water	Depth Found	Remarks

Date March 6, 1946

APPROVED Hope Natural Gas Company, Owner

By J. A. Clark Gen. Supt.

Guy L. Ashby (Title)

