

NEW LOCATION  
 DRILL DEEPER  
 ABANDONMENT X

MAP 44 SQUAFES S14 E12 FB 633 P 36

COMPANY HOPE NATURAL GAS CO.  
 ADDRESS CLARKSBURG, W. VA.  
 FARM J. M. RECTOR  
 TRACT ACRES 145 LEASE NO. 52681  
 WELL (FARM) NO.                      SERIAL NO 7937  
 ELEVATION (SPIRIT LEVEL) 1117  
 QUADRANGLE CLARKSBURG  
 COUNTY HARRISON DISTRICT CLARK  
 ENGINEER W. M. LOWERS  
 ENGINEER'S REGISTRATION NO 900  
 FILE NO                      DRAWING NO                       
 DATE 3/14/46 SCALE 1" = 40 P

STATE OF WEST VIRGINIA  
 DEPARTMENT OF MINES  
 OIL AND GAS DIVISION  
 CHARLESTON

WELL LOCATION MAP  
 FILE NO. HAR 963-A

\* DENOTES LOCATION OF WELL ON UNITED STATES TOPOGRAPHIC MAPS, SCALE 1 TO 62,500, LATITUDE AND LONGITUDE LINES BEING REPRESENTED BY BORDER LINES AS SHOWN.

+ DENOTES ONE INCH SPACES ON BORDER LINE OF ORIGINAL TRACING.



STATE OF WEST VIRGINIA  
DEPARTMENT OF MINES  
OIL AND GAS DIVISION

792

WELL RECORD


Permit No. 963-A Oil or Gas Well Oil (KIND)

Company Hope Natural Gas Company.  
Address 445 West Main St. Clarksburg, W. Va.  
Farm J.N. Rector Acres 145  
Location (waters) \_\_\_\_\_  
Well No. 7937 Elev. 1117  
District Clark County Harrison  
The surface of tract is owned in fee by \_\_\_\_\_  
Address \_\_\_\_\_  
Mineral rights are owned by \_\_\_\_\_  
Address \_\_\_\_\_  
Drilling commenced June 7, 1917  
Drilling completed July 24, 1917  
Date Shot \_\_\_\_\_ From \_\_\_\_\_ To \_\_\_\_\_  
With \_\_\_\_\_  
Open Flow \_\_\_\_\_ /10ths Water in \_\_\_\_\_ Inch  
\_\_\_\_\_ /10ths Merc. in \_\_\_\_\_ Inch  
Volume \_\_\_\_\_ Cu. Ft.  
Rock Pressure \_\_\_\_\_ lbs. \_\_\_\_\_ hrs.  
Oil \_\_\_\_\_ bbls., 1st 24 hrs.  
Fresh water none feet \_\_\_\_\_ feet  
Salt water none feet \_\_\_\_\_ feet

Casing and Tubing	Used in Drilling	Left in Well	Packers
Size			
16			Kind of Packer
13			
10	<b>155</b>	<b>Pulled</b>	Size of
8 1/4			
6 5/8	<b>1396</b>	<b>1396</b>	Depth set
5 3/16	<b>2053</b>	<b>2053</b>	
3			Perf. top
2	<b>3009</b>	<b>3009</b>	Perf. bottom
Liners Used			Perf. top
			Perf. bottom

CASING CEMENTED not cemented No. Ft. \_\_\_\_\_ Date \_\_\_\_\_  
COAL WAS ENCOUNTERED AT Below coal FEET \_\_\_\_\_ INCHES  
FEET \_\_\_\_\_ INCHES FEET \_\_\_\_\_ INCHES  
FEET \_\_\_\_\_ INCHES FEET \_\_\_\_\_ INCHES

Formation	Color	Hard or Soft	Top	Bottom	Oil, Gas or Water	Depth Found	Remarks
Little Dunkard			340	353			
Big Dunkard			440	490			
Gas sand			605	645			
First Salt			785	836			
Second Salt			855	915			
Maxon			1195	1255			
Little Lime			1296	1310			
Pencil cave			1330	1336			
Big Lime			1336	1382			
Big Injun			1382	1515			
Squaw			1522	1555			
Gantz			1785	1820			
Fifty foot			1848	1960	gas	1890	
Thirty foot			1968	1985			
Gordon stray			2055	2110			
Gordon			2123	2191			
Fourth			2216	2236			
Fifth			2283	2299	gas	2285	
Speechley			2986	2996	gas	(2888) 2988	
Total depth				3007			

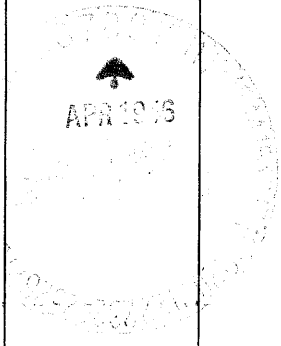

Formation	Color	Hard or Soft	Top	Bottom	Oil, Gas or Water	Depth Found	Remarks

Date March 14, 1946, 194

APPROVED Hope Natural Gas Company., Owner

By JMY General Superintendent.

