

C.N. Martin
66 1/2 a

Wm. Hawker
61 7/8 a


A.A. Sommerville
35 a

Butternut Pointers

Felix Reed
11 a

A.J. Lannam
18 a

E. B. Maxwell
15 a

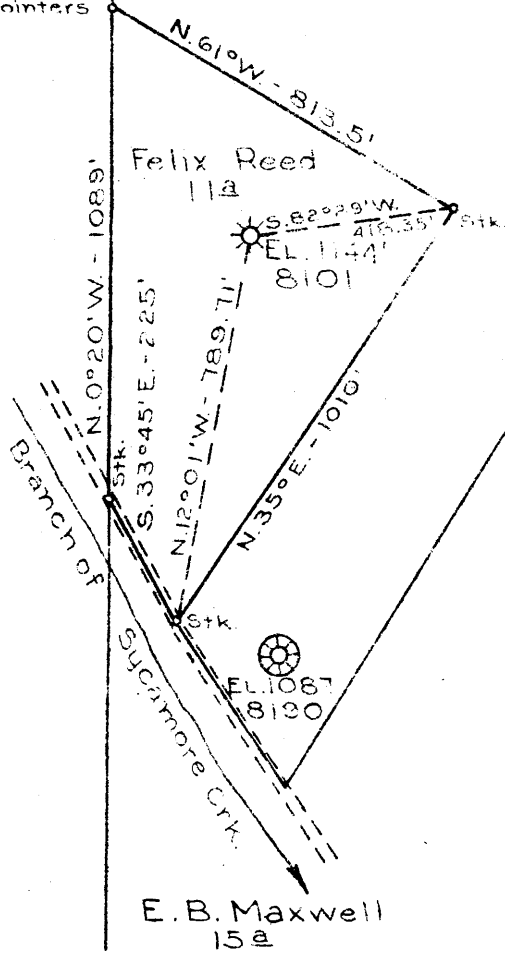

G.285
1.15 W

New Location
Drill Deeper
Abandonment X Partial

Company HOPE NATURAL GAS CO.
Address CLARKSBURG, W.VA.
Farm FELIX REED
Tract _____ Acres 11 Lease No. 52830
Well (Farm) No. _____ Serial No. 8101
Elevation (Spirit Level) 1144
Quadrangle WESTON
County HARRISON District UNION
Engineer *W.M. Bowers*
Engineer's Registration No. 900
File No. _____ Drawing No. _____
Date JUNE 4, 1946 Scale 1"=400'

STATE OF WEST VIRGINIA
DEPARTMENT OF MINES
OIL AND GAS DIVISION
CHARLESTON

WELL LOCATION MAP
FILE NO HAR-1000-A

+ Denotes location of well on United States Topographic Maps, scale 1 to 62,500, latitude and longitude lines being represented by border lines as shown.

- Denotes one inch spaces on border line of original tracing.



863

STATE OF WEST VIRGINIA
DEPARTMENT OF MINES
OIL AND GAS DIVISION

WELL RECORD

Permit No. 1000-A Oil or Gas Well _____ (KIND)


Company Hope Natural Gas Company.
Address 445 West Main St. Clarksburg, W. Va.
Farm Felix Reed Acres 11
Location (waters) _____
Well No. 8101 Elev. 1144
District Union County Harrison
The surface of tract is owned in fee by _____
Address _____
Mineral rights are owned by _____
Address _____
Drilling commenced April 7, 1912
Drilling completed May 11, 1912
Date Shot _____ From _____ To _____
With _____
Open Flow _____ /10ths Water in _____ Inch
_____ /10ths Merc. in _____ Inch
Volume _____ Cu. Ft.
Rock Pressure _____ lbs. _____ hrs.
Oil _____ bbls., 1st 24 hrs.
Fresh water none recorded feet _____ feet
Salt water none recorded feet _____ feet

Casing and Tubing	Used in Drilling	Left in Well	Packers
Size			
16			Kind of Packer
13			
10	160	Pulled	Size of
8 1/4	927	Pulled	
6 5/8	1395	1395	Depth set
5 3/16	1968	1968	
3			Perf. top
2			Perf. bottom
Liners Used			Perf. top
			Perf. bottom

CASING CEMENTED **NOT** SIZE _____ No. Ft. _____ Date _____
COAL WAS ENCOUNTERED AT **none recorded** FEET _____ INCHES
_____ FEET _____ INCHES FEET _____ INCHES
_____ FEET _____ INCHES FEET _____ INCHES

Formation	Color	Hard or Soft	Top	Bottom	Oil, Gas or Water	Depth Found	Remarks
Little Dunkard			360	390			
Big Dunkard			405	445			
Gas sand			575	680			
First Salt			705	800			
Second Salt			840	920			
Maxon			1086	1116			
Little Lime			1280	1300			
Pencil cave			1300	1310			
Big Lime			1310	1378			
Big Injun			1378	1490	gas	1380	
Squaw			1540	1570			
Fifty foot			1860	1915			
Thirty foot			1932	1950	gas	1935	
Gordon stray			2025	2060			
Gordon			2070	2095			
Fourth			2197	2208			
Fifth			2255	2269	gas	2257- 2264	
Speechley			2953	2962	gas	2956 2960	
Total depth				2975			

TO BE PARTIALLY ABANDONED.

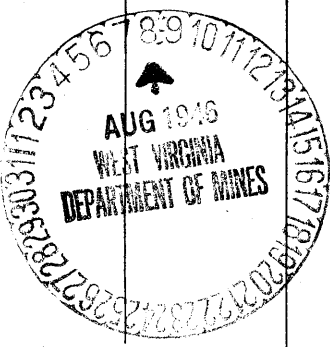

Formation	Color	Hard or Soft	Top	Bottom	Oil, Gas or Water	Depth Found	Remarks

Date August 7, 1946., 194

APPROVED Hope Natural Gas Company., Owner

By J. A. Clark
General Superintendent.